



PARENT PARCEL: 04-00-011-102-011

CHILD PARCEL: N/A

MAP CORRECTION ONLY

22-04943-C

STARTING POINT: MAG NAIL @ C/LS OF CENTENNIAL AVE & HAYES ST

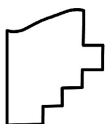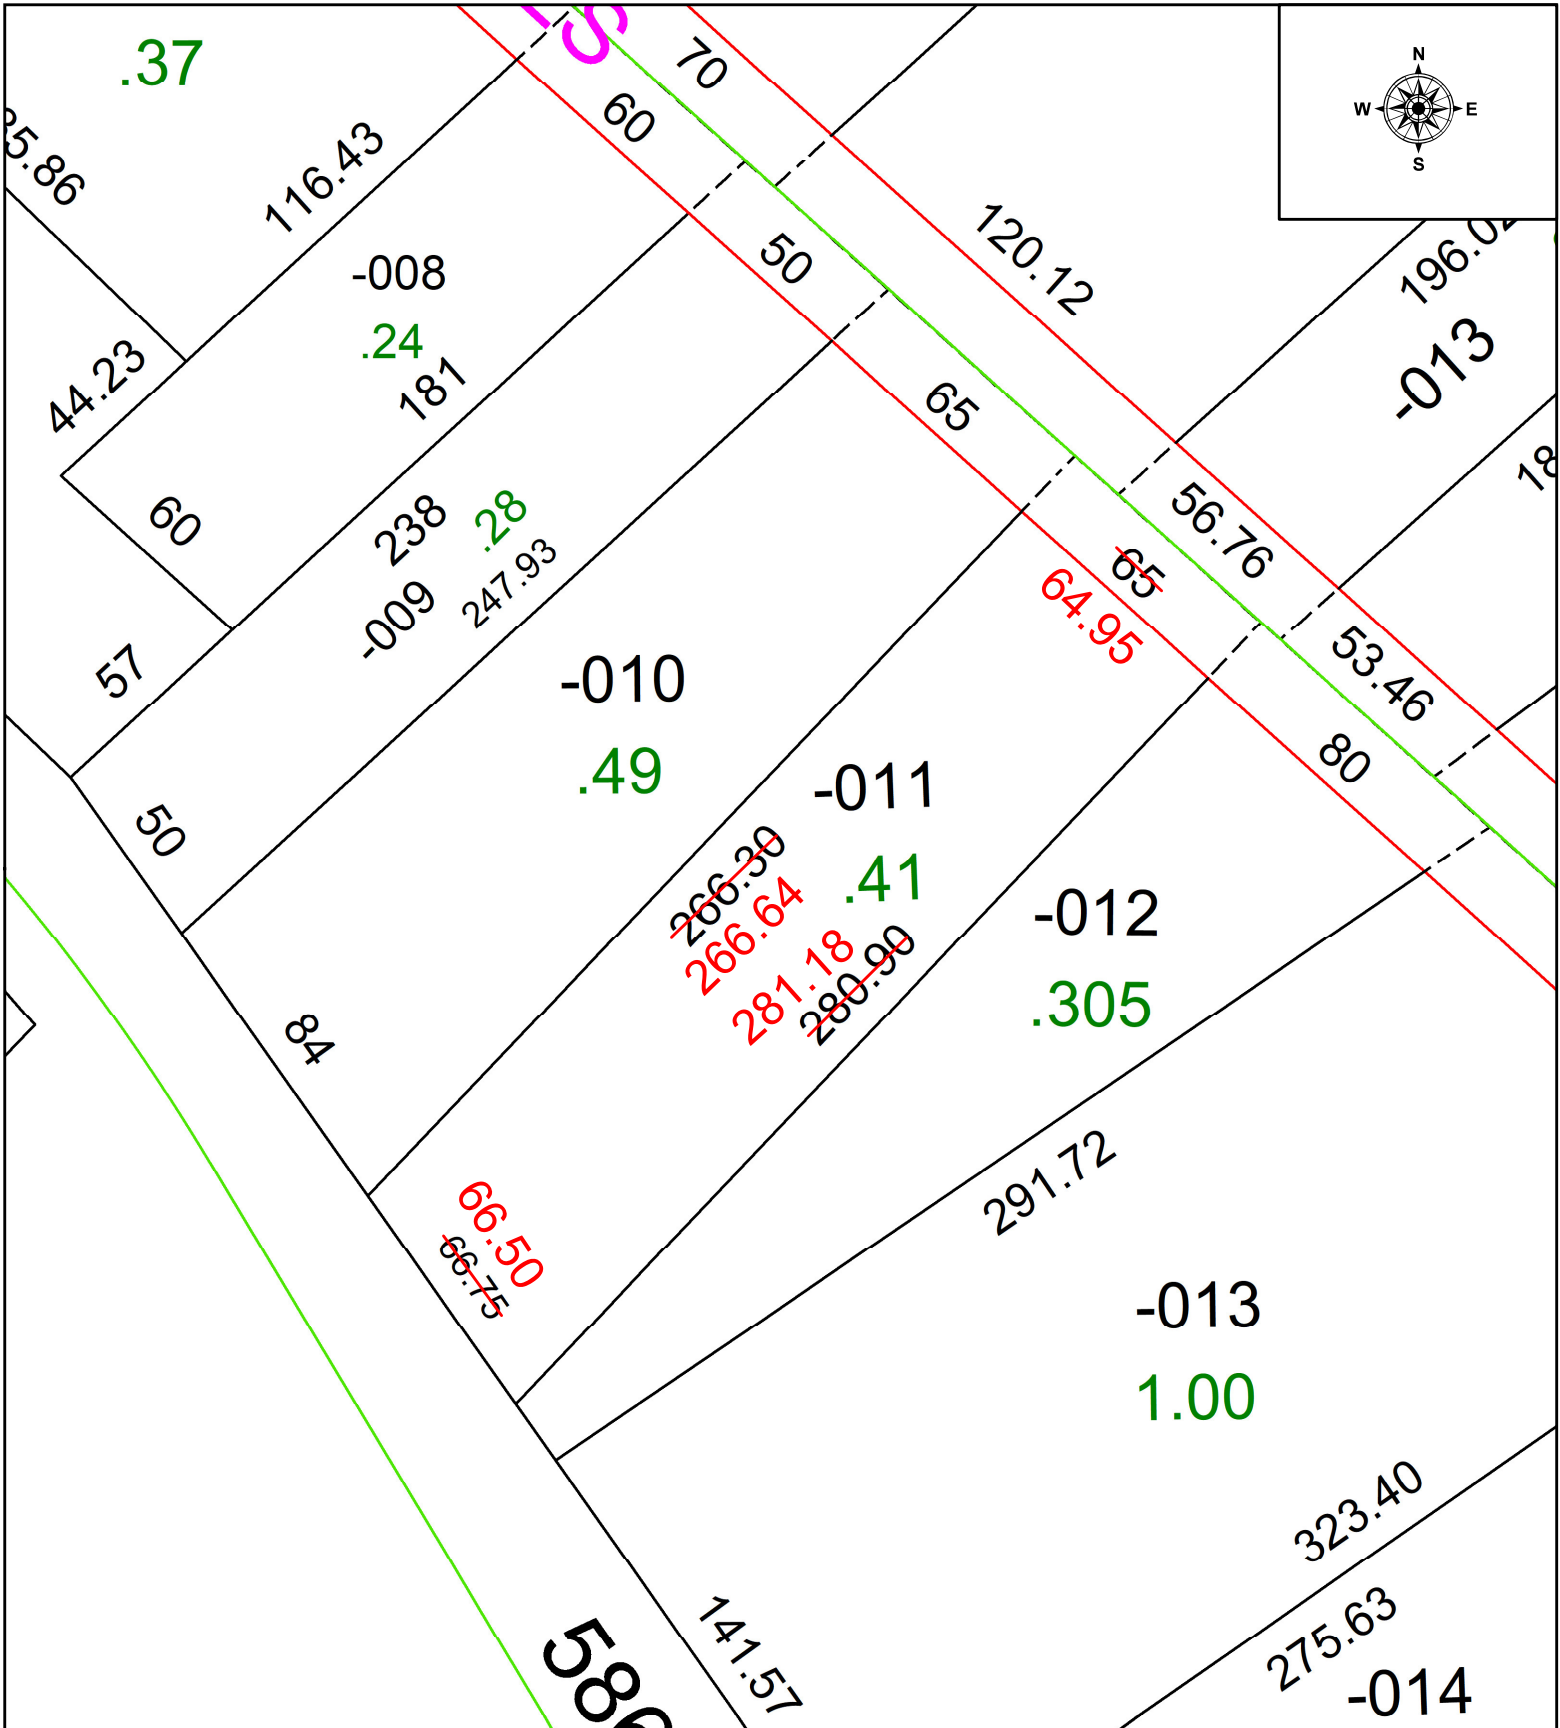

SPLITS/DEEDS PROCESSED
 LORAIN COUNTY TAX MAP DEPARTMENT
 226 MIDDLE AVE. ELYRIA, OH

SURVEYED BY:	SCOTT CASEY	SURVEY # 50685
CLOSURE:	1: 345995	
MAP PAGE(S):	04-00-011	
APPROVED BY:	WRZ	DATE: 9/2/2022
SCALE:	1" = 50	PRIOR INSTRUMENT: 2019-0730912