
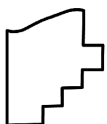
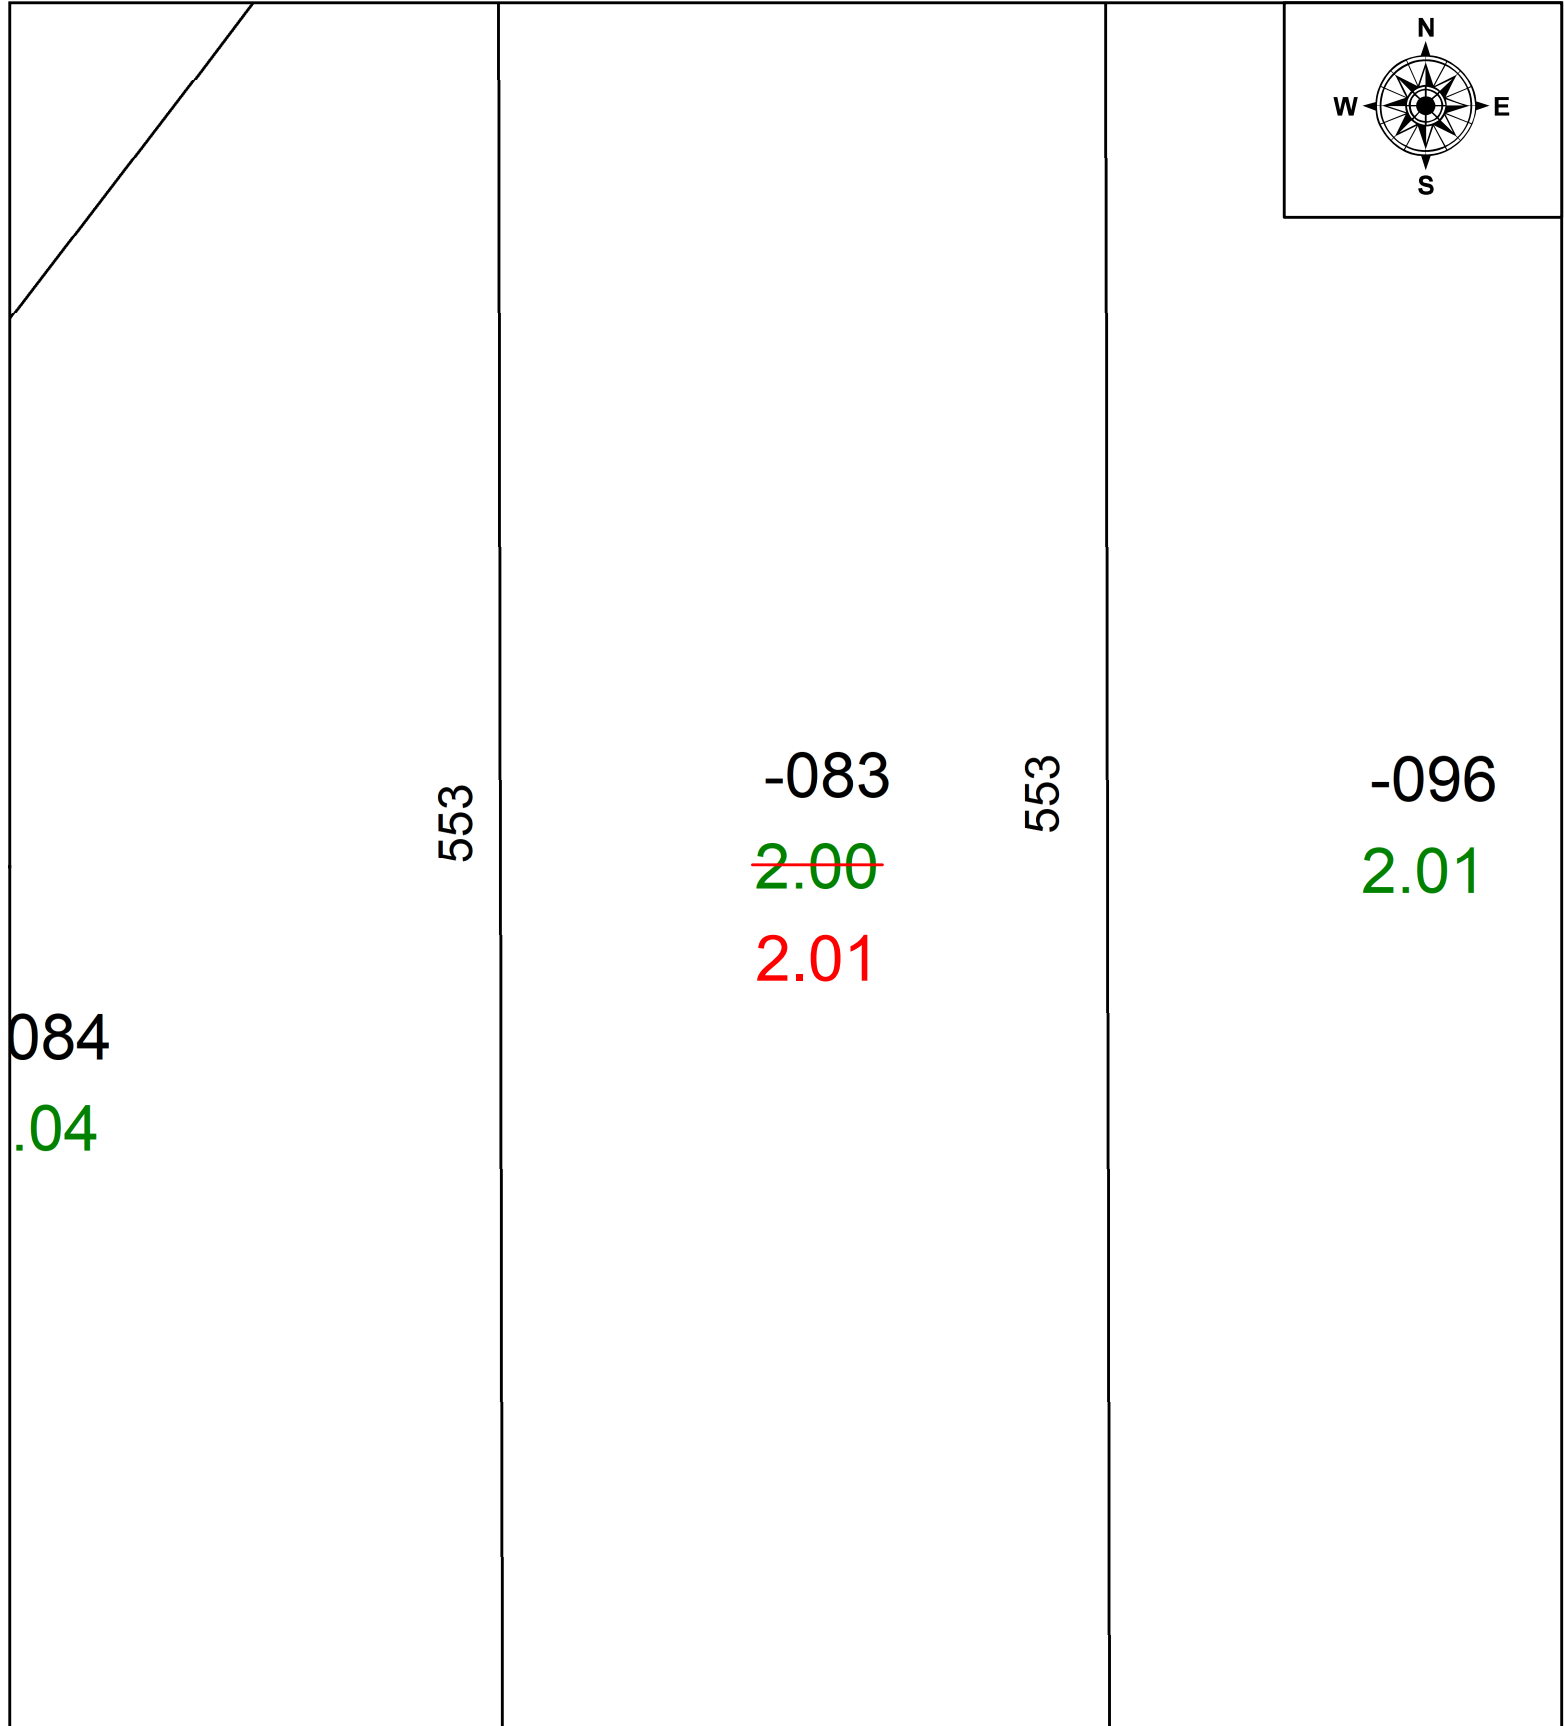


PARENT PARCEL: 10-00-001-101-083

CHILD PARCEL: **AC CORR PER PRIOR DEED INSTRUMENT NO. 2013- 0460702**

STARTING POINT: C/L OF RUSSIA RD AND W RIDGE RD

22-04951-A

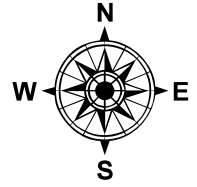

SPLITS/DEEDS PROCESSED
LORAIN COUNTY TAX MAP DEPARTMENT
226 MIDDLE AVE. ELYRIA, OH

SURVEYED BY: _____ N/A SURV # N/A
CLOSURE: _____ N/A
MAP PAGE(S): _____ 10-00-001
APPROVED BY: _____ AC DATE: September 16, 2022
SCALE: _____ 1 in = 50 ft PRIOR INSTRUMENT: _____ 2013- 0460702