
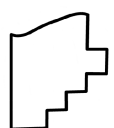


PARENT PARCEL: 07-00-039-000-089

CHILD PARCEL: 07-00-039-000-096 thru 098 & 07-00-046-108-065

STARTING POINT: C/L OF CENTER RIDGE RD & RACE RD.

25-04954

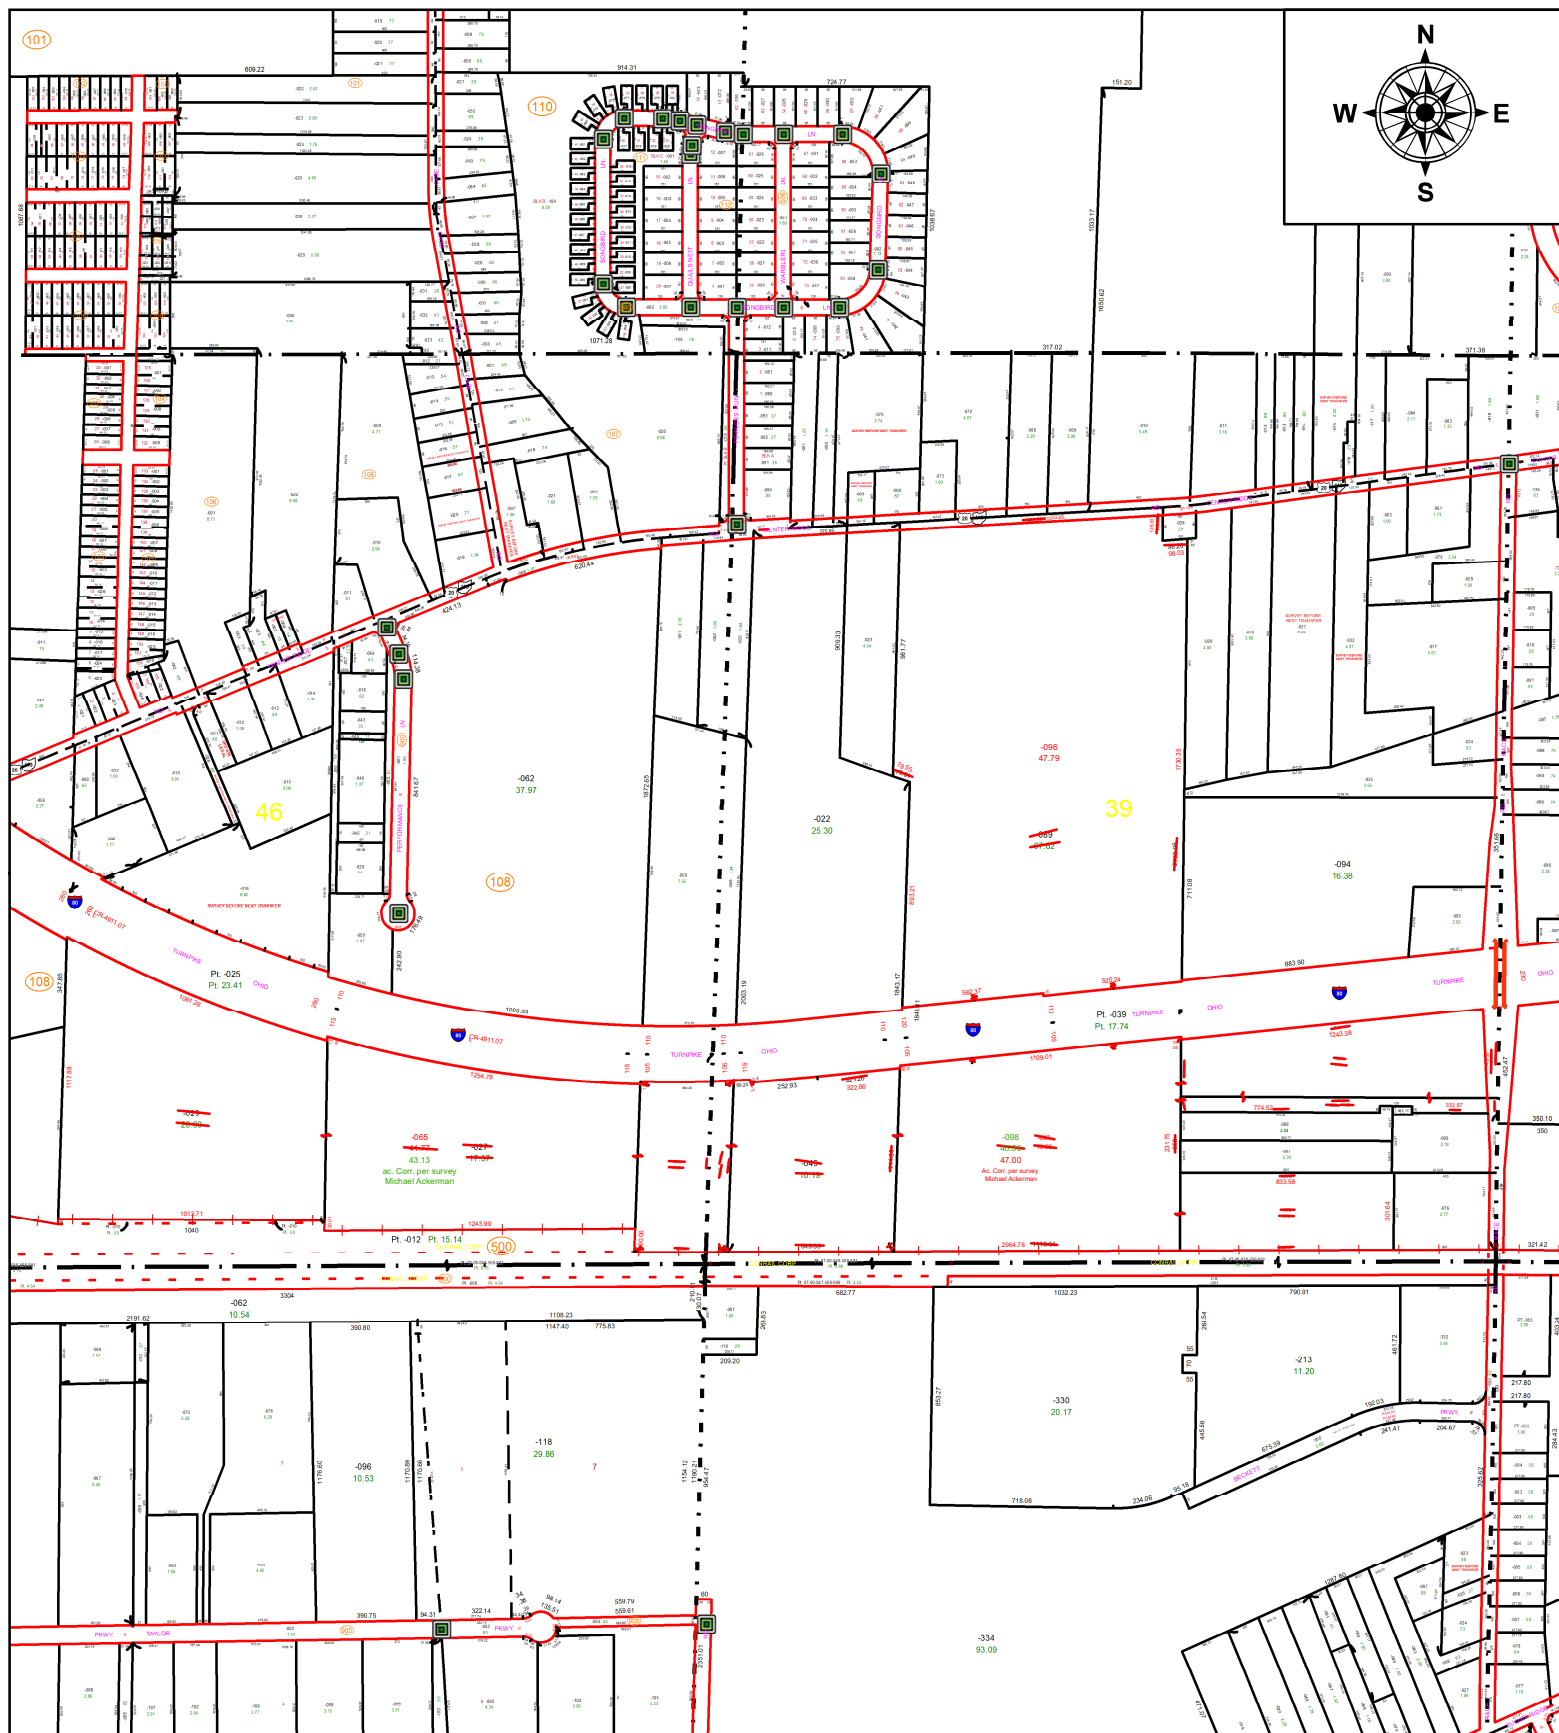

SPLITS/DEEDS PROCESSED
 LORAIN COUNTY TAX MAP DEPARTMENT
 226 MIDDLE AVE. ELYRIA, OH

SURVEYED BY: MICHAELA A. ACKERMAN
CLOSURE: 1:858544
MAP PAGE(S): 07-00-039
APPROVED BY: DMA **DATE:** 1/3/2025
SCALE: 1" = 750' **PRIOR INSTRUMENT:** 2012-0413716

SURVEY #: 51358