
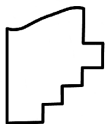


PARENT PARCEL: 03-00-045-102-053 & -107

CHILD PARCEL: 03-00-045-102-111

STARTING POINT: FRONT & DEPTH TO AC CORR PER SURV BY SCOTT A. LANDGRAF

25-04956

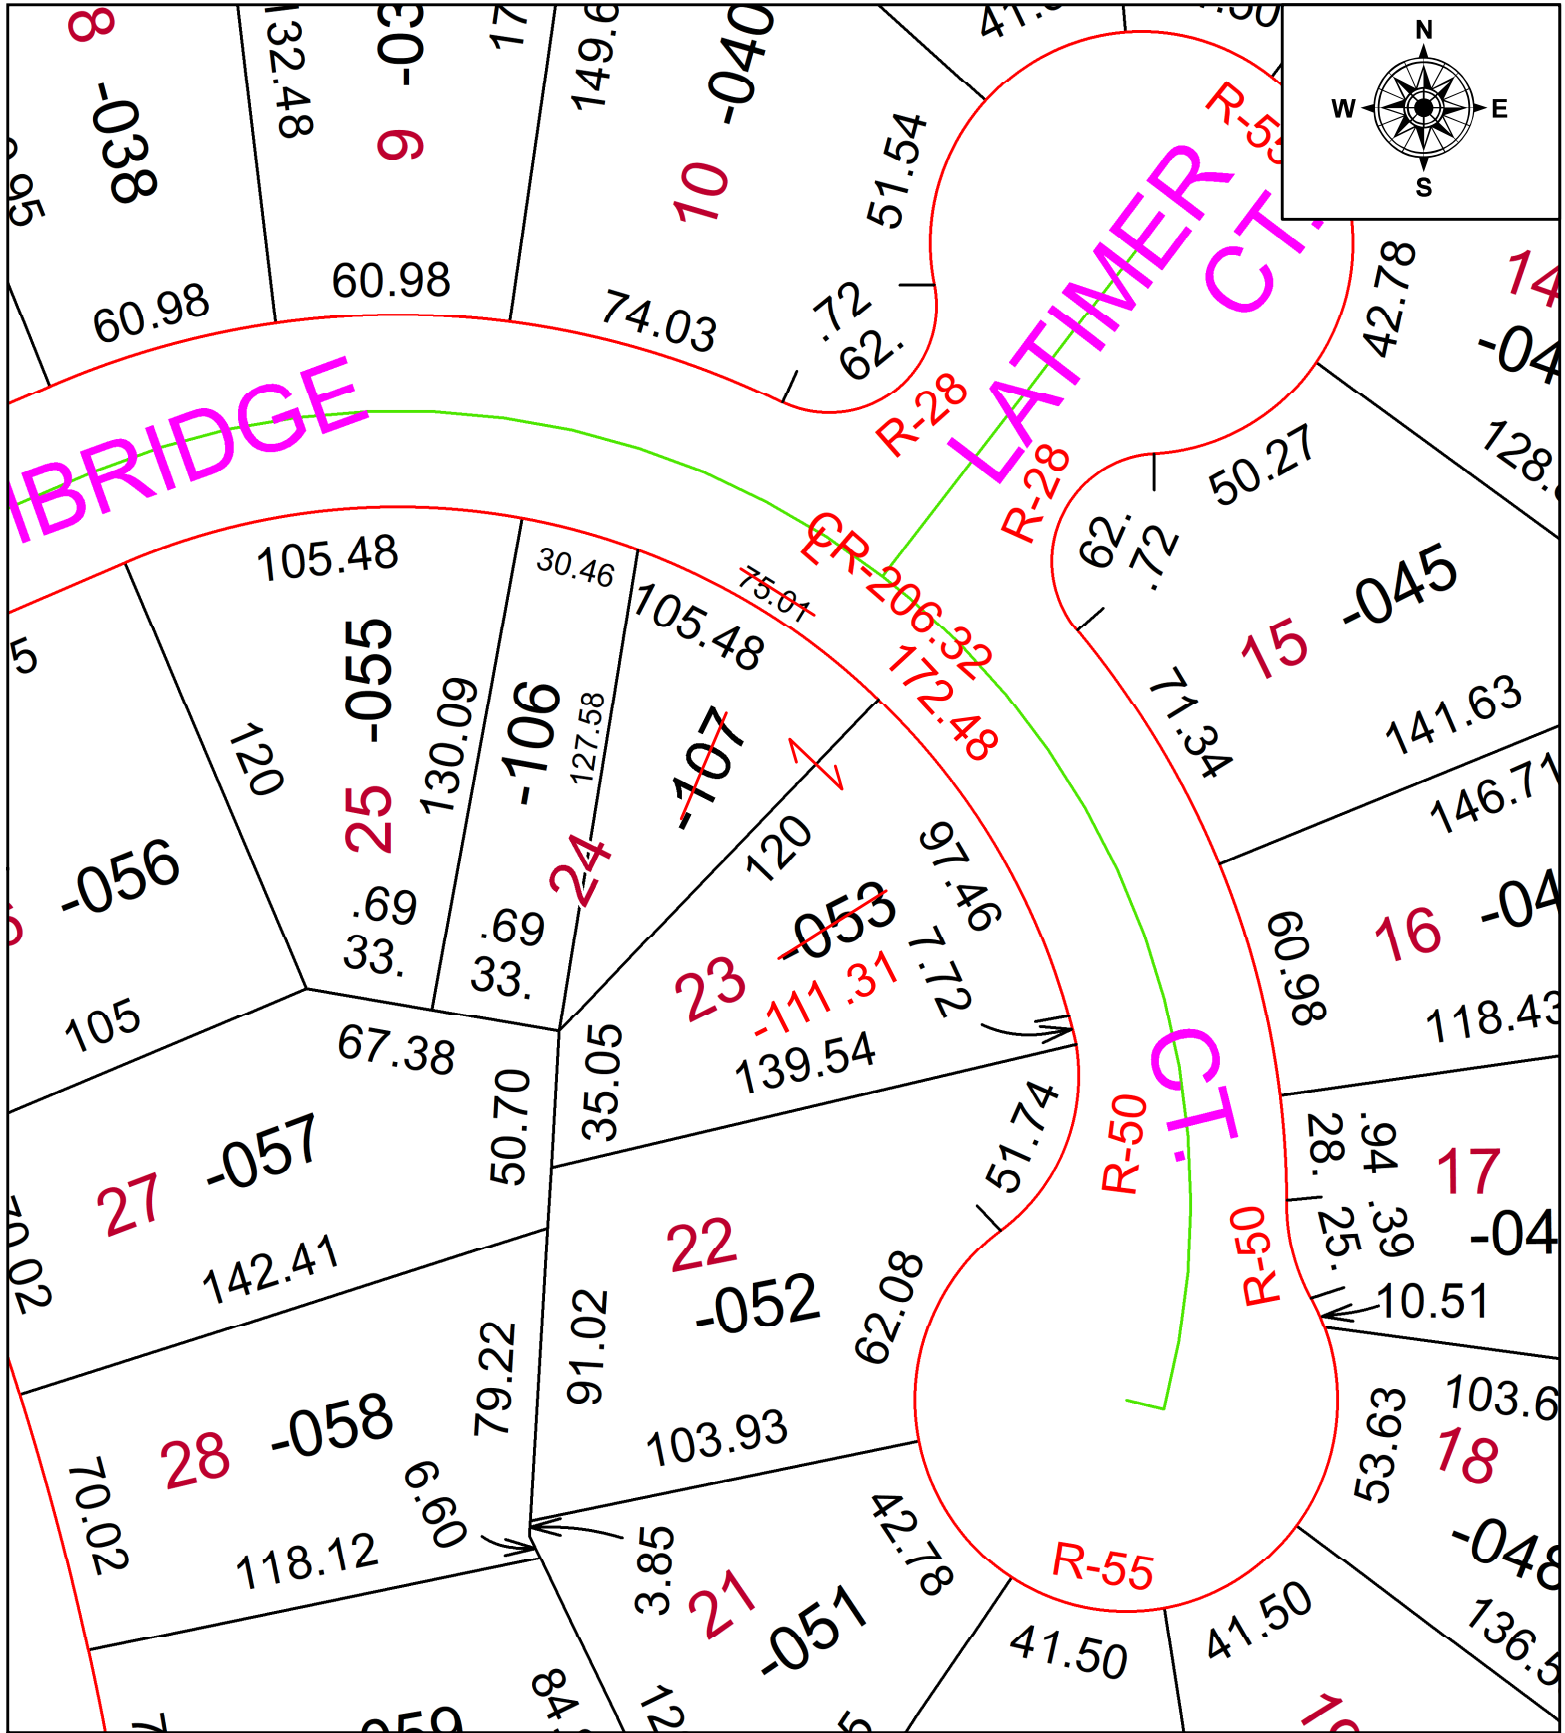

**SPLITS/DEEDS PROCESSED**  
 LORAIN COUNTY TAX MAP DEPARTMENT  
 226 MIDDLE AVE. ELYRIA, OH

SURVEYED BY: SCOTT A. LANDGRAF SURV # 51363  
 CLOSURE: 1: 42778  
 MAP PAGE(S): 03-00-045  
 APPROVED BY: AC DATE: January 08, 2025  
 SCALE: 1 in = 50 ft PRIOR INSTRUMENT: 2023- 0921345