


PARENT PARCEL: 02-01-003-115-001, -002, -005, 02-01-003-117-002, -02-00-051-139-016, & -017

CHILD PARCEL: N/A ACREAGE CORRECTION PER SURVEYOR JOHN DECHANT JR.

22-04957-A

STARTING POINT: NORTHERLY ROW OF G ST. @ SOUTHWESTERLY CORNER OF S/L 1 W.B. THOMPSON TRUSTEE ADDITION

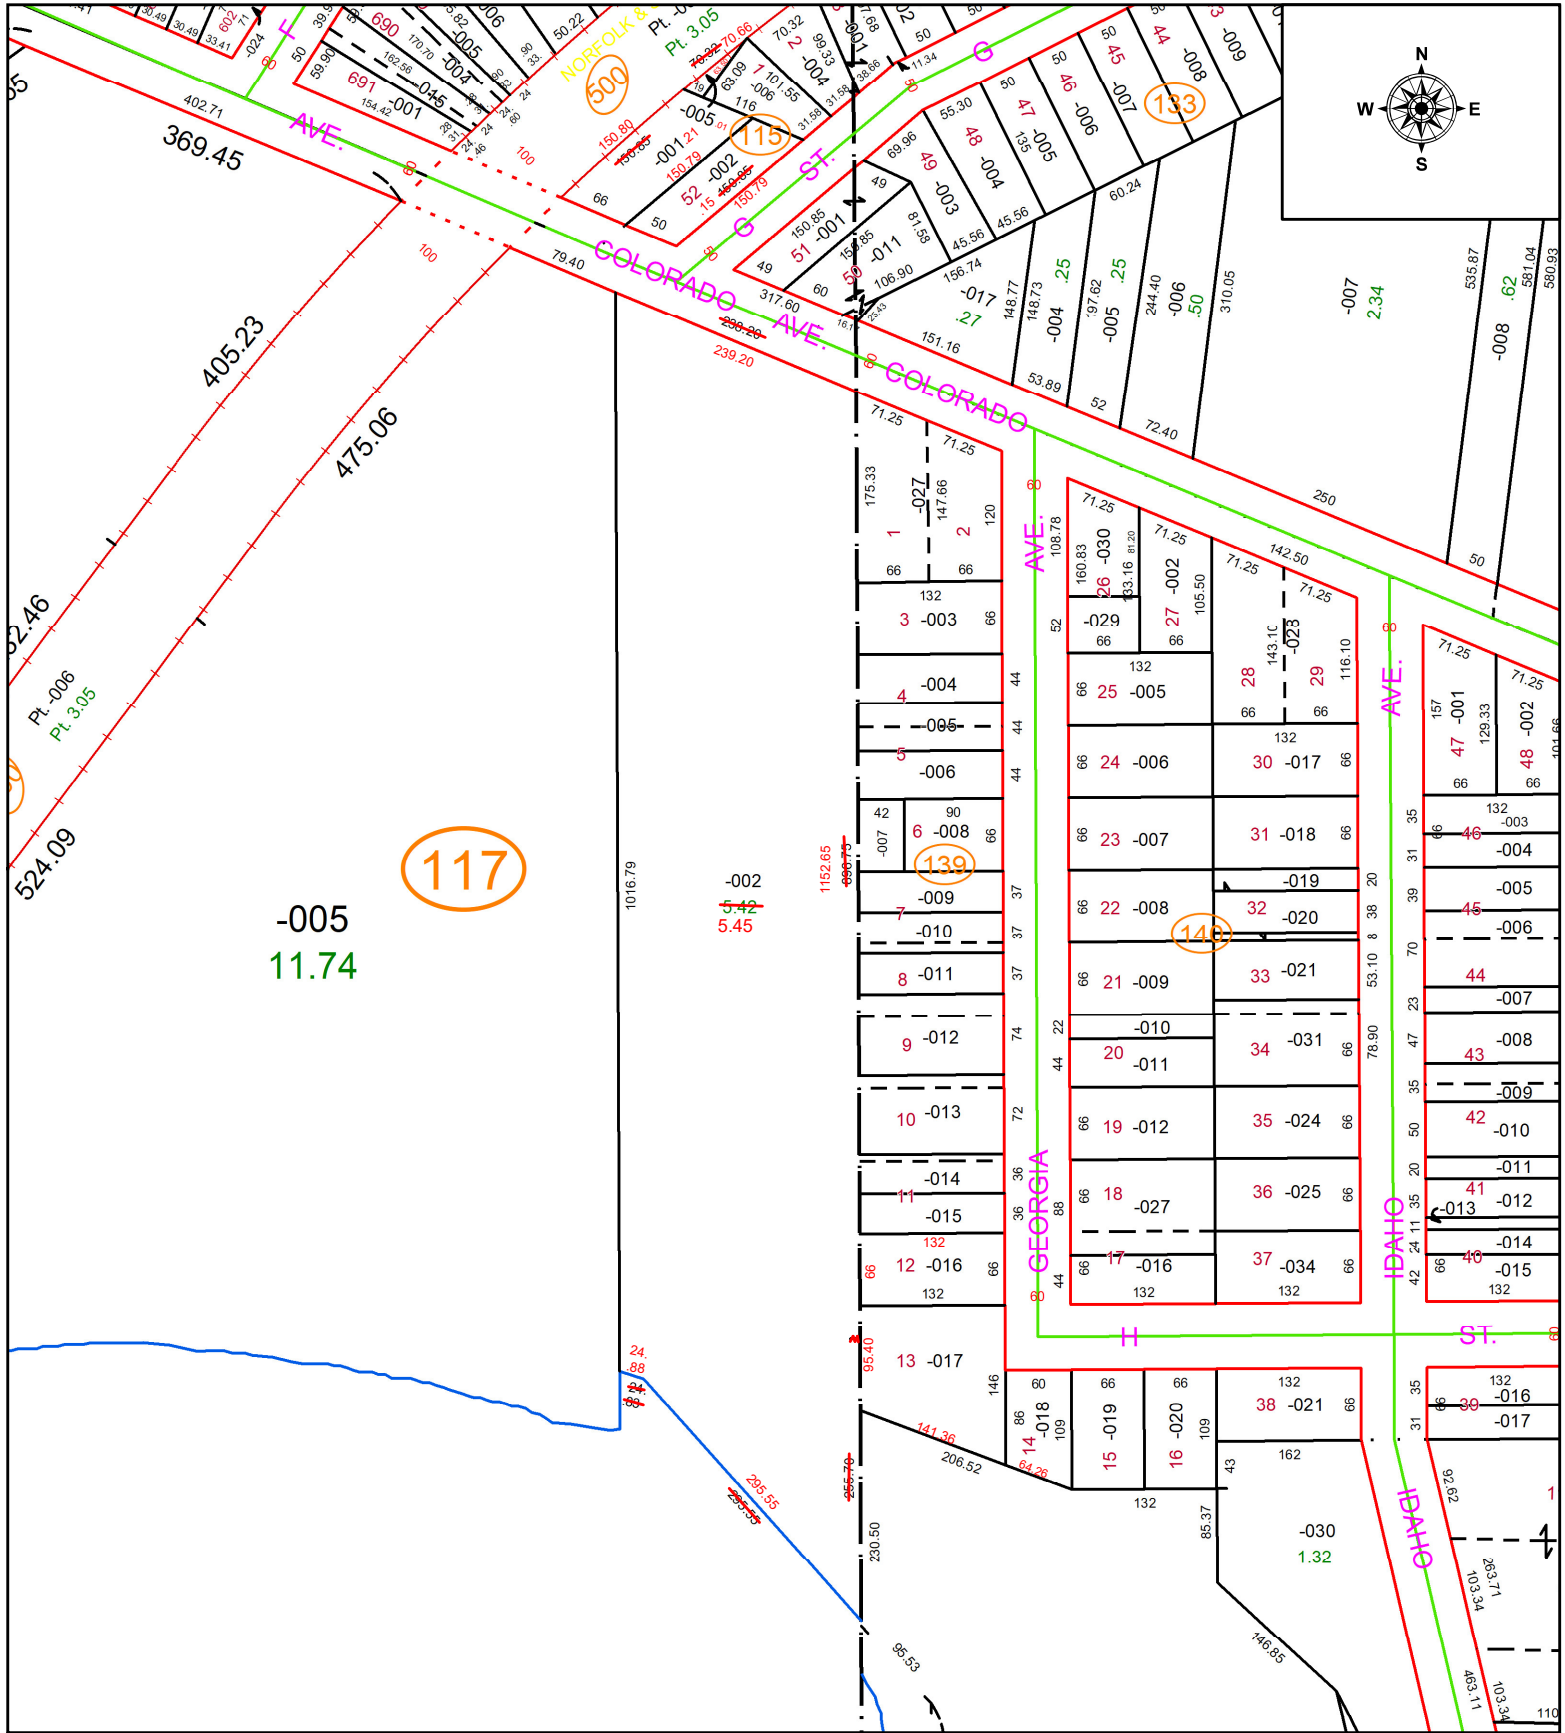


117

-005  
11.74

139

148

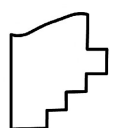

**SPLITS/DEEDS PROCESSED**  
LORAIN COUNTY TAX MAP DEPARTMENT  
226 MIDDLE AVE. ELYRIA, OH

SURVEYED BY: JOHN DECHANT JR. SURVEY # 50696  
 CLOSURE: 1: 42990  
 MAP PAGE(S): 02-01-003 & 02-00-051  
 APPROVED BY: WRZ DATE: 9/27/2022  
 SCALE: 1" = 175 PRIOR INSTRUMENT: #1980-0052826