
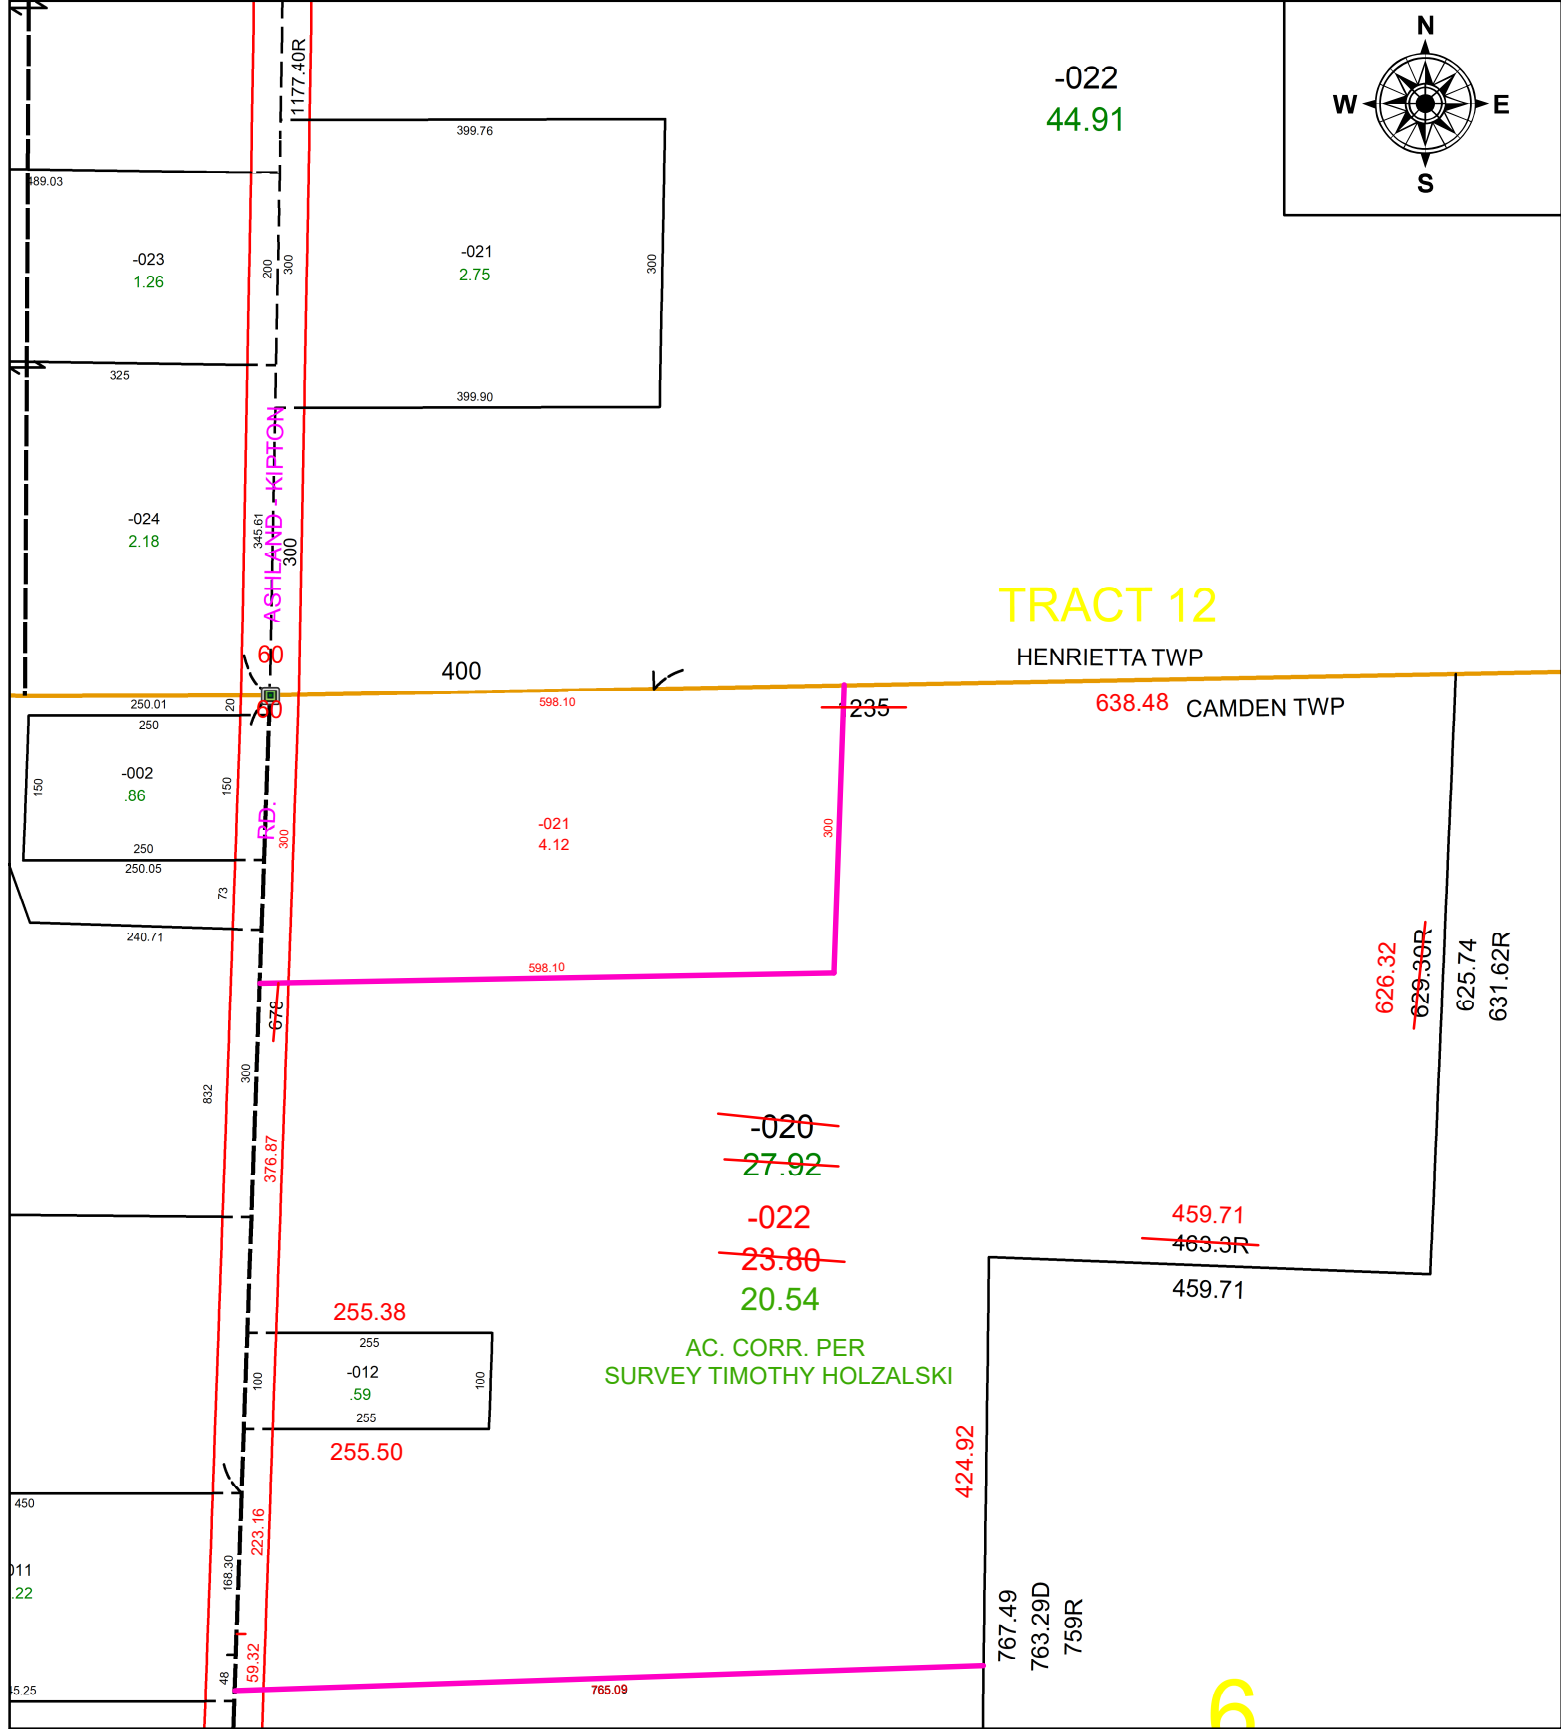


PARENT PARCEL: 13-11-006-000-020

CHILD PARCEL: 13-11-006-000-021 & -022

STARTING POINT: C/L OF U.S. ROUTE 20 & S.R. 511

25-04960

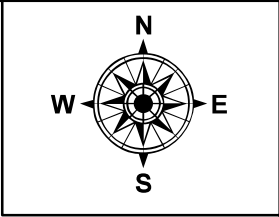

-022
44.91

-023
1.26

-021
2.75

-024
2.18

TRACT 12

HENRIETTA TWP

CAMDEN TWP

-002
.86

-021
4.12

~~-020~~

~~27.92~~

-022

~~23.80~~

20.54

AC. CORR. PER
SURVEY TIMOTHY HOZALSKI

255.38

255.50

-012
.59

459.71

~~463.3R~~

459.71

626.32

~~629.30R~~


625.74

631.62R

424.92

767.49
763.29D
759R

6

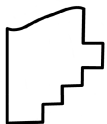

SPLITS/DEEDS PROCESSED
LORAIN COUNTY TAX MAP DEPARTMENT
226 MIDDLE AVE. ELYRIA, OH

SURVEYED BY: TIMOTHY HOZALSKI SURVEY #: 51370
CLOSURE: 1:-2147483648
MAP PAGE(S): 13-11-006
APPROVED BY: DMA DATE: 1/17/2025
SCALE: 1" = 200' PRIOR INSTRUMENT: 2023-0918023