


PARENT PARCEL: 10-00-006-107-008

CHILD PARCEL: **AC. CORR. PER SURVEY ANDREW PLANET**

STARTING POINT: CL OF EAST RIVER RD. & EASTERN LNE SECTION 6

22-04962-A

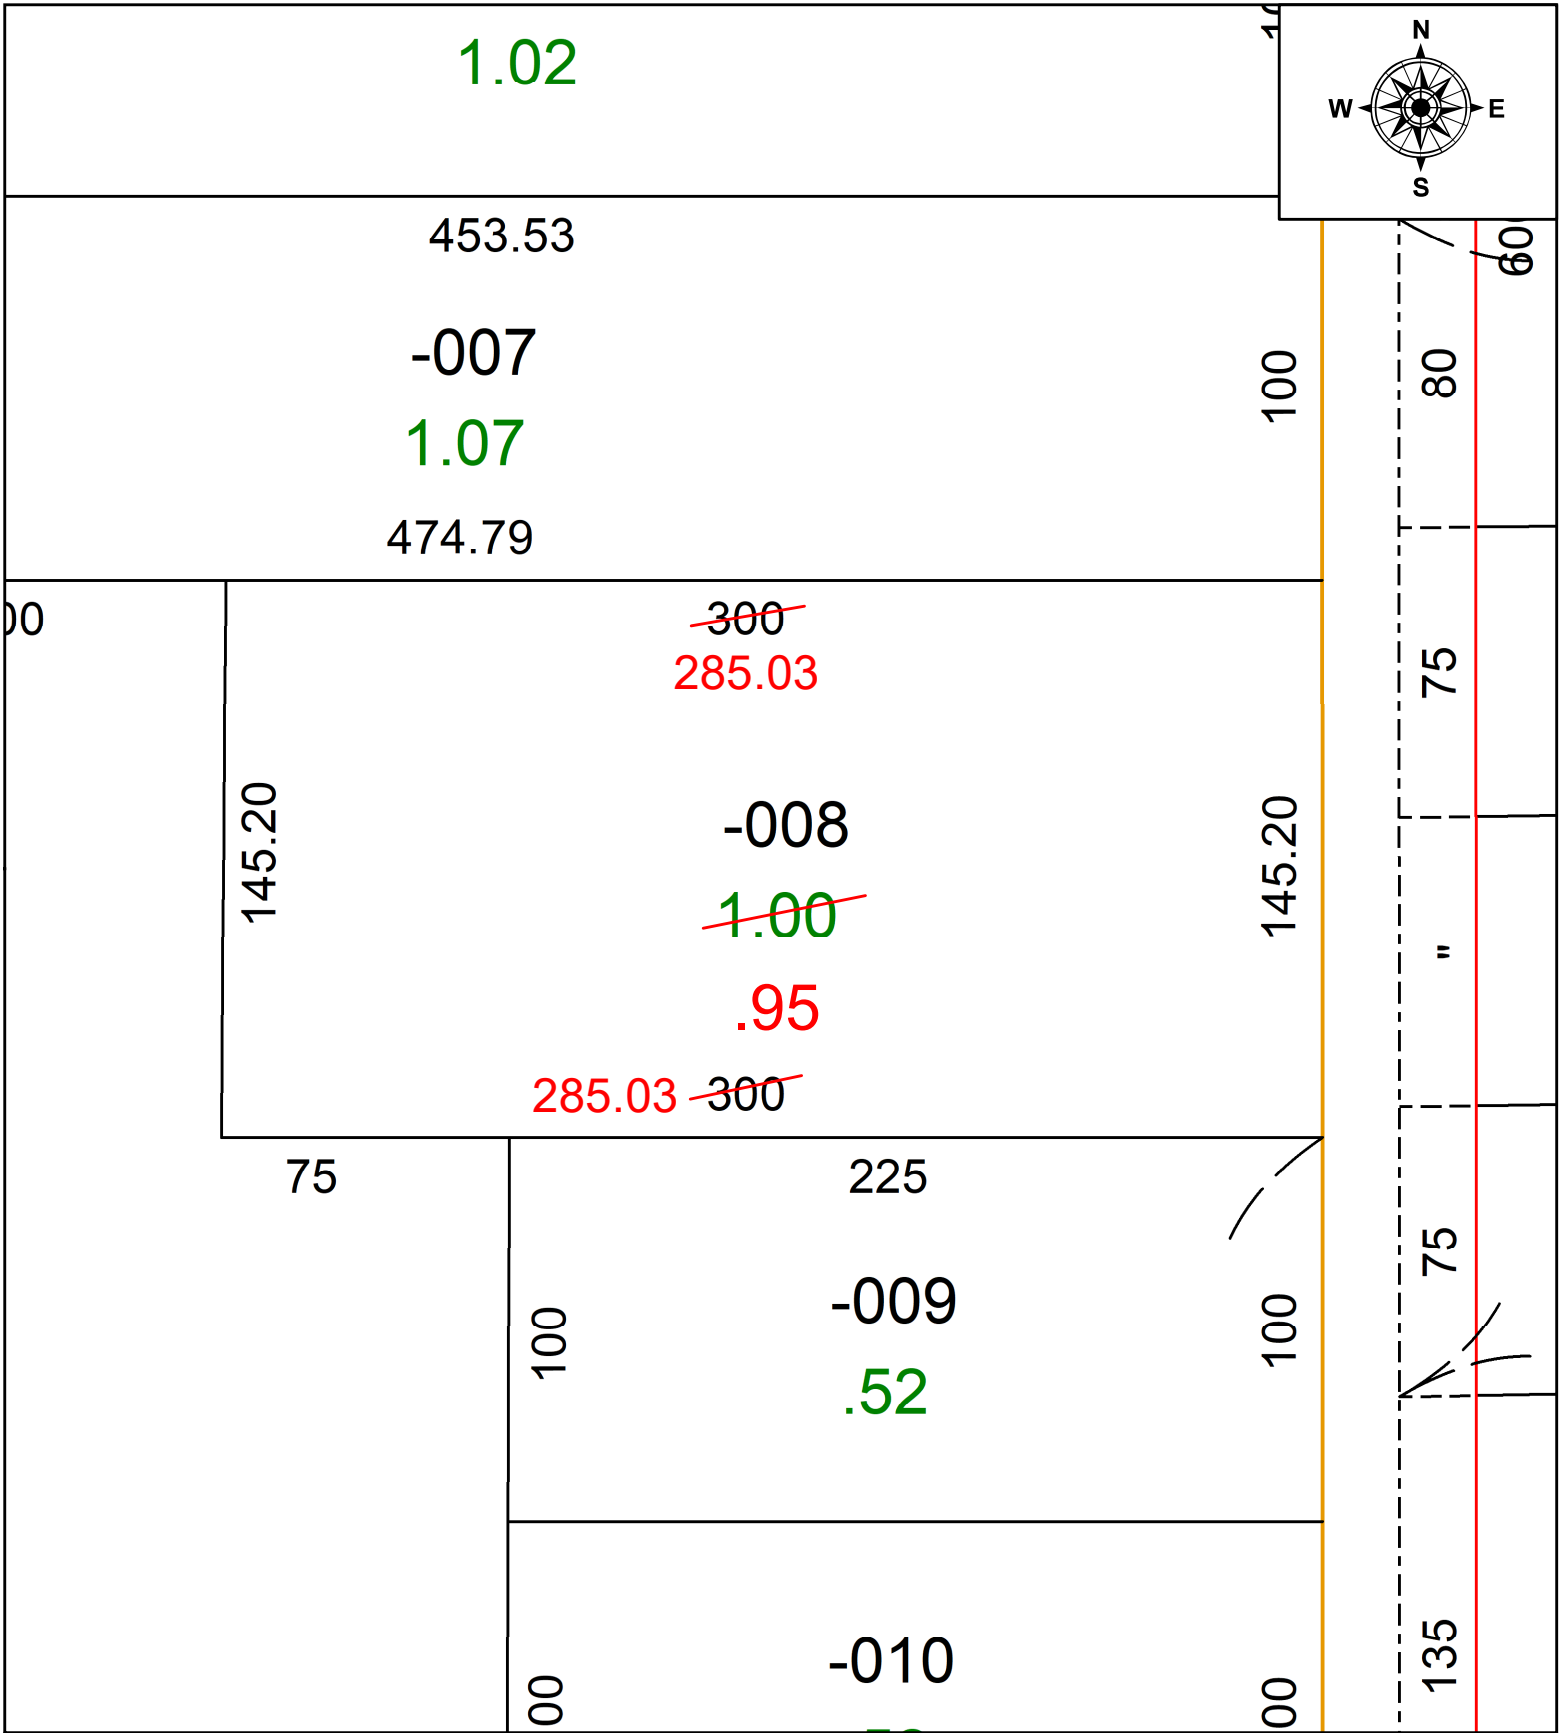

SPLITS/DEEDS PROCESSED
 LORAIN COUNTY TAX MAP DEPARTMENT
 226 MIDDLE AVE. ELYRIA, OH

SURVEYED BY: ANDREW PLANET SURVEY #: 50713
 CLOSURE: 1:-2147483648
 MAP PAGE(S): 10-00-006
 APPROVED BY: DMA DATE: 10/13/2022
 SCALE: 1" = 50' PRIOR INSTRUMENT: 2022-0889872