
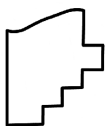


PARENT PARCEL: 02-02-006-108-043

CHILD PARCEL: **MAP CORRECTION ONLY**

STARTING POINT: CORNER OF S/L 145 OF CARR ESTATES SUB NO. 3

22-04964-C

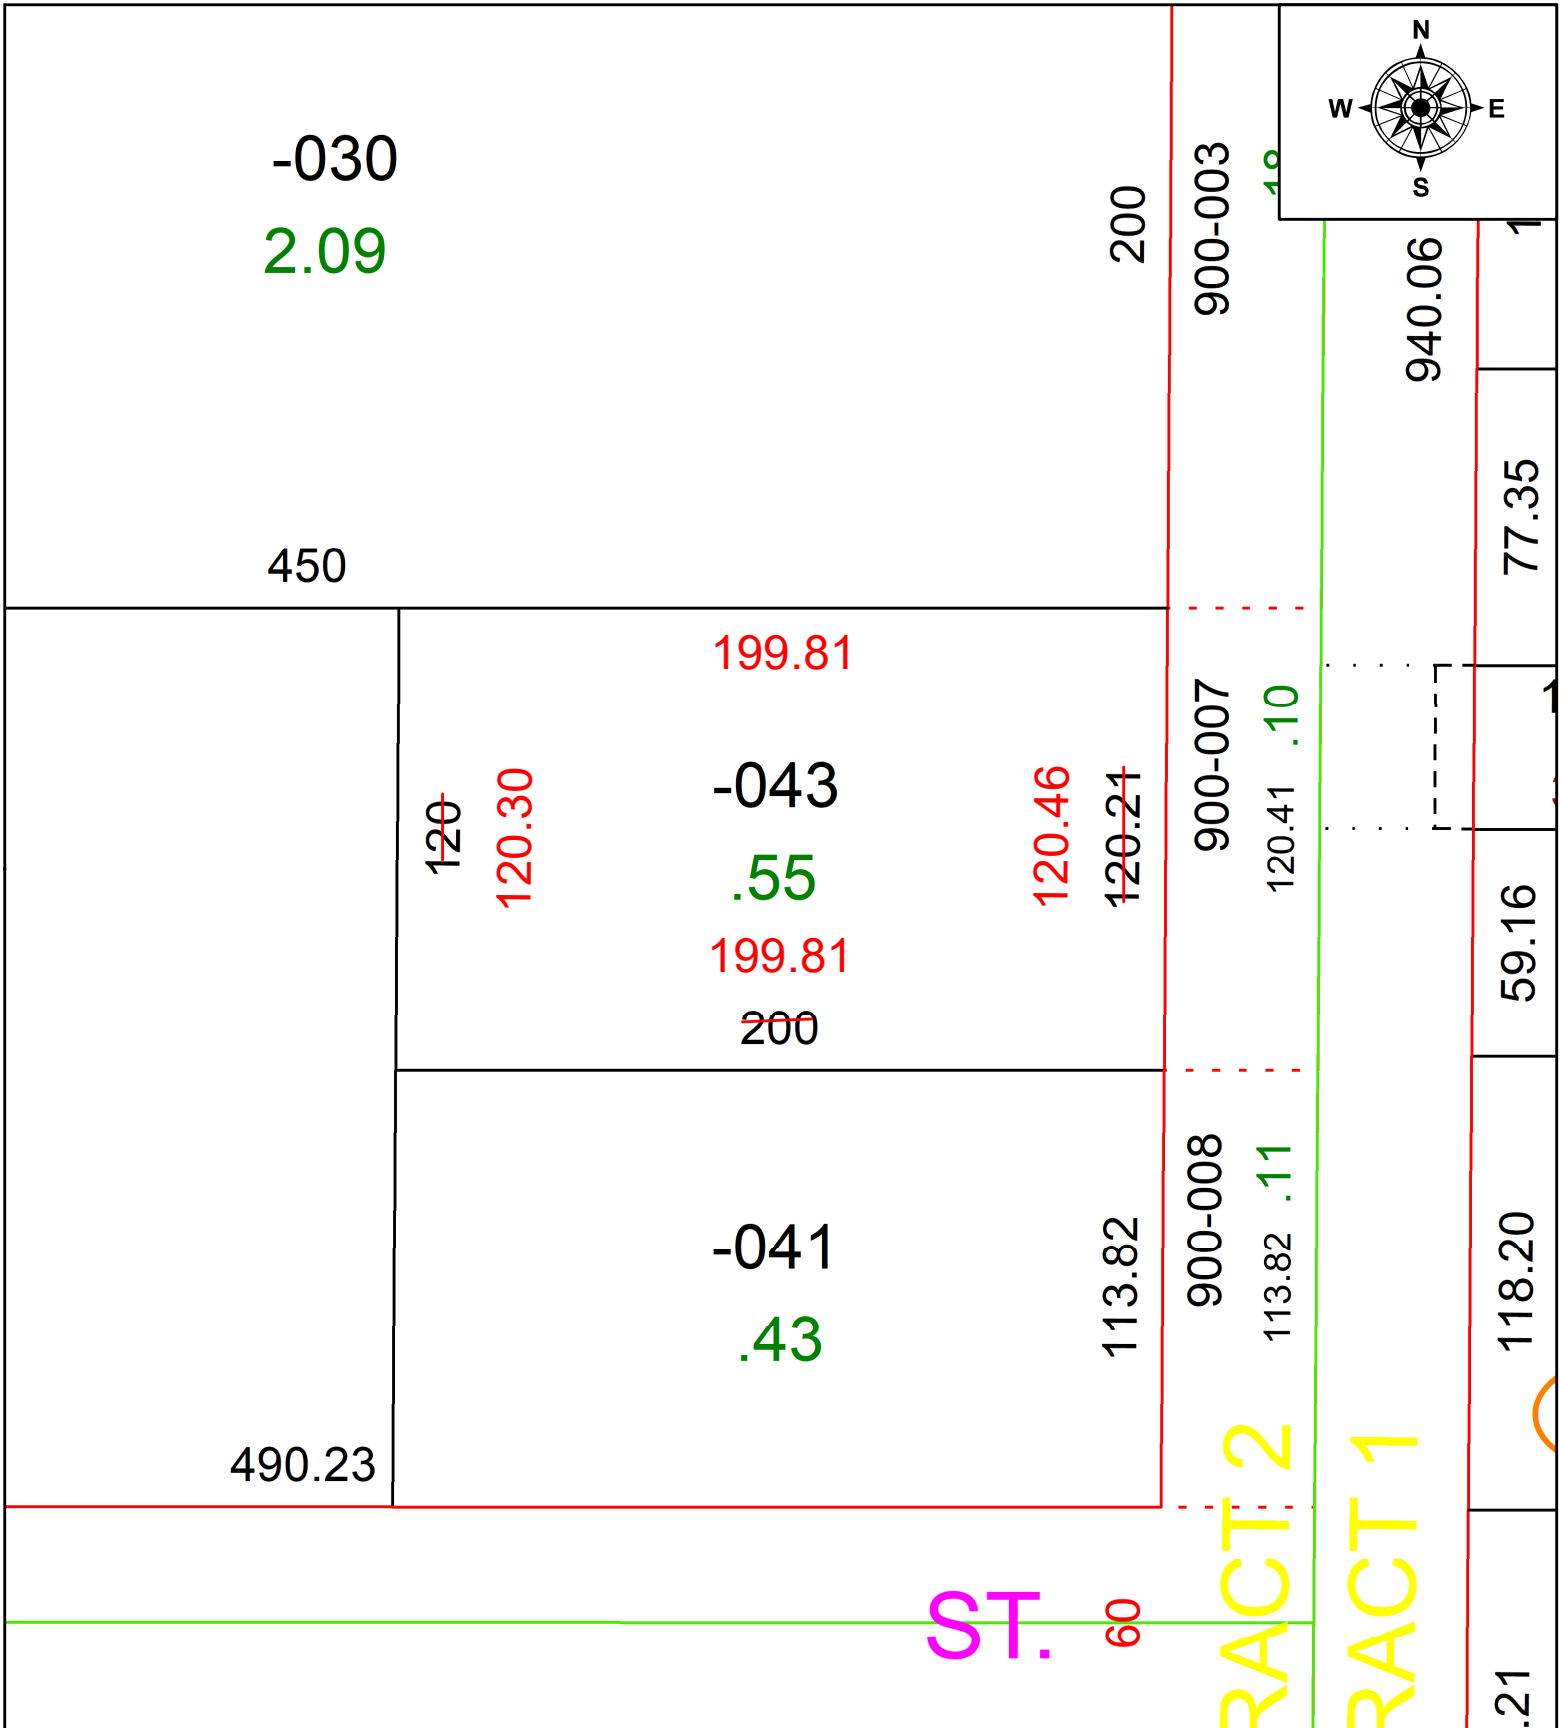

**SPLITS/DEEDS PROCESSED**  
LORAIN COUNTY TAX MAP DEPARTMENT  
226 MIDDLE AVE. ELYRIA, OH

SURVEYED BY: JOSEPH A. BURGOON	SURV # 50716
CLOSURE: 1: 466850	
MAP PAGE(S): 02-02-006-B	
APPROVED BY: AC	DATE: October 19, 2022
SCALE: 1 in = 50 ft	PRIOR INSTRUMENT: 2007- 0220707