


PARENT PARCEL: 05-00-002-000-042

CHILD PARCEL: **MAP CORRECTION ONLY**

22-04965-C

STARTING POINT: C/L OF COOPER FOSTER PARK RD AND W LINE OF O/L 2

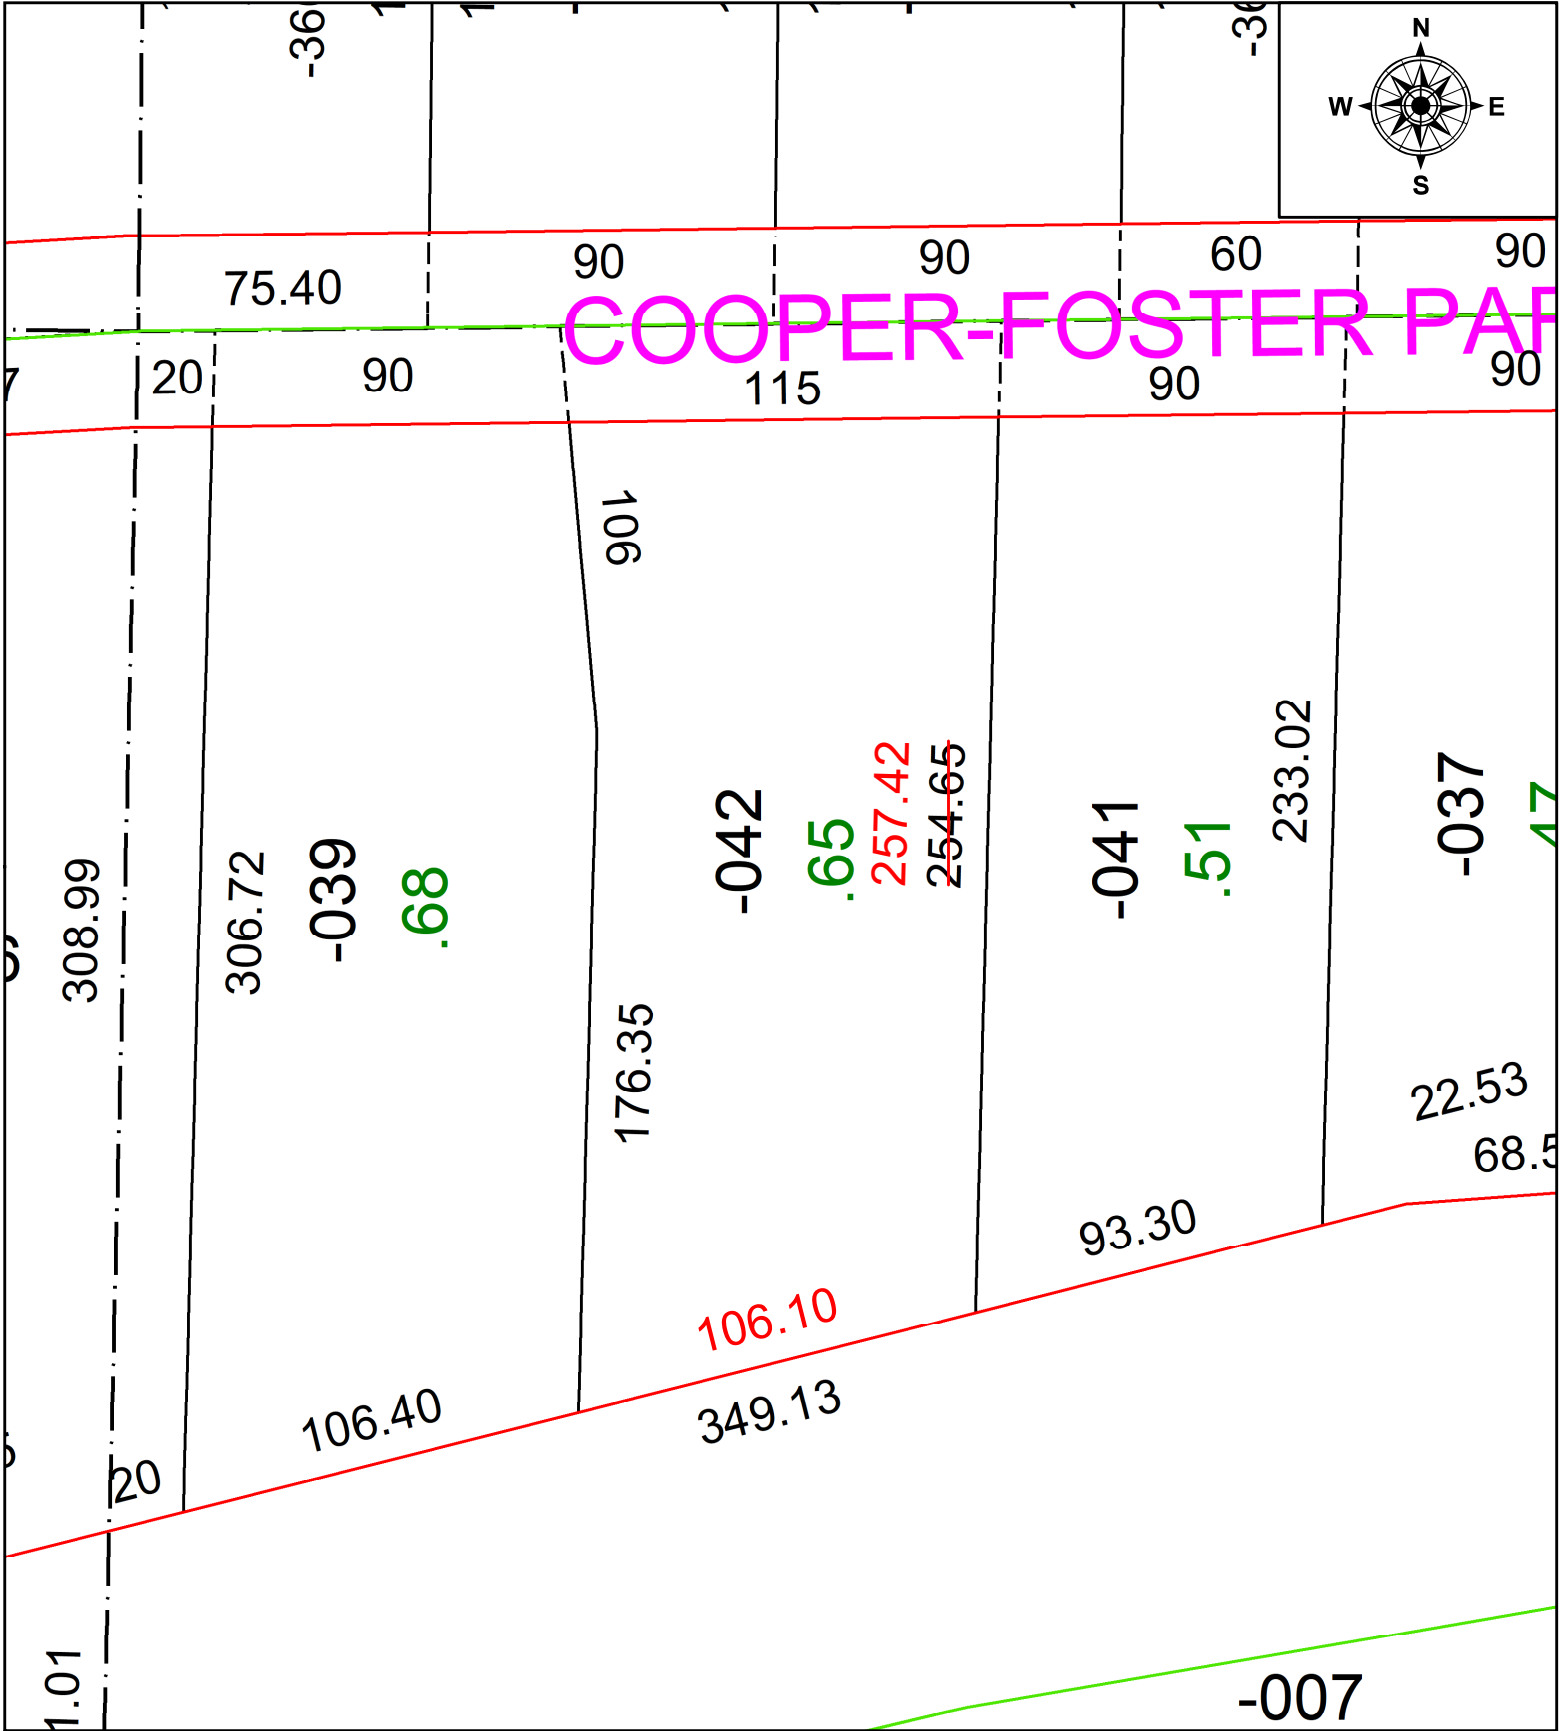

**SPLITS/DEEDS PROCESSED**  
 LORAIN COUNTY TAX MAP DEPARTMENT  
 226 MIDDLE AVE. ELYRIA, OH

SURVEYED BY: THOMAS M. SNEZEK SURV # 50717  
 CLOSURE: 1: 115231  
 MAP PAGE(S): 05-00-002  
 APPROVED BY: AC DATE: October 19, 2022  
 SCALE: 1 in = 50 ft PRIOR INSTRUMENT: 2013- 0461691