
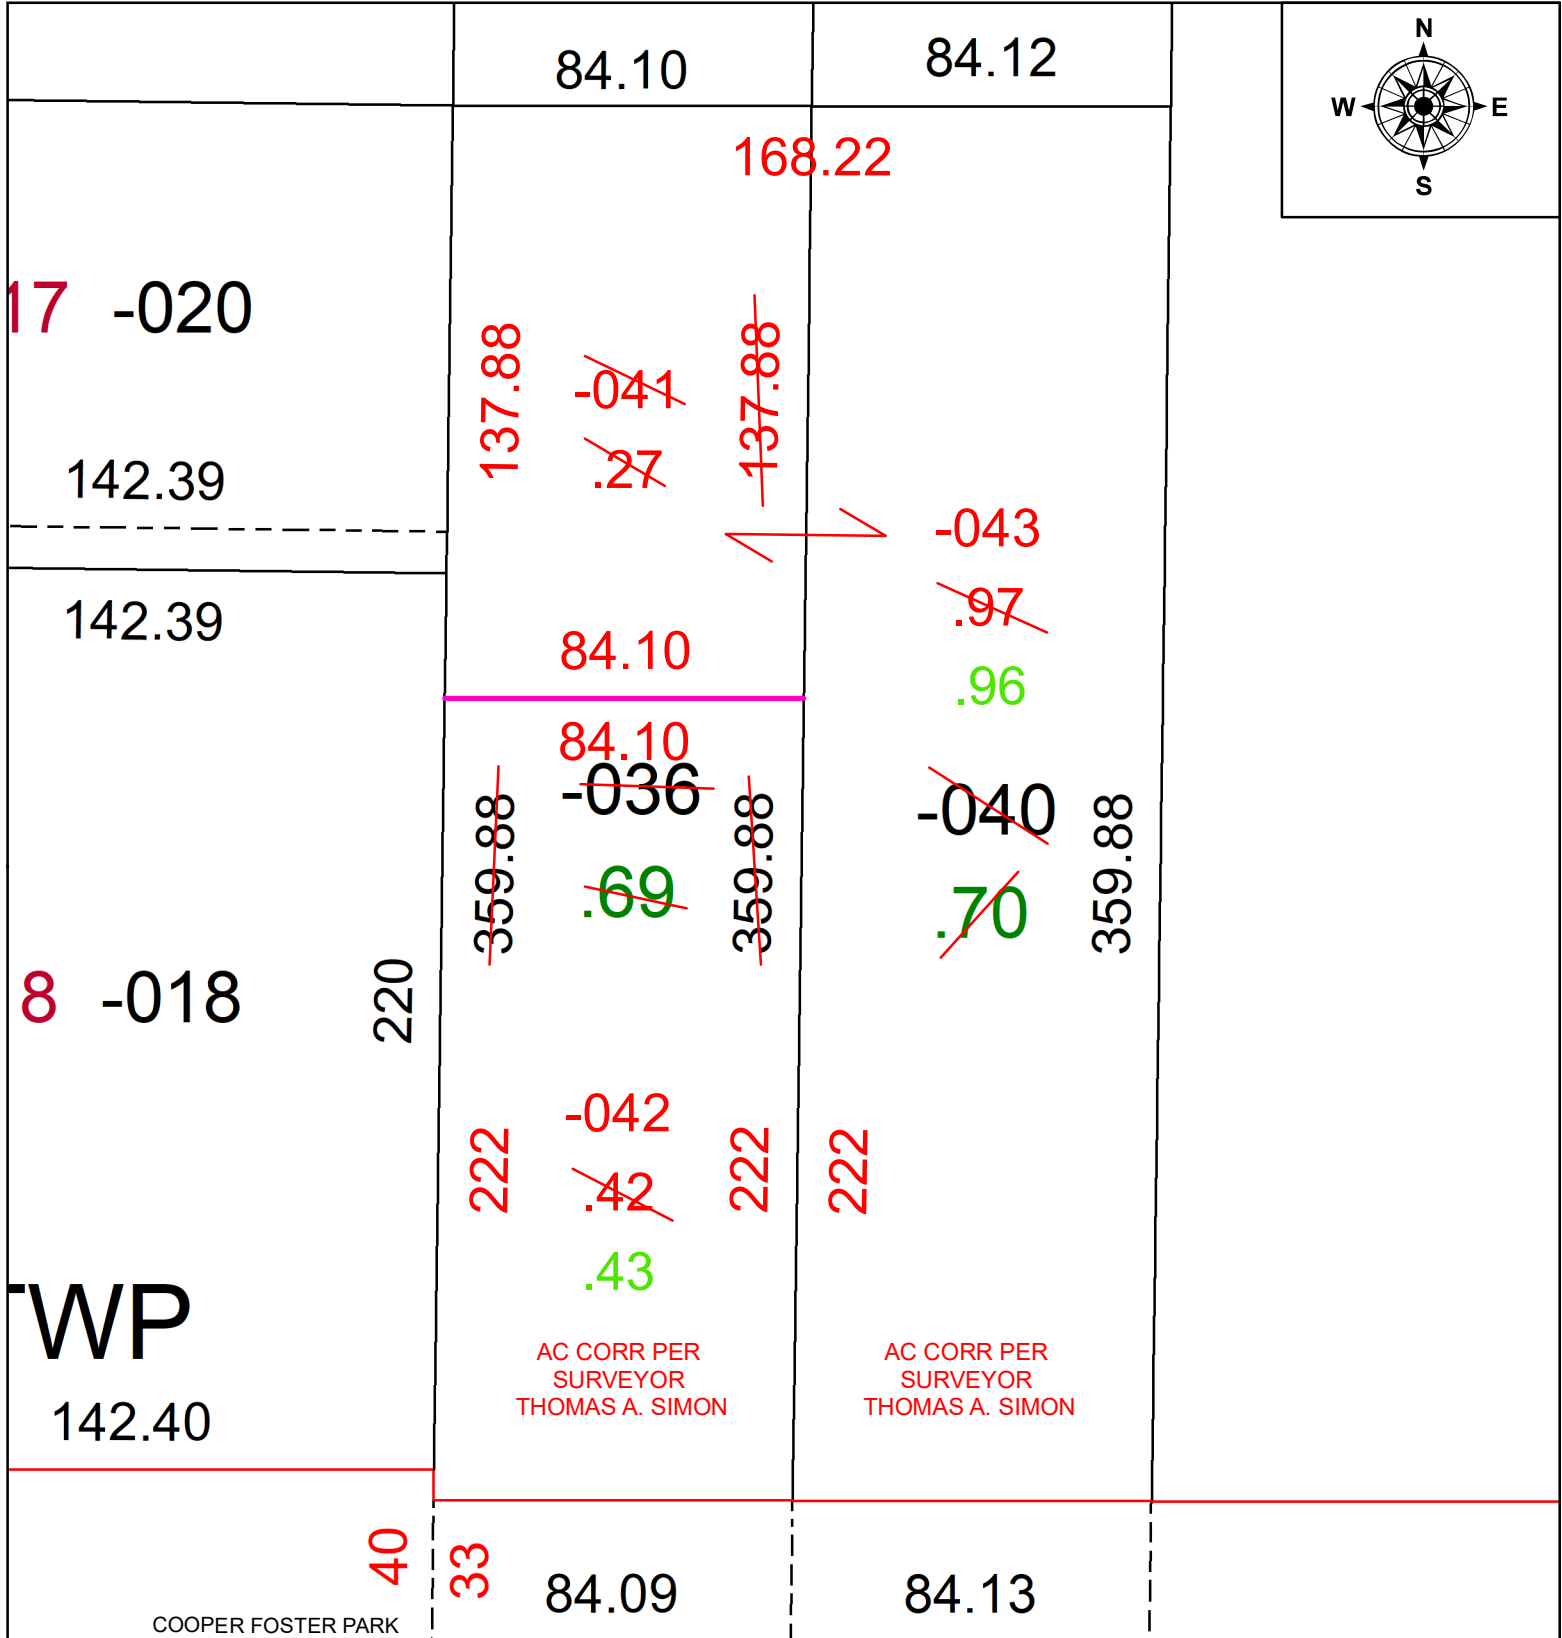


PARENT PARCEL: 02-01-003-270-036 & -040

CHILD PARCEL: 02-01-003-270-041, -042, & -043 AC CORR PER SURVEYOR THOMAS A. SIMON


STARTING POINT: C/L OF CHERRYWOOD DR AND COOPER FOSTER PARK RD

25-04967

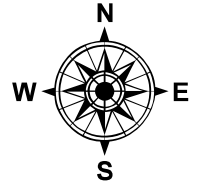

WP
142.40

COOPER FOSTER PARK

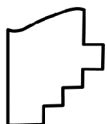

SPLITS/DEEDS PROCESSED
LORAIN COUNTY TAX MAP DEPARTMENT
226 MIDDLE AVE. ELYRIA, OH

SURVEYED BY: THOMAS A. SIMON SURVEY #: 51379
CLOSURE: 1: 166038
MAP PAGE(S): 02-01-003
APPROVED BY: BB DATE: 1/27/2025
SCALE: 1" = 45' PRIOR INSTRUMENT: #20180671298