


PARENT PARCEL: 12-00-070-000-051 & -052

CHILD PARCEL: 12-00-070-000-053 & -054

25-04968

STARTING POINT: NORTHEASTERLY CORNER OF S/L 12 IN ROLLING BROOK SUBDIVISION

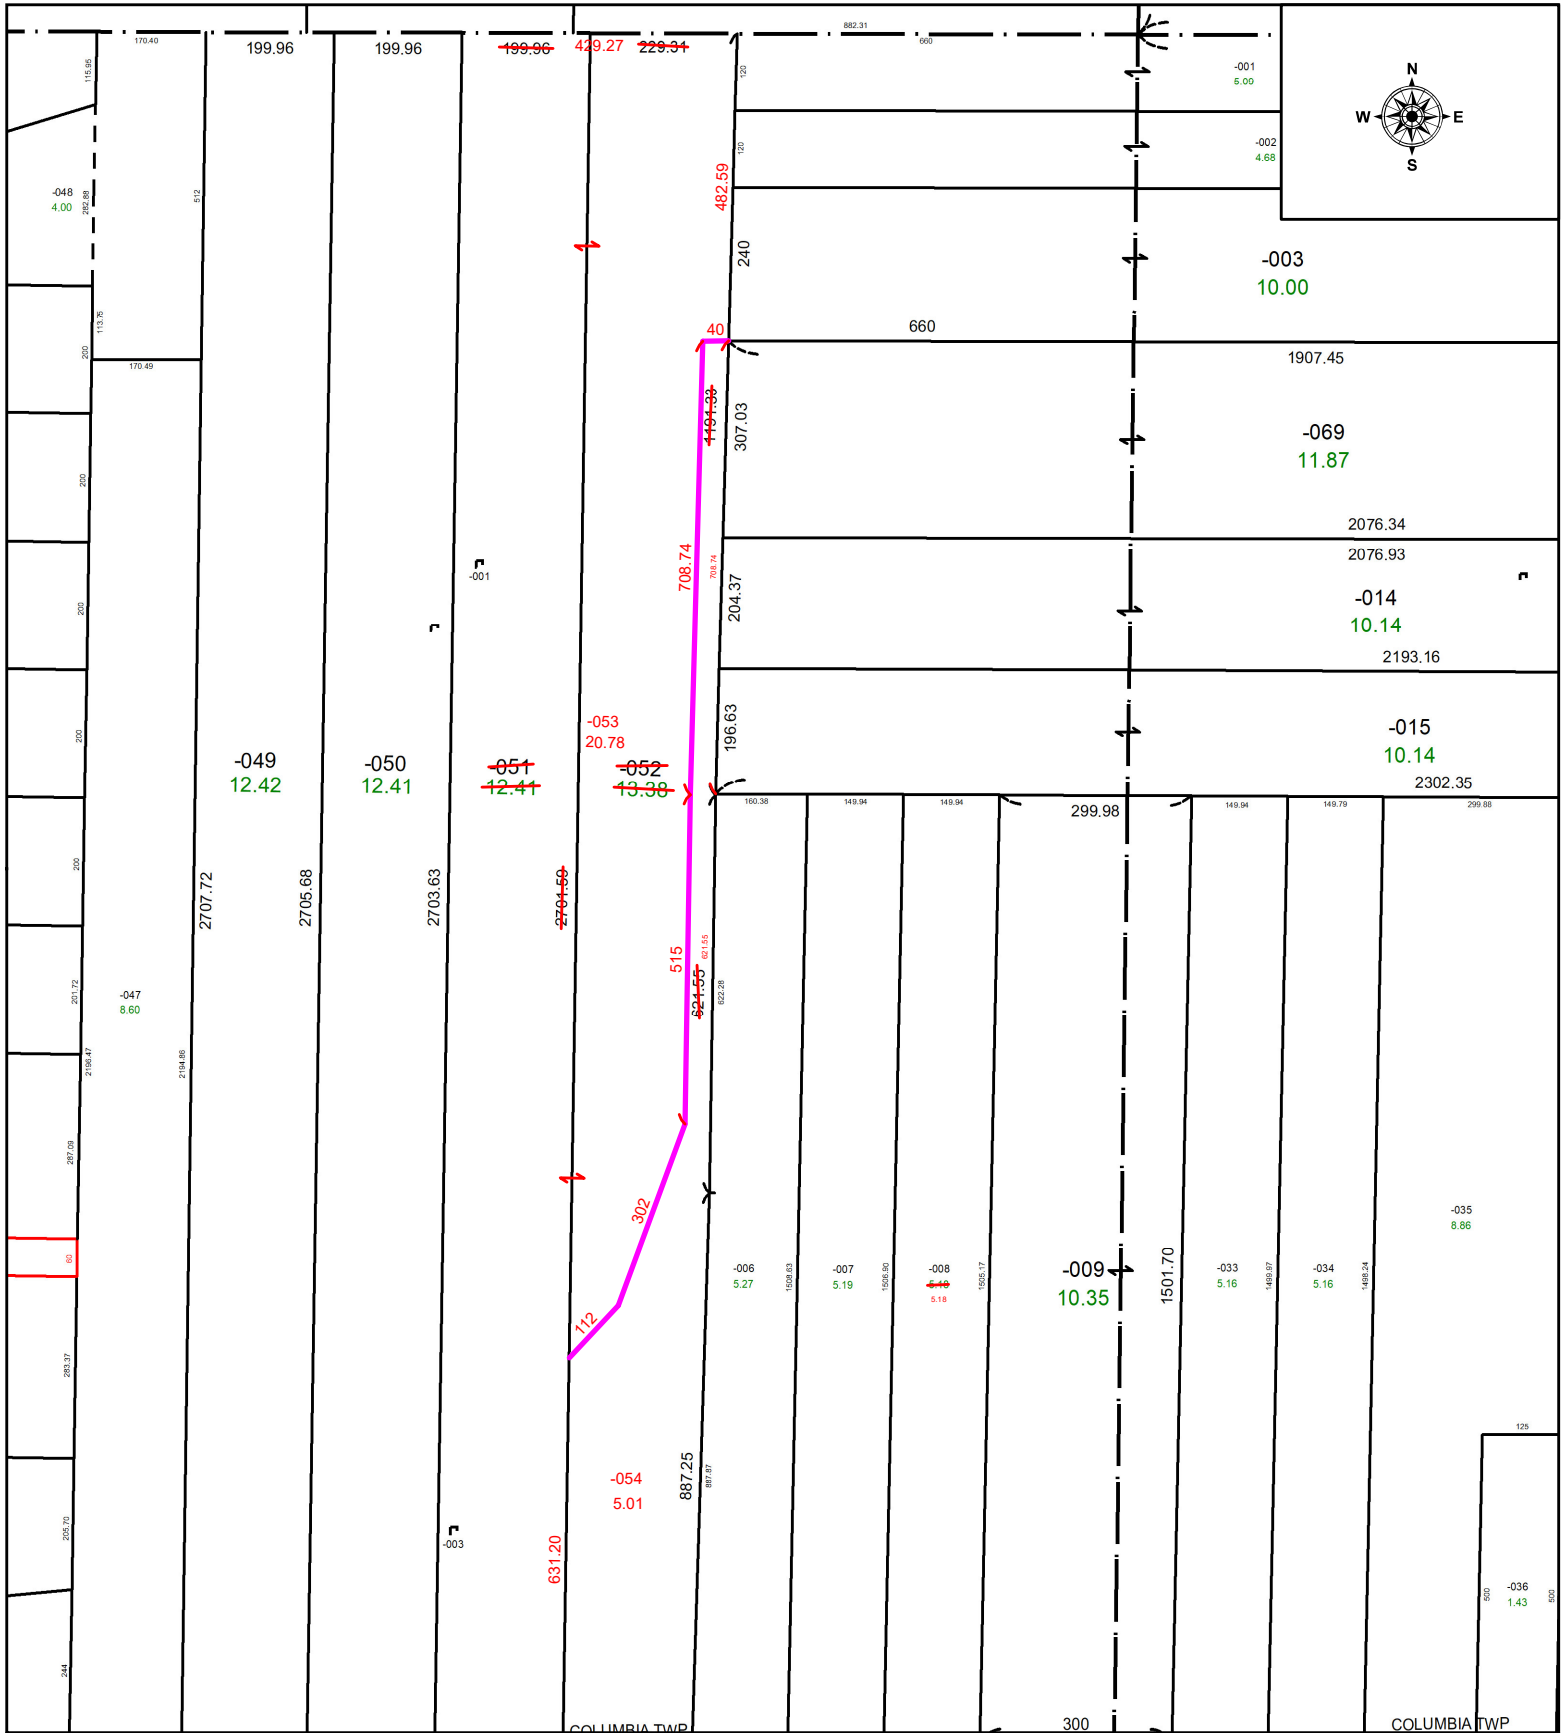

**SPLITS/DEEDS PROCESSED**  
 LORAIN COUNTY TAX MAP DEPARTMENT  
 226 MIDDLE AVE. ELYRIA, OH

SURVEYED BY: LOUIS GIFFELS SURVEY # 51382  
 CLOSURE: 1: 2680087  
 MAP PAGE(S): 12-00-070  
 APPROVED BY: WRZ DATE: 1/27/2025  
 SCALE: 1" = 300 PRIOR INSTRUMENT: #2023-0936840