


PARENT PARCEL: 03-00-003-000-068 & -069

CHILD PARCEL: 03-00-003-000-201

STARTING POINT:

25-04970

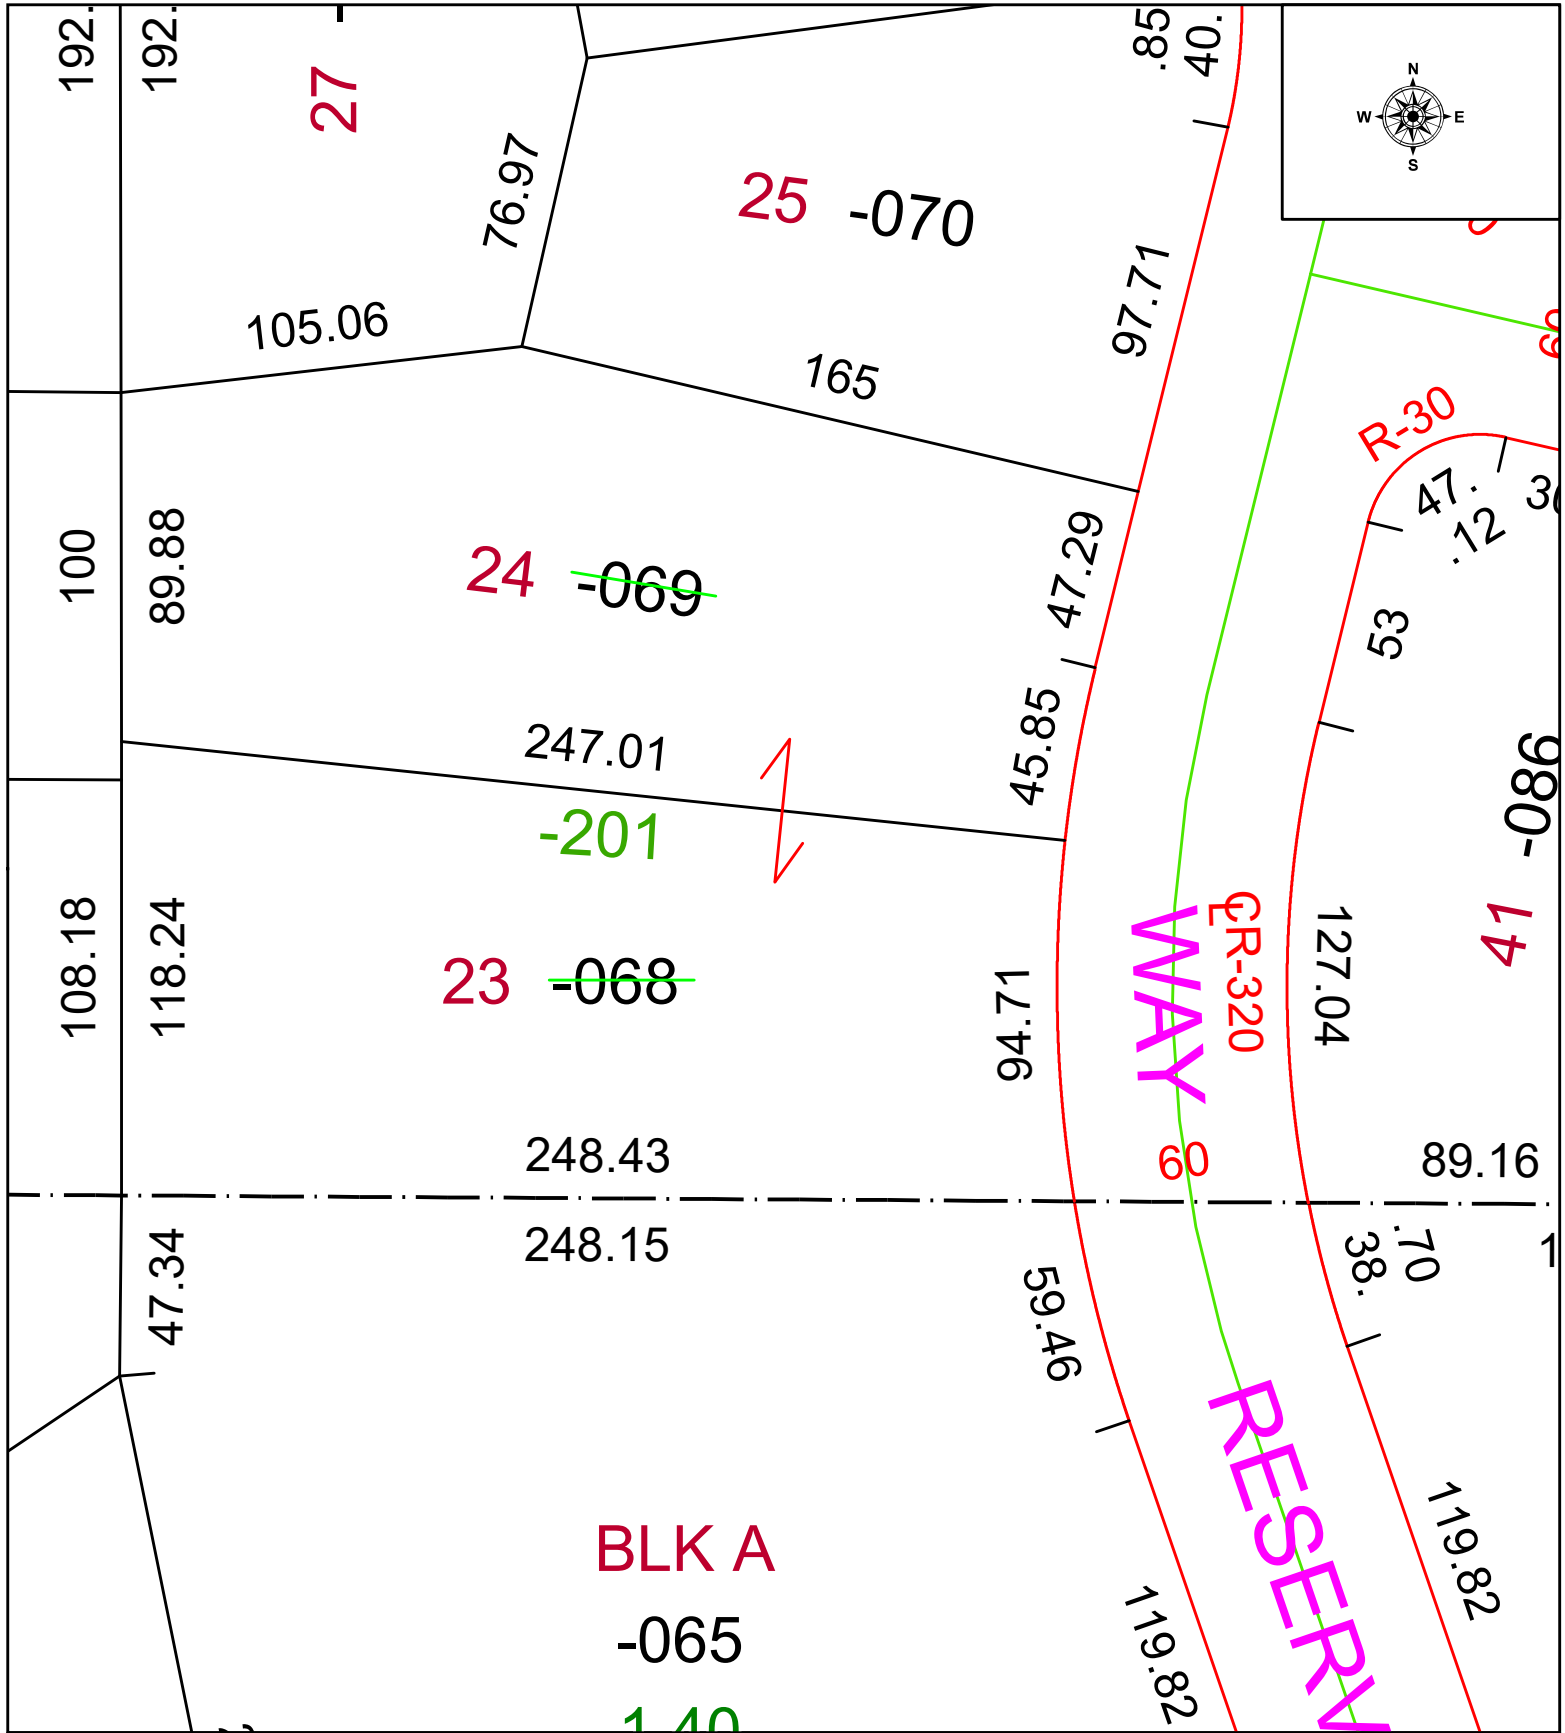

SPLITS/DEEDS PROCESSED
 LORAIN COUNTY TAX MAP DEPARTMENT
 226 MIDDLE AVE. ELYRIA, OH

SURVEYED BY: _____ N/A SURVEY # N/A
 CLOSURE: _____ 1:
 MAP PAGE(S): _____ 03-00-003
 APPROVED BY: _____ WRZ DATE: _____ 1/29/2025
 SCALE: _____ 1" = 50 PRIOR INSTRUMENT: _____ #2023-0923415