


PARENT PARCEL: 05-00-097-103-147 & -149

CHILD PARCEL: 05-00-097-103-150 & 151 & -152

STARTING POINT: INTERSECTION OF NORTH RIDGE RD AND QUARRY RD

25-04971

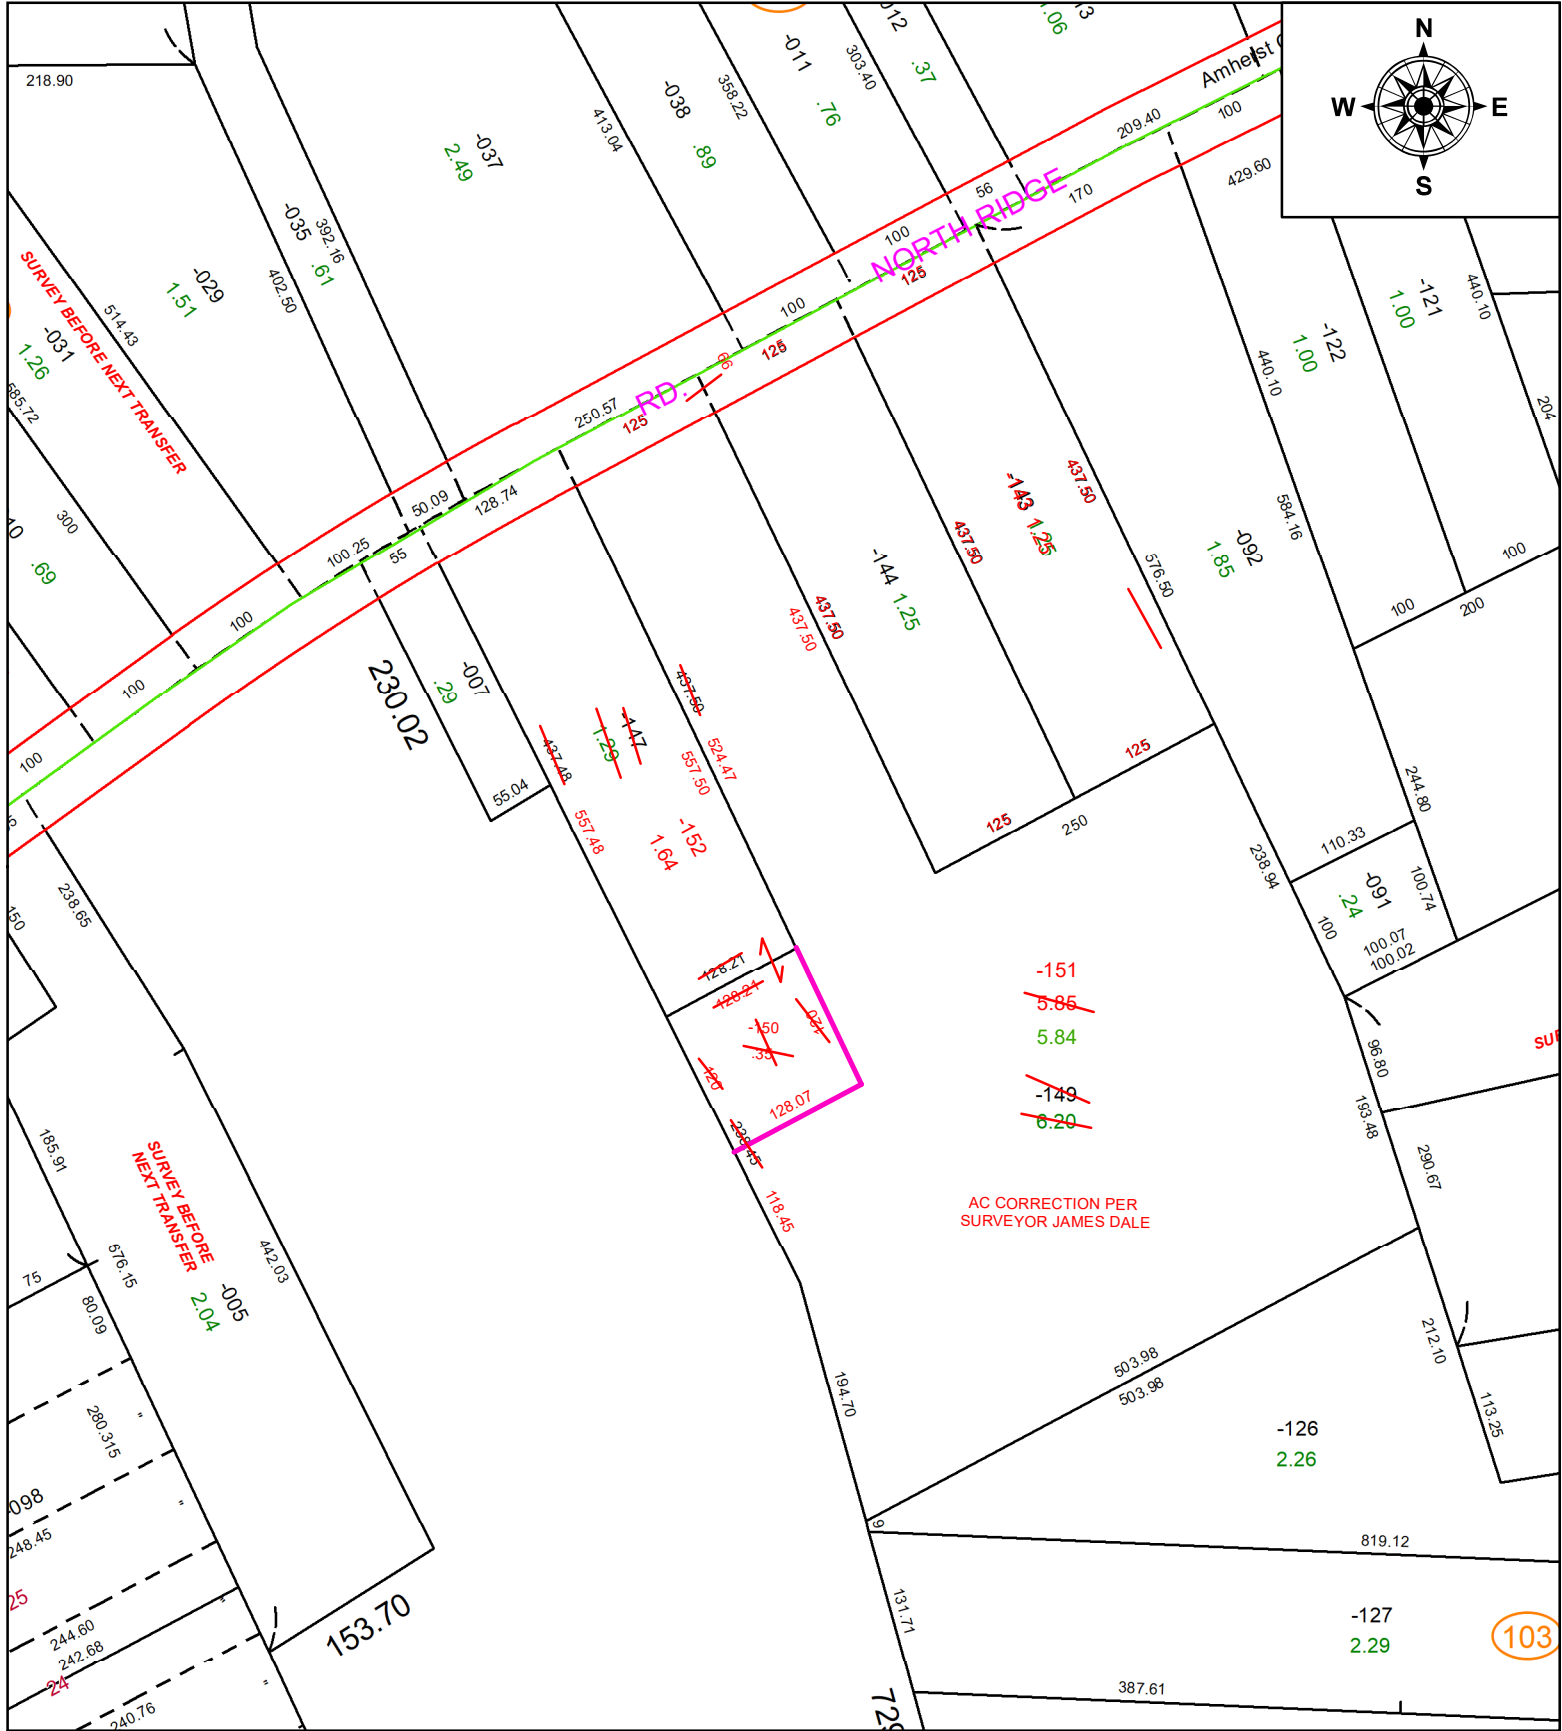

SPLITS/DEEDS PROCESSED
 LORAIN COUNTY TAX MAP DEPARTMENT
 226 MIDDLE AVE. ELYRIA, OH

SURVEYED BY: JAMES DALE **SURVEY #:** 51384
CLOSURE: 1: 93064
MAP PAGE(S): 05-00-097
APPROVED BY: BB **DATE:** 1/30/2025
SCALE: 1" = 110' **PRIOR INSTRUMENT:** #20250039868