
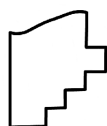


PARENT PARCEL: 01-00-002-110-052, -053, & -054

CHILD PARCEL: 01-00-002-110-070 & -071

STARTING POINT: FRONT & DEPTH TO AC CORR PER SURV BY DAVID A. WILLIAMS

25-04972

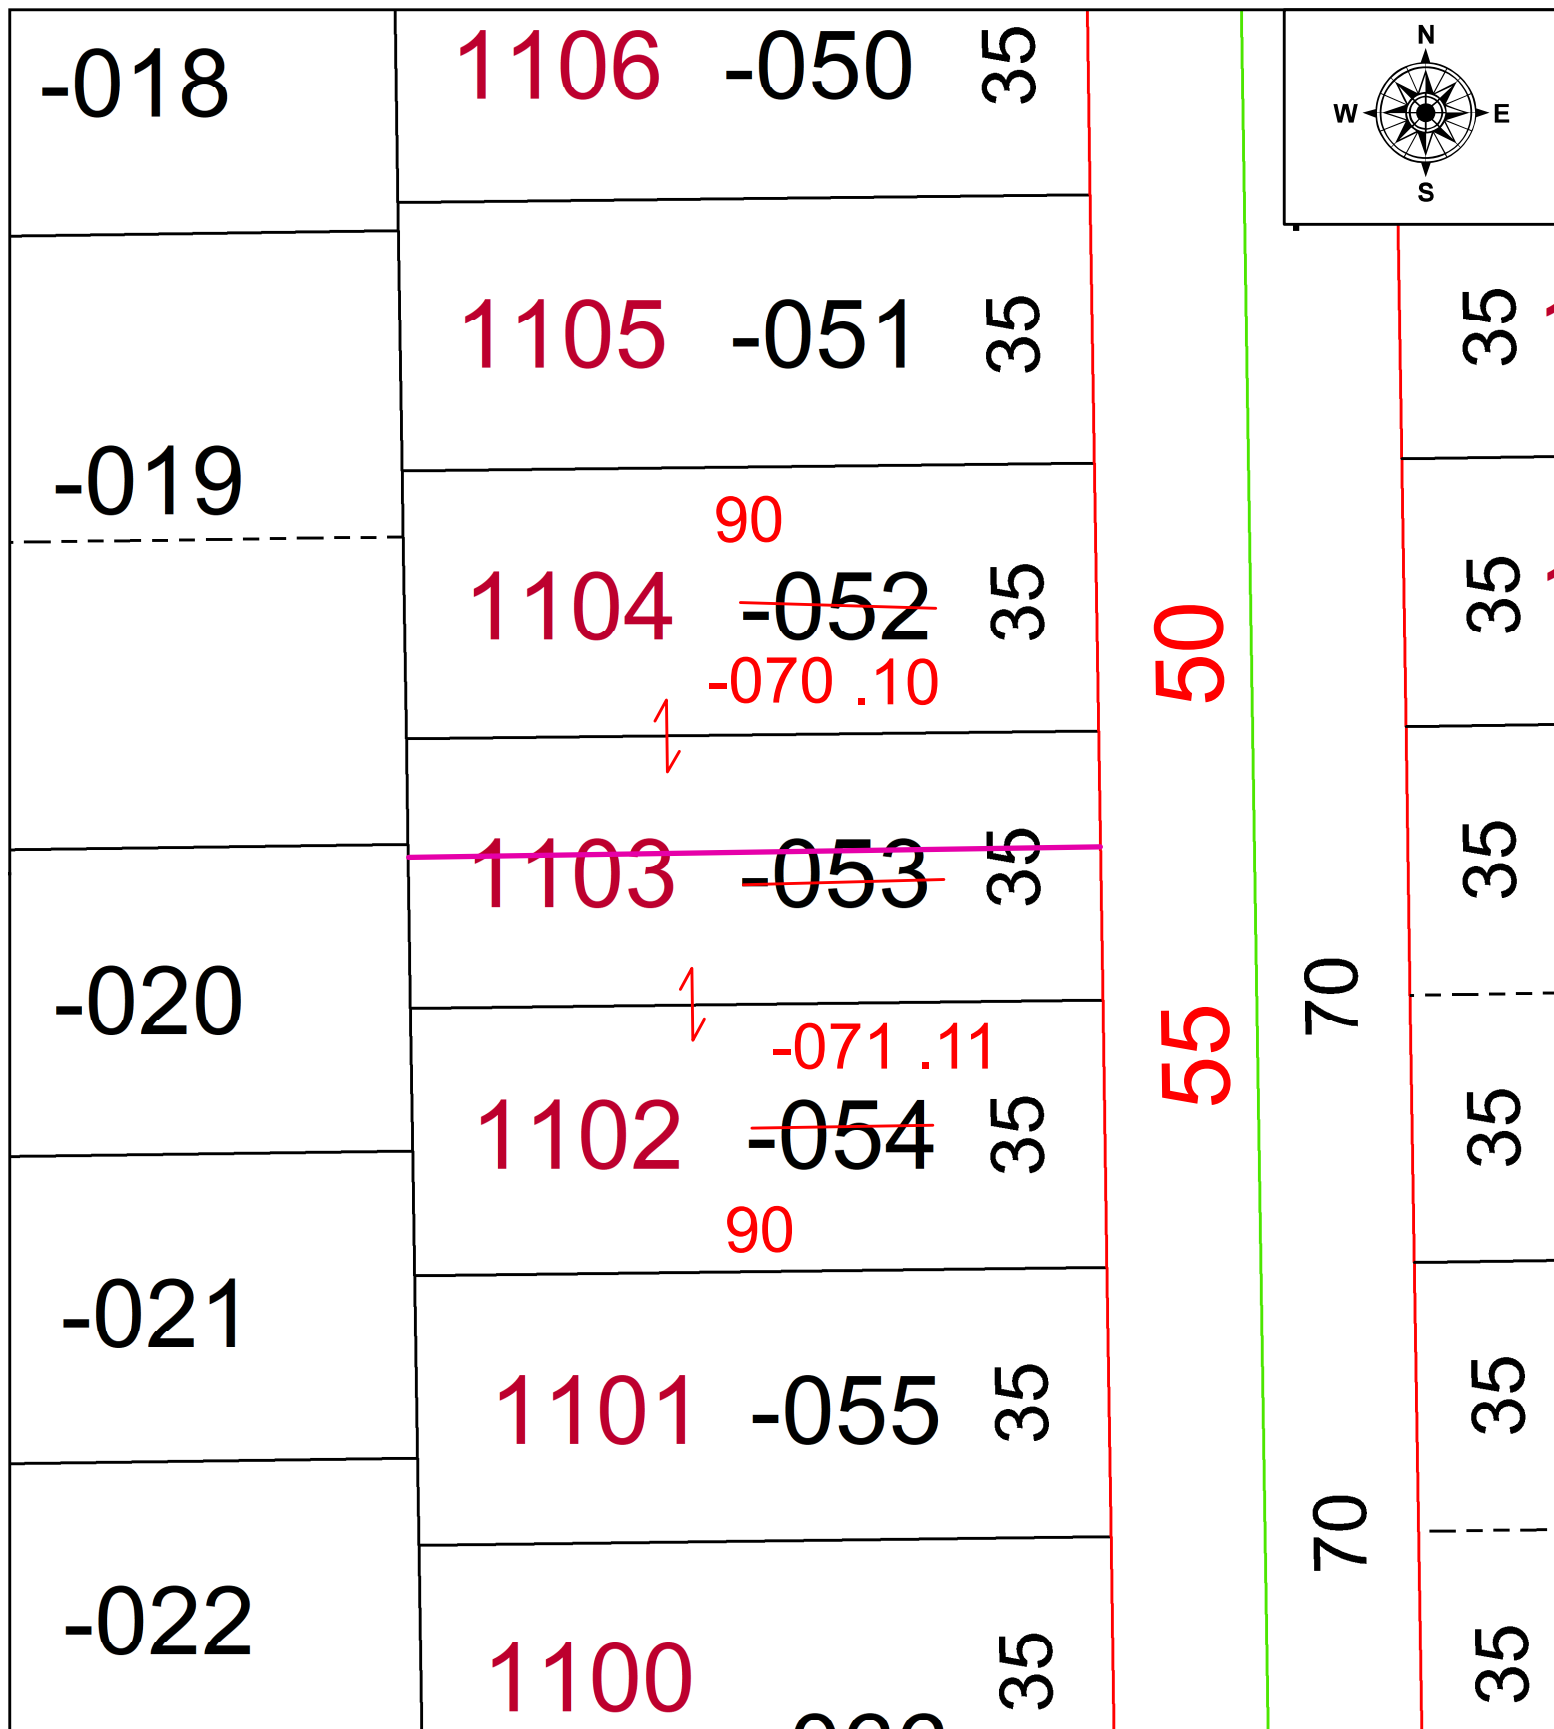

SPLITS/DEEDS PROCESSED
LORAIN COUNTY TAX MAP DEPARTMENT
226 MIDDLE AVE. ELYRIA, OH

SURVEYED BY: DAVID A. WILLIAMS SURV # 51386

CLOSURE: 1: INF

MAP PAGE(S): 01-00-002

APPROVED BY: AC DATE: February 04, 2025

SCALE: 1 in = 25 ft PRIOR INSTRUMENT: 2021- 0796625