
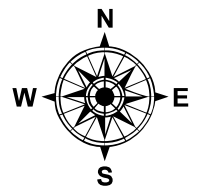


PARENT PARCEL: 07-00-004-104-021

CHILD PARCEL: **AC. CORR. PER SURVEY RICHARD THOMPSON JR.**

STARTING POINT: CL OF LEAR-NAGLE RD. & CHESTNUT RIDGE RD.

22-04976-A

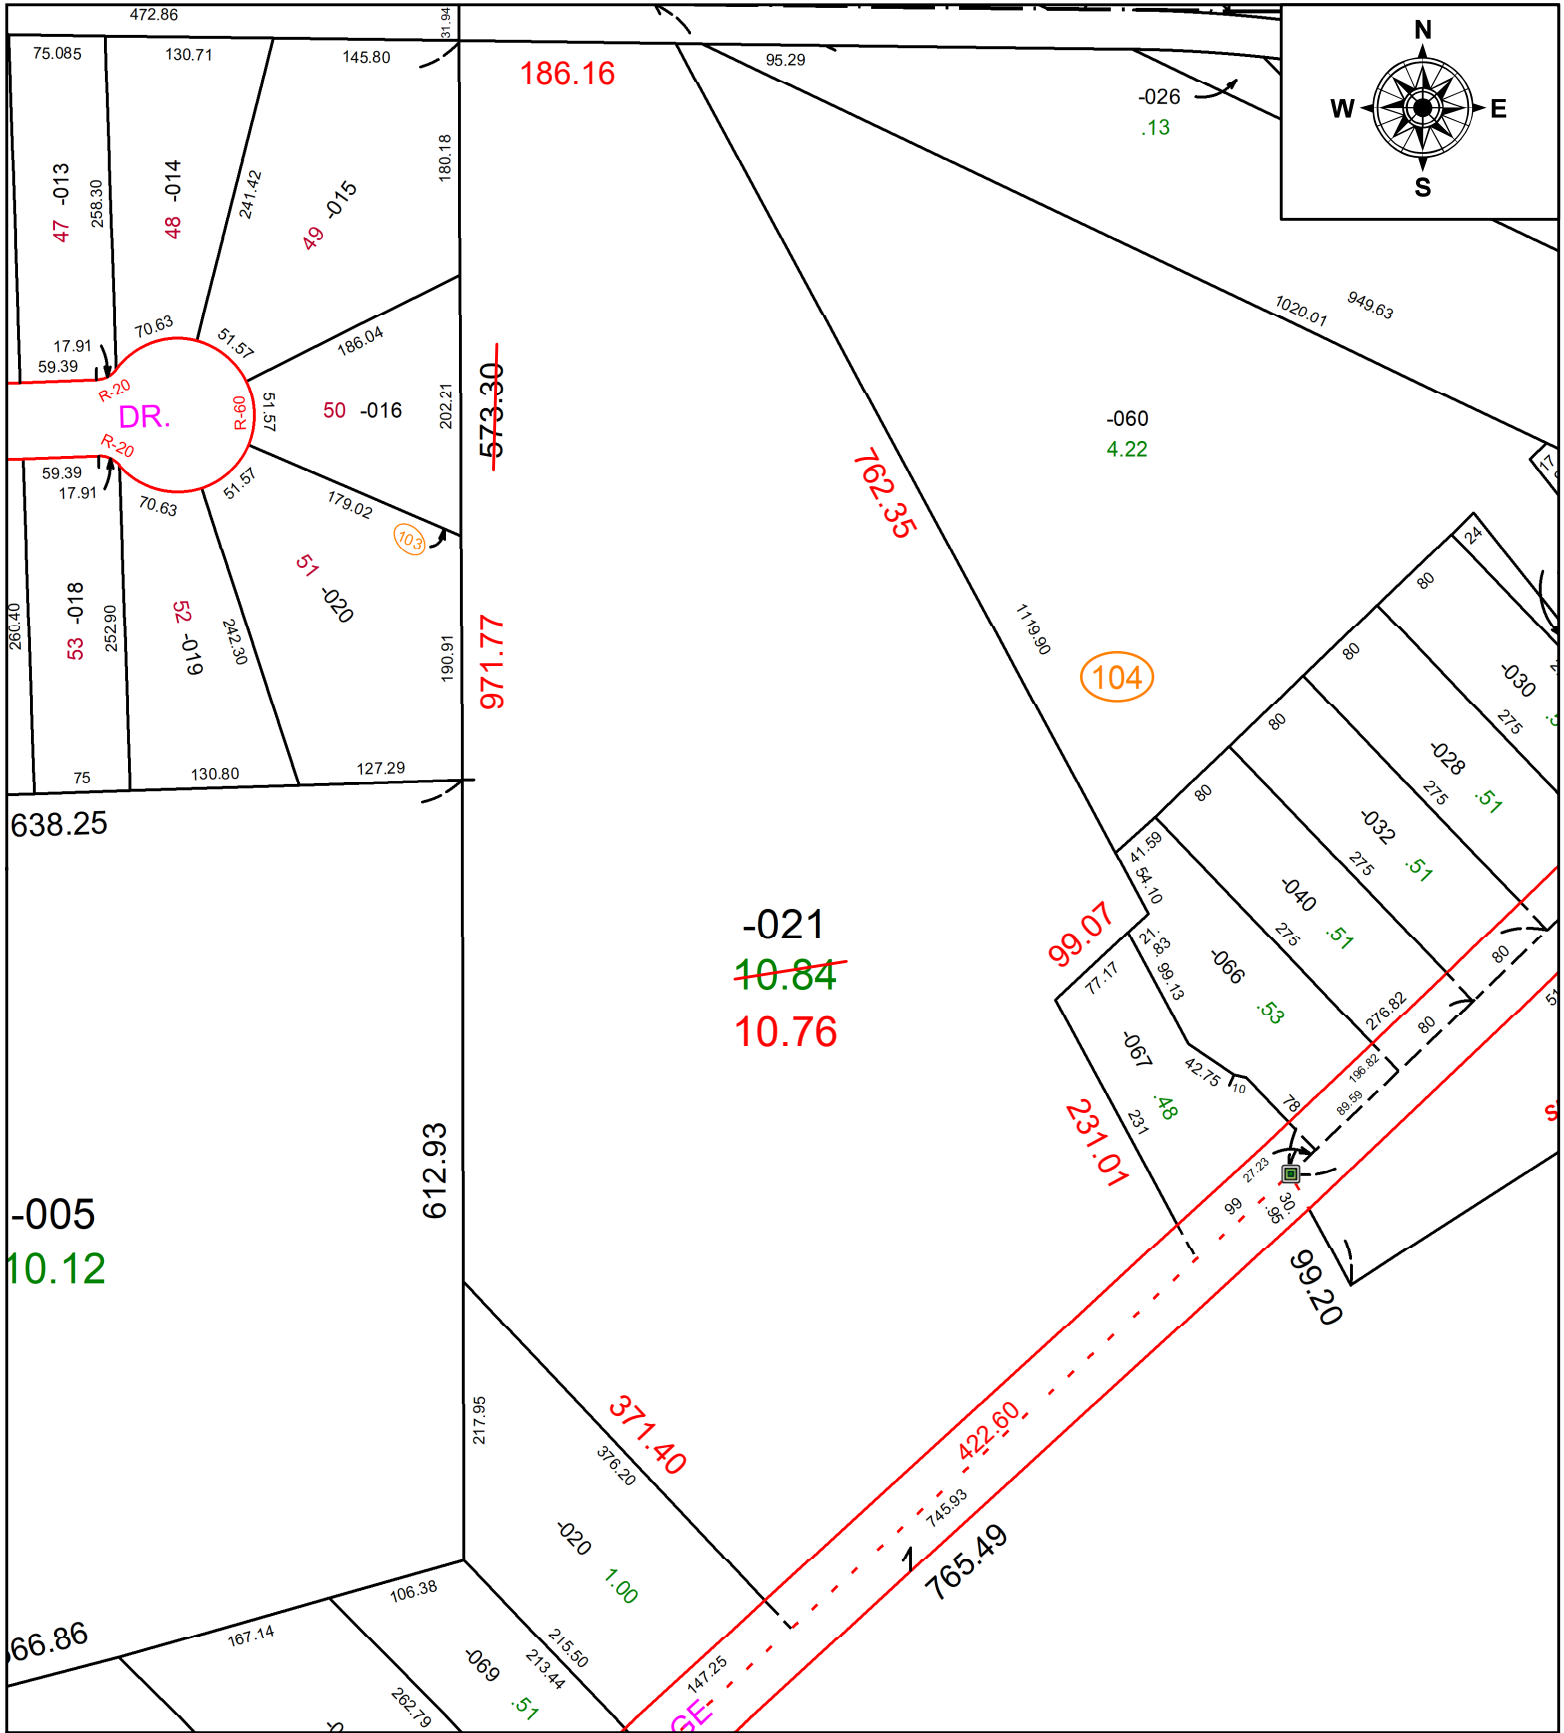

**SPLITS/DEEDS PROCESSED**  
 LORAIN COUNTY TAX MAP DEPARTMENT  
 226 MIDDLE AVE. ELYRIA, OH

**SURVEYED BY:** RICHARD THOMPSON JR. **SURVEY #:** 50734  
**CLOSURE:** 1:434452  
**MAP PAGE(S):** 07-00-004  
**APPROVED BY:** DMA **DATE:** 11/4/2022  
**SCALE:** 1" = 150' **PRIOR INSTRUMENT:** 2012-0441275