
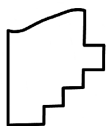


PARENT PARCEL: 05-00-047-000-036

CHILD PARCEL: 05-00-047-000-080 THRU -083 & 05-00-046-000-069

STARTING POINT: C/L OF SR 58 & NE CORNER OF O/L 48 **AC CORR PER SURV BY AMY M. KELLY**

25-04976

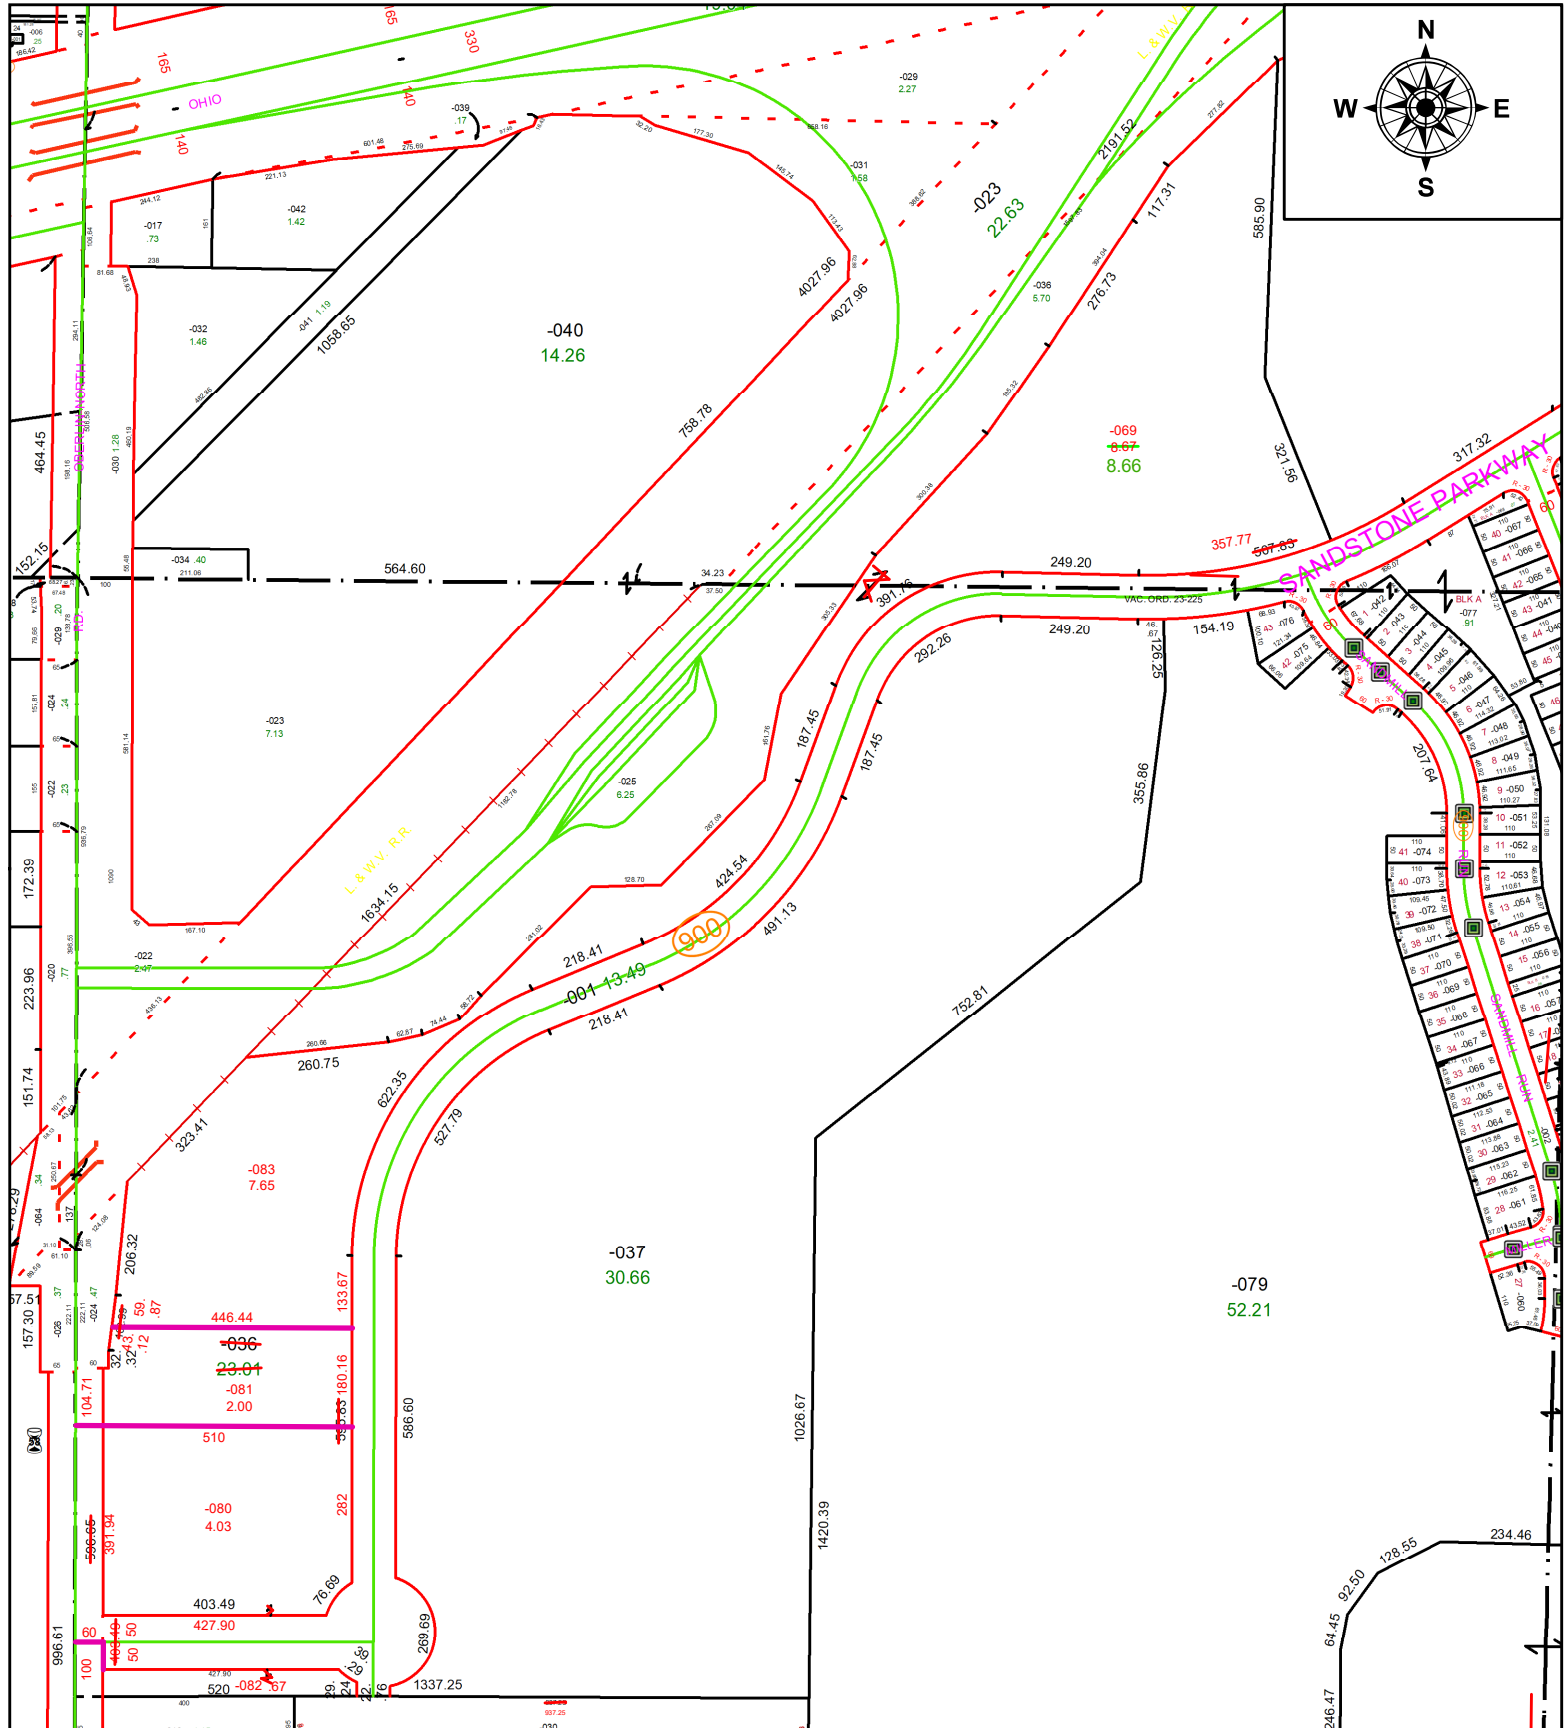

SPLITS/DEEDS PROCESSED

LORAIN COUNTY TAX MAP DEPARTMENT
226 MIDDLE AVE. ELYRIA, OH

SURVEYED BY: AMY M. KELLY

SURV # 51392

CLOSURE: 1: 609309

MAP PAGE(S): 05-00-047

APPROVED BY: AC DATE: February 19, 2025

SCALE: 1 in = 350 ft PRIOR INSTRUMENT: 2023- 0911577