

PARENT PARCEL:

01-00-063-000-058

CHILD PARCEL:



N/A

ACREAGE CORRECTION PER SURVEYOR JOHN DECHANT JR.

22-04978-A

STARTING POINT:

MONUMENT BOX @ C/LS OF GORE ORPHANAGE RD & NORTH RIDGE RD

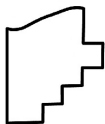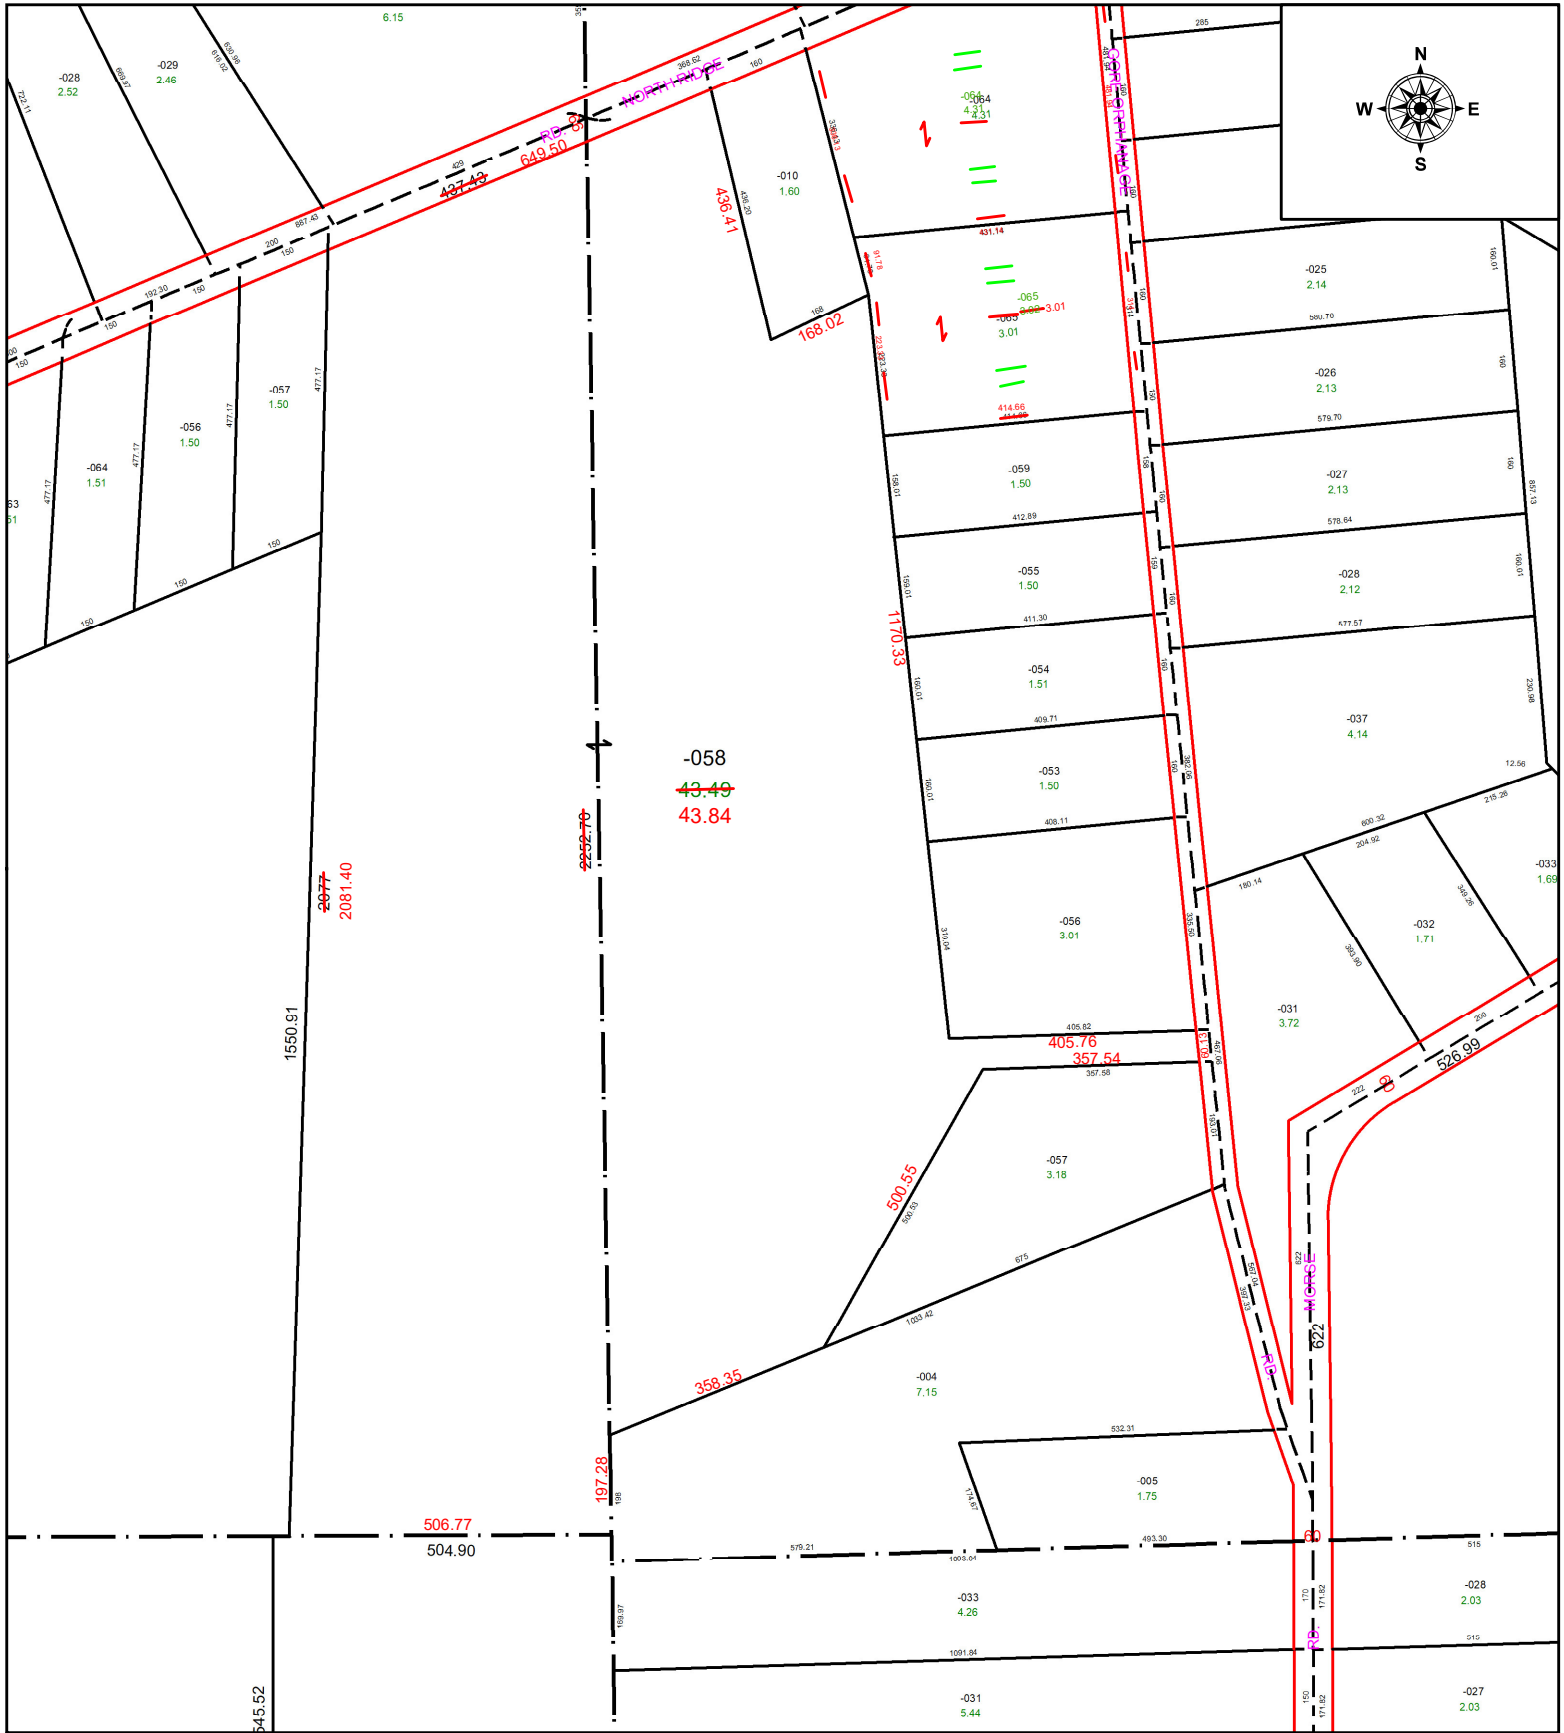

**SPLITS/DEEDS PROCESSED**  
 LORAIN COUNTY TAX MAP DEPARTMENT  
 226 MIDDLE AVE. ELYRIA, OH

**SURVEYED BY:** JOHN DECHANT JR. **SURVEY #** 50735  
**CLOSURE:** 1: 722167  
**MAP PAGE(S):** 01-00-063  
**APPROVED BY:** WRZ **DATE:** 11/7/2022  
**SCALE:** 1" = 300 **PRIOR INSTRUMENT:** #2016-0613119