
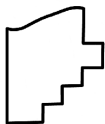


PARENT PARCEL: 16-00-094-000-027

CHILD PARCEL: **MAP CORRECTION ONLY**

STARTING POINT: SE CORNER OF O/L 94 AND C/L OF DUNHAM RD

22-04979-C

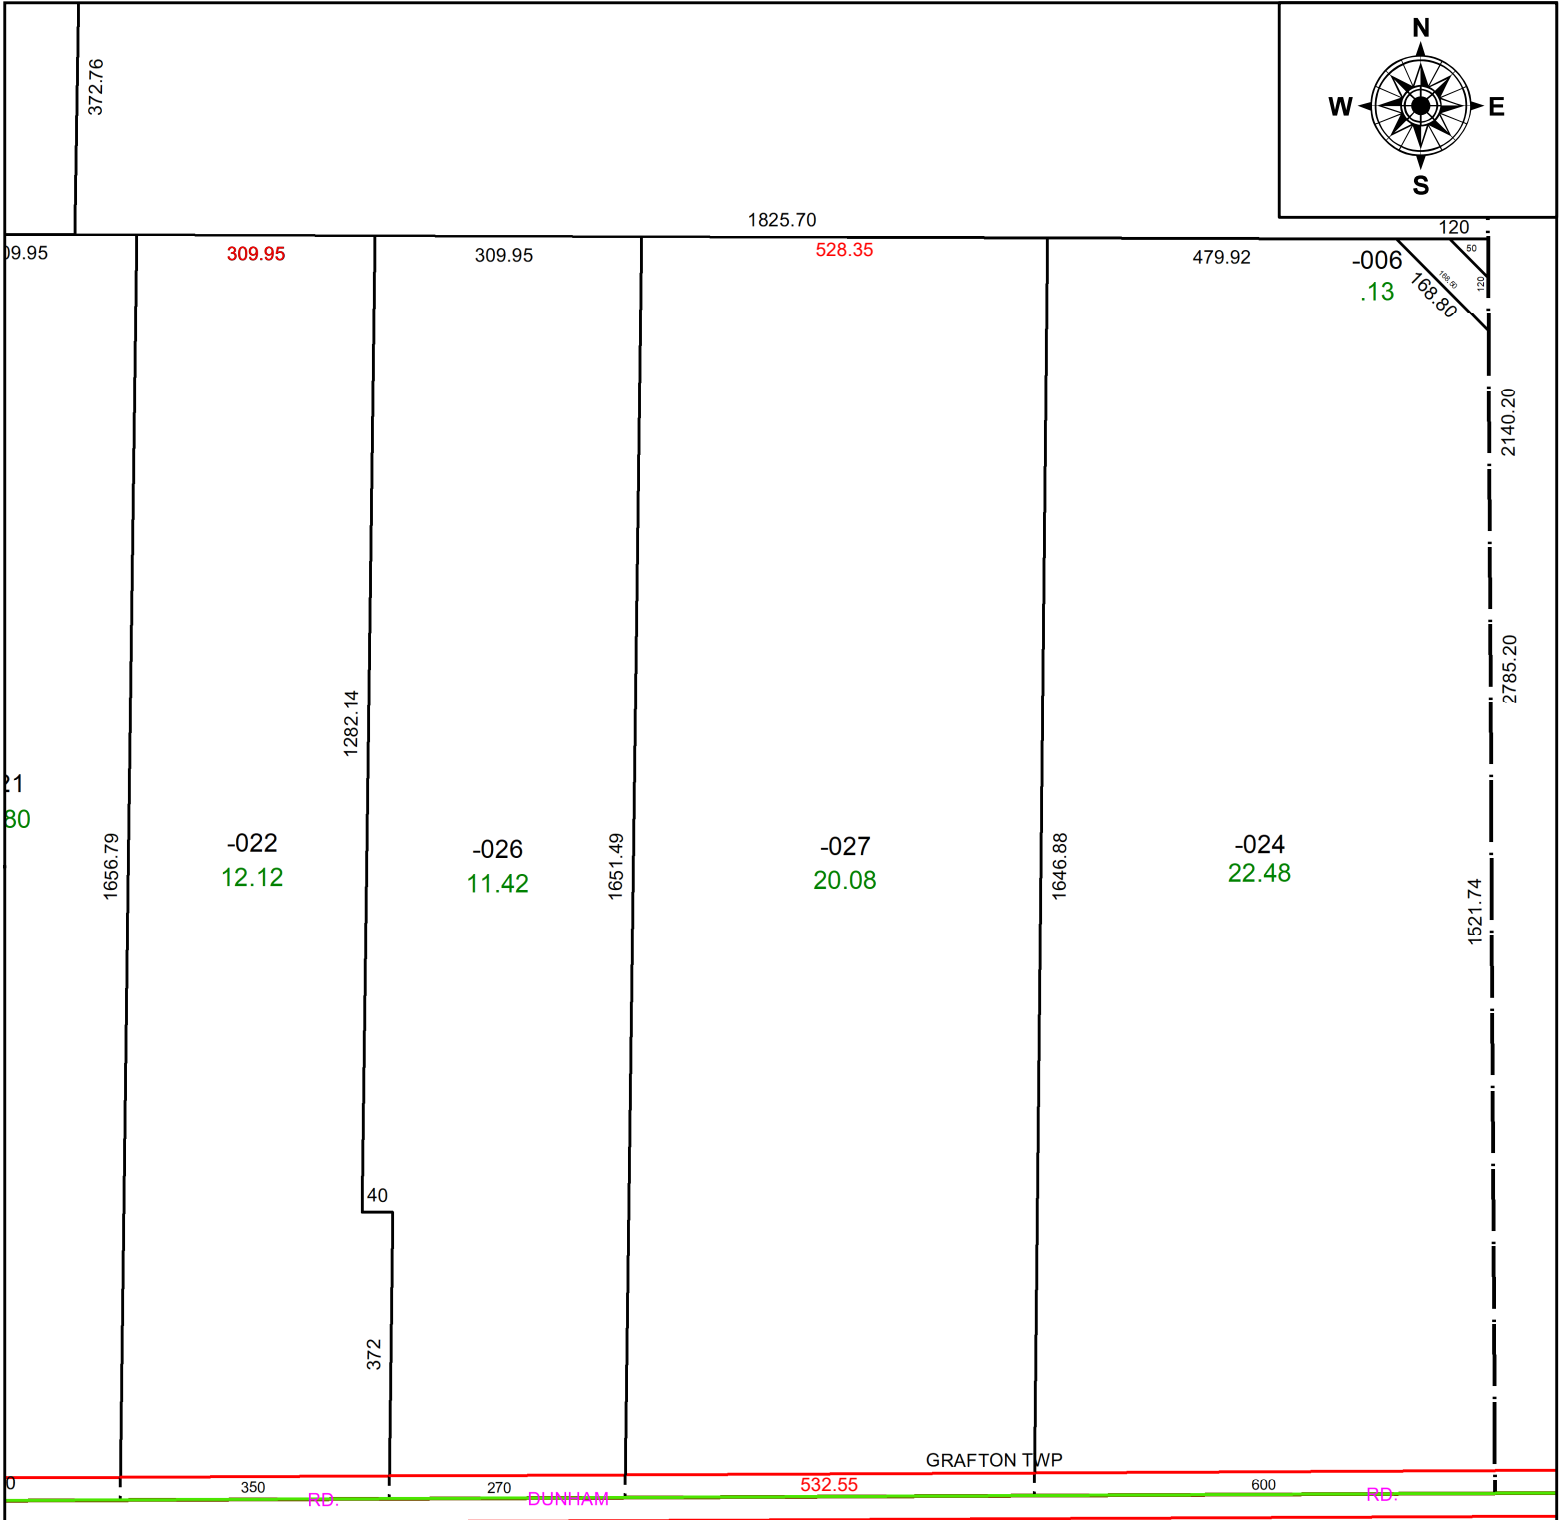

**SPLITS/DEEDS PROCESSED**  
 LORAIN COUNTY TAX MAP DEPARTMENT  
 226 MIDDLE AVE. ELYRIA, OH

**SURVEYED BY:** DOUGLAS S. JEWEL **SURV # 50736**  
**CLOSURE:** 1: 4881468  
**MAP PAGE(S):** 16-00-094  
**APPROVED BY:** AC **DATE:** November 08, 2022  
**SCALE:** 1 in = 250 ft **PRIOR INSTRUMENT:** 2011- 0364852