
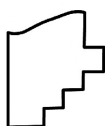
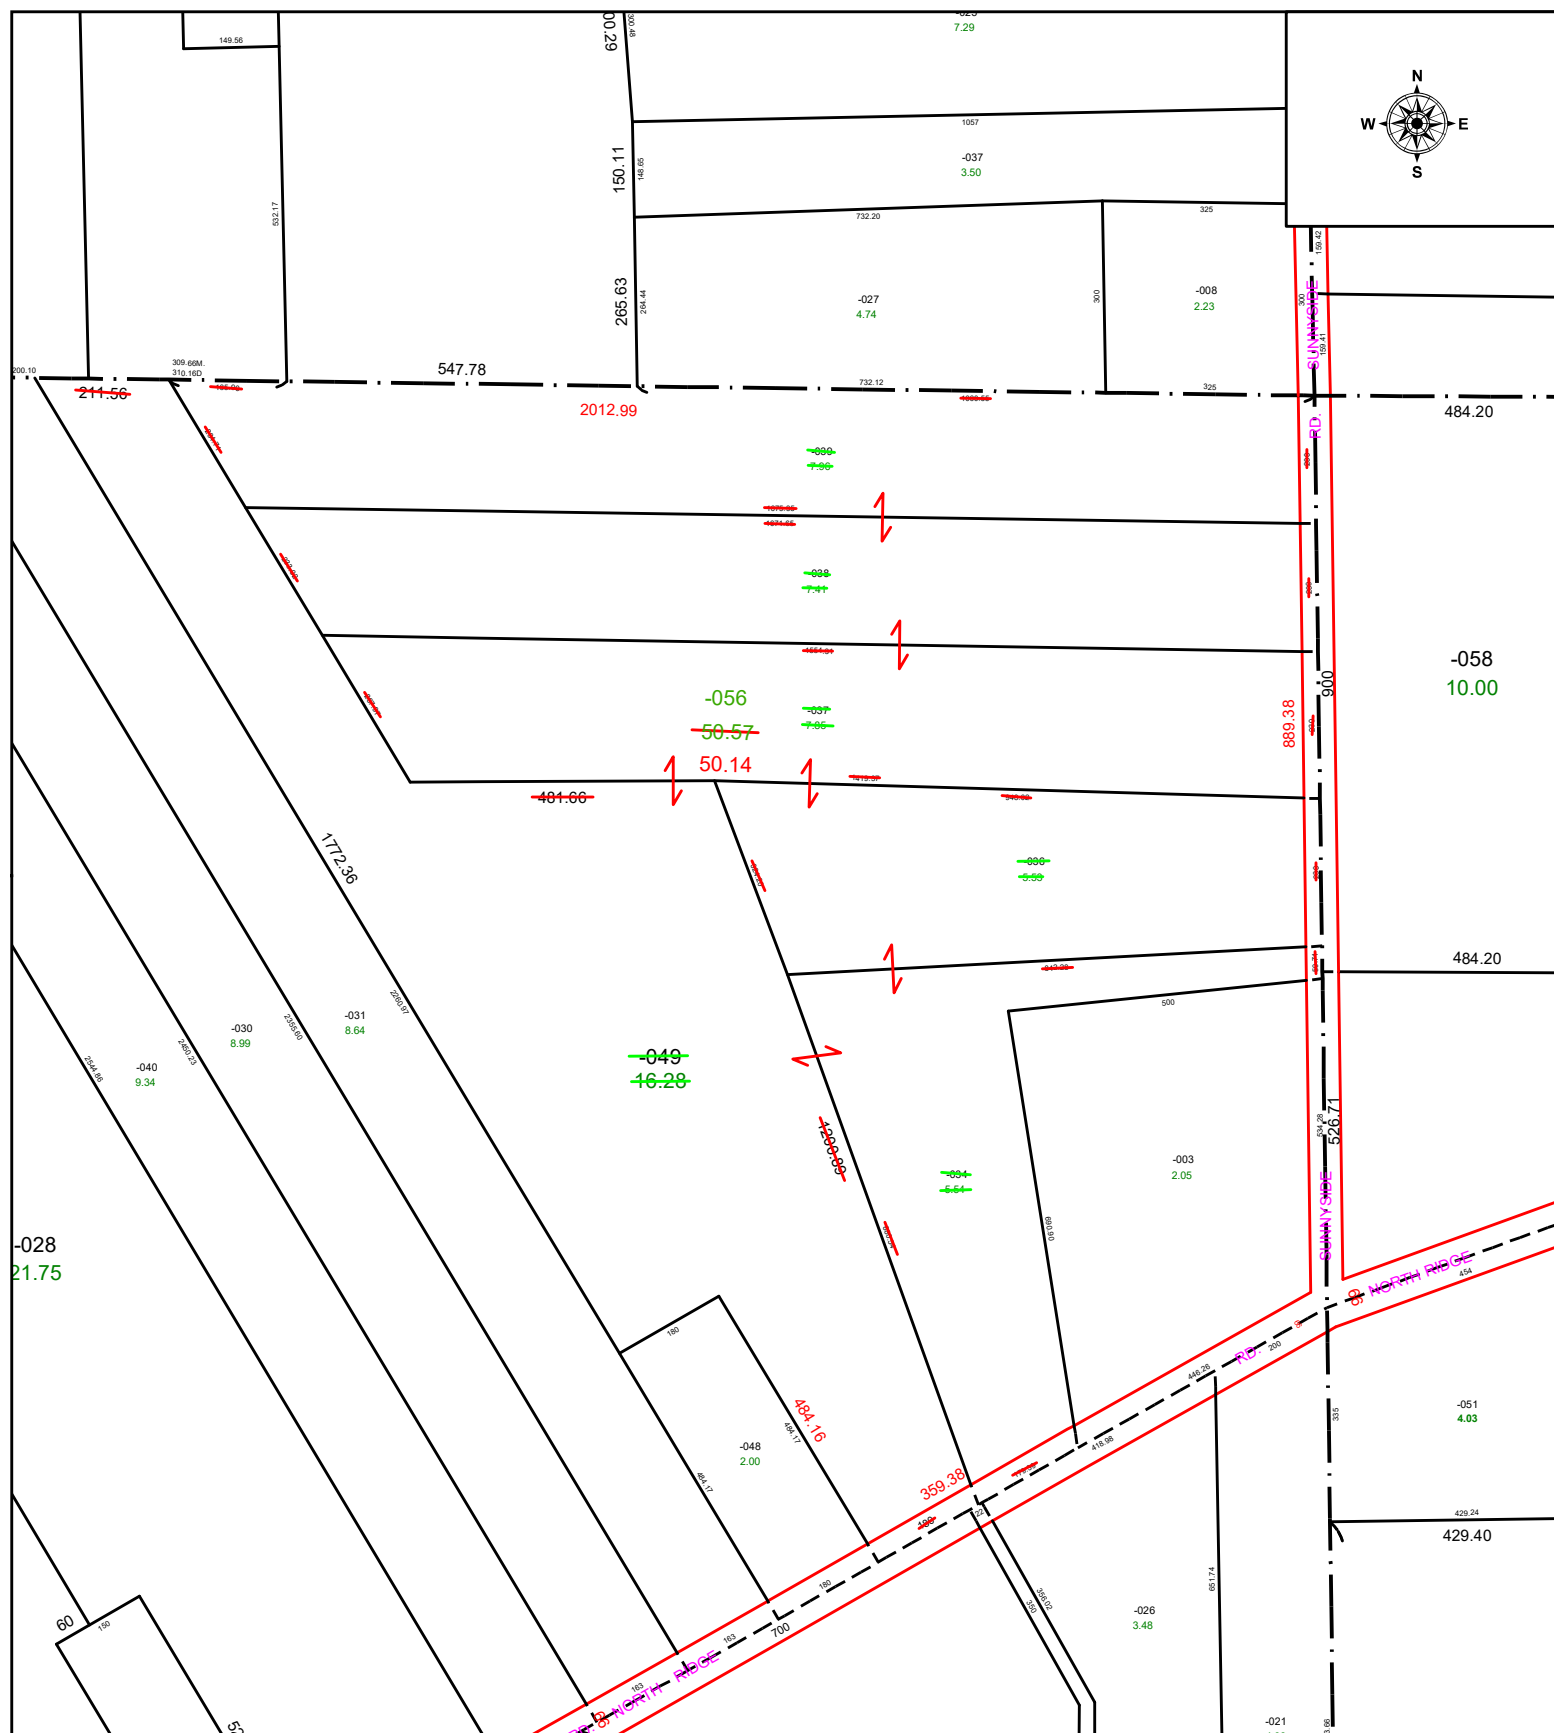


STARTING POINT: MAG NAIL @ INTERSECTION OF C/LS OF SUNNYSIDE RD & NORTH RIDGE RD

25-04979

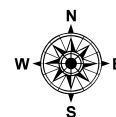

LORAIN COUNTY TAX MAP DEPARTMENT
226 MIDDLE AVE. ELYRIA, OH

SURVEY # 51395

MAP PAGE(S): 01-00-045

APPROVED BY: WRZ **DATE:** 2/20/2025

SCALE: 1" = 300 **PRIOR INSTRUMENT:** #2013-090781