


PARENT PARCEL: 10-00-004-132-020

CHILD PARCEL: **AC. CORR. PER SURVEY THOMAS SIMON**

STARTING POINT: CL OF CHESTNUT RIDGE RD. & EAST RIVER RD.

22-04980-A

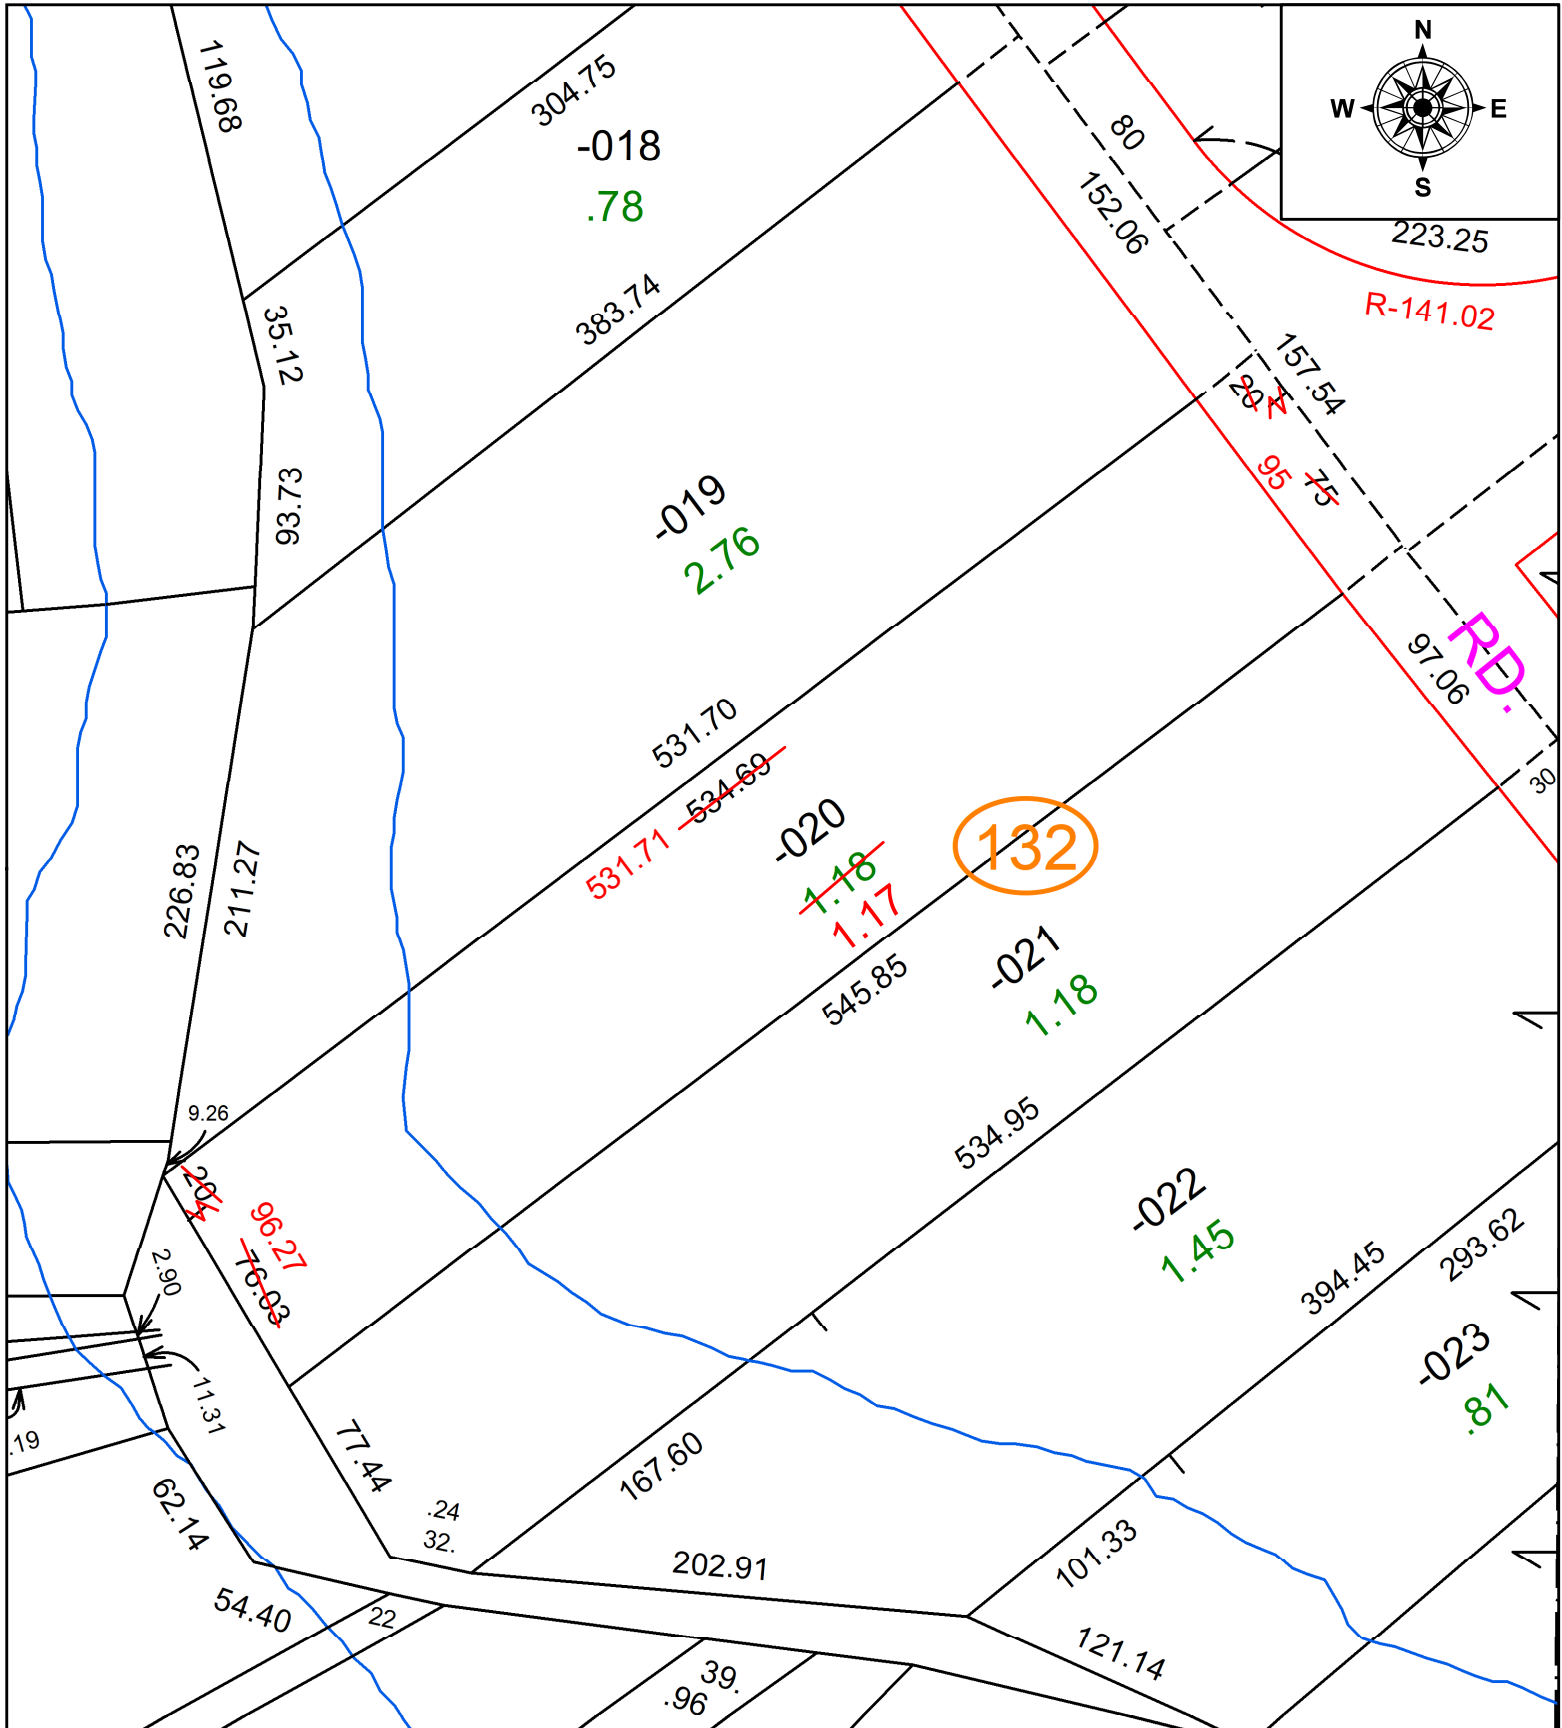

**SPLITS/DEEDS PROCESSED**  
 LORAIN COUNTY TAX MAP DEPARTMENT  
 226 MIDDLE AVE. ELYRIA, OH

SURVEYED BY:	THOMAS SIMON	SURVEY #:	50737
CLOSURE:	1:301809		
MAP PAGE(S):	10-00-004		
APPROVED BY:	DMA	DATE:	11/9/2022
SCALE:	1" = 75'	PRIOR INSTRUMENT:	2019-0728351