
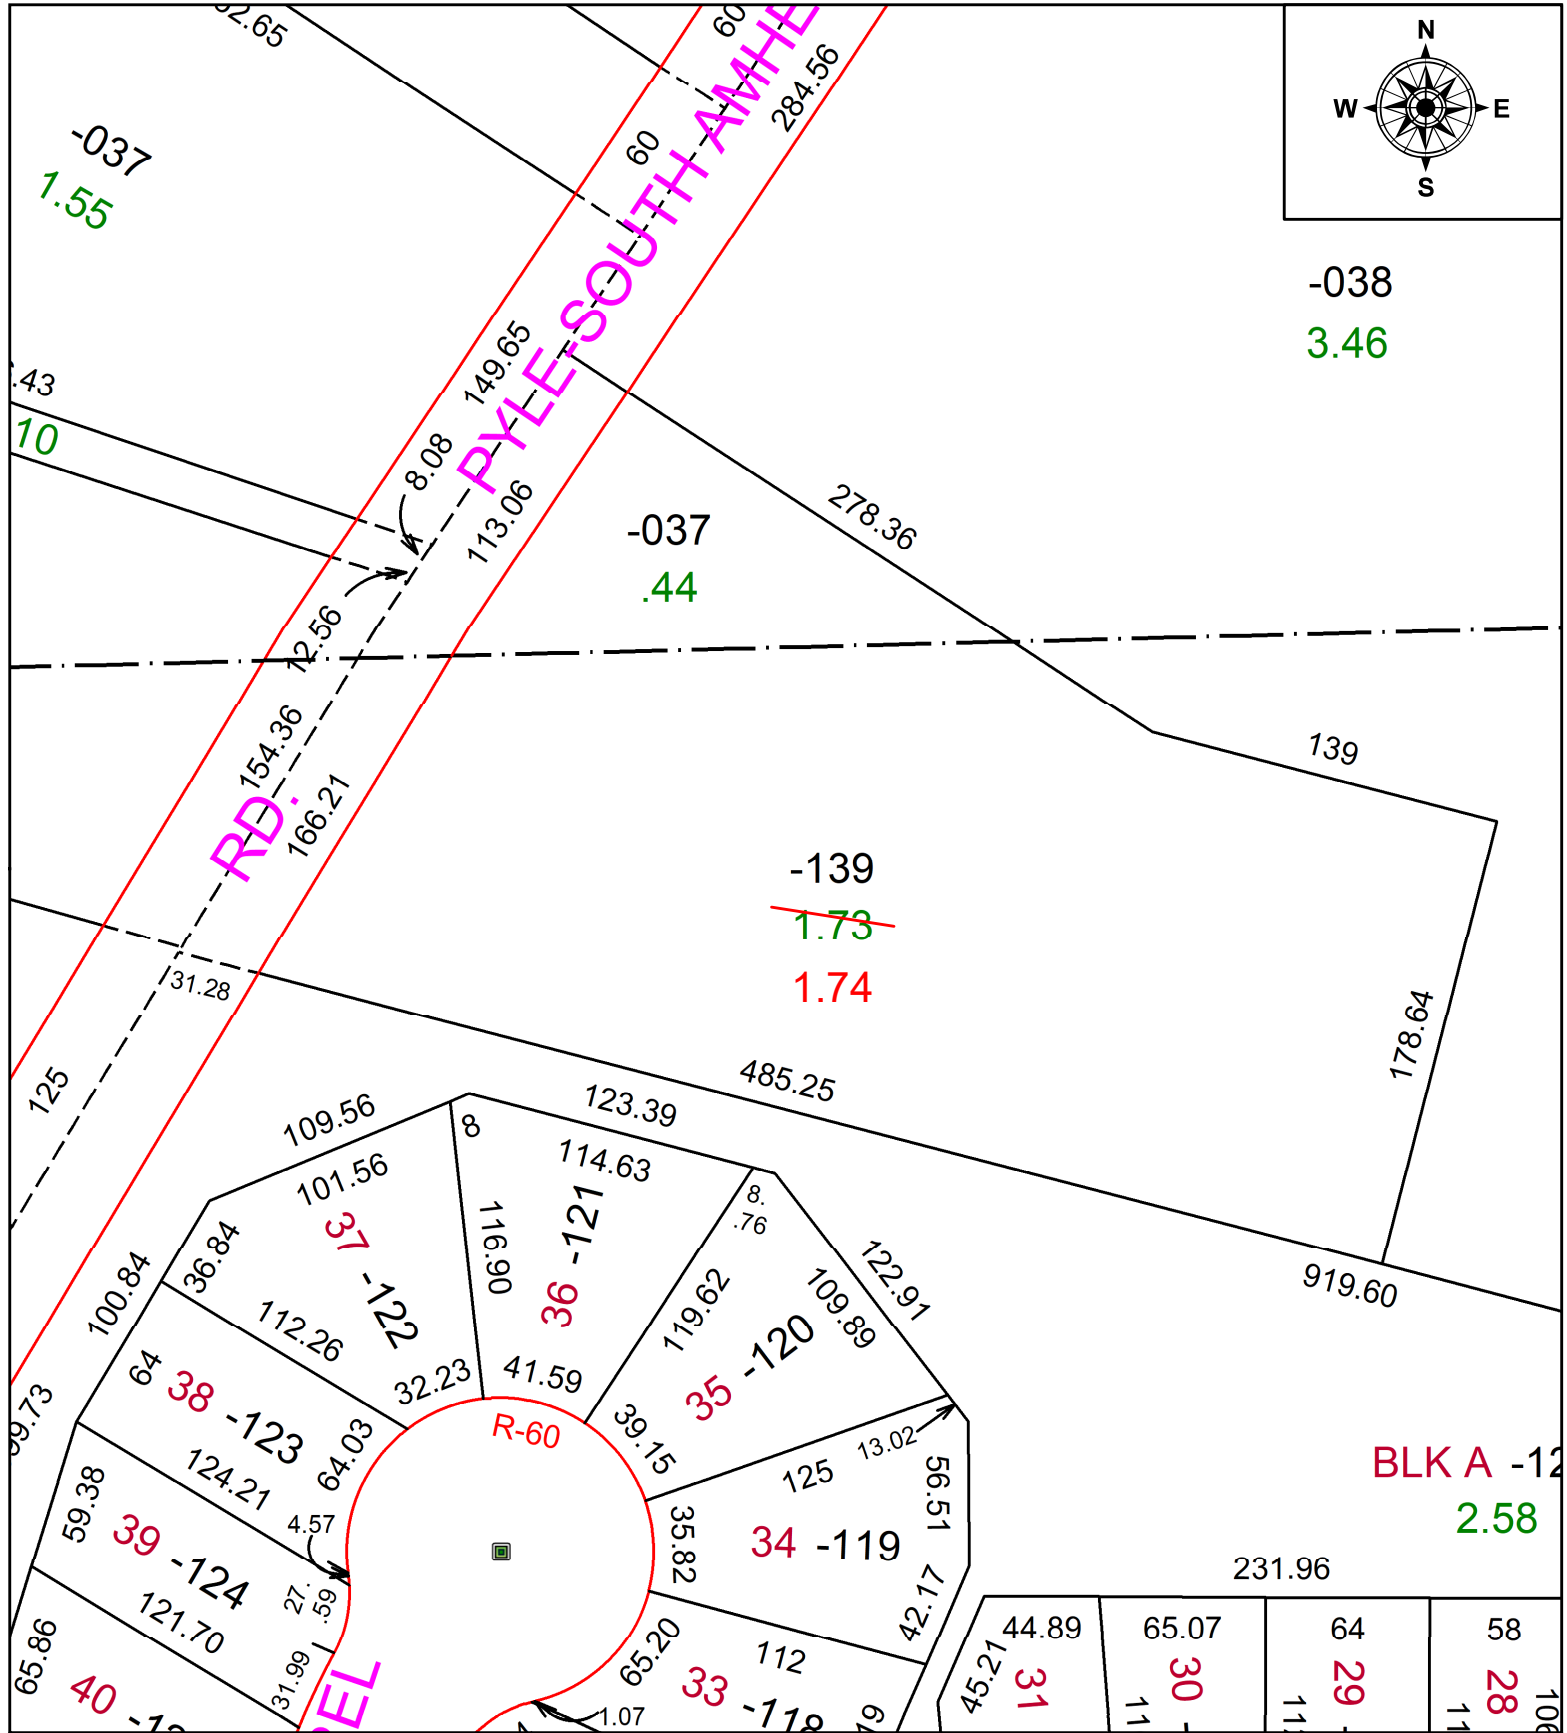


PARENT PARCEL: 05-00-015-000-139

CHILD PARCEL: **AC. CORR. PER PRIOR INSTRUMENT # 2022-0896785**

STARTING POINT: N/A

22-04981-A

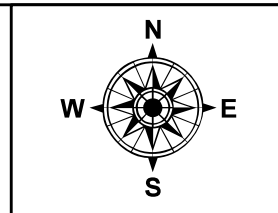

**SPLITS/DEEDS PROCESSED**  
LORAIN COUNTY TAX MAP DEPARTMENT  
226 MIDDLE AVE. ELYRIA, OH

SURVEYED BY: N/A SURVEY #: N/A  
CLOSURE: N/A  
MAP PAGE(S): 05-00-0105  
APPROVED BY: DMA DATE: 11/9/2022  
SCALE: 1" = 75' PRIOR INSTRUMENT: 2022-0896785