
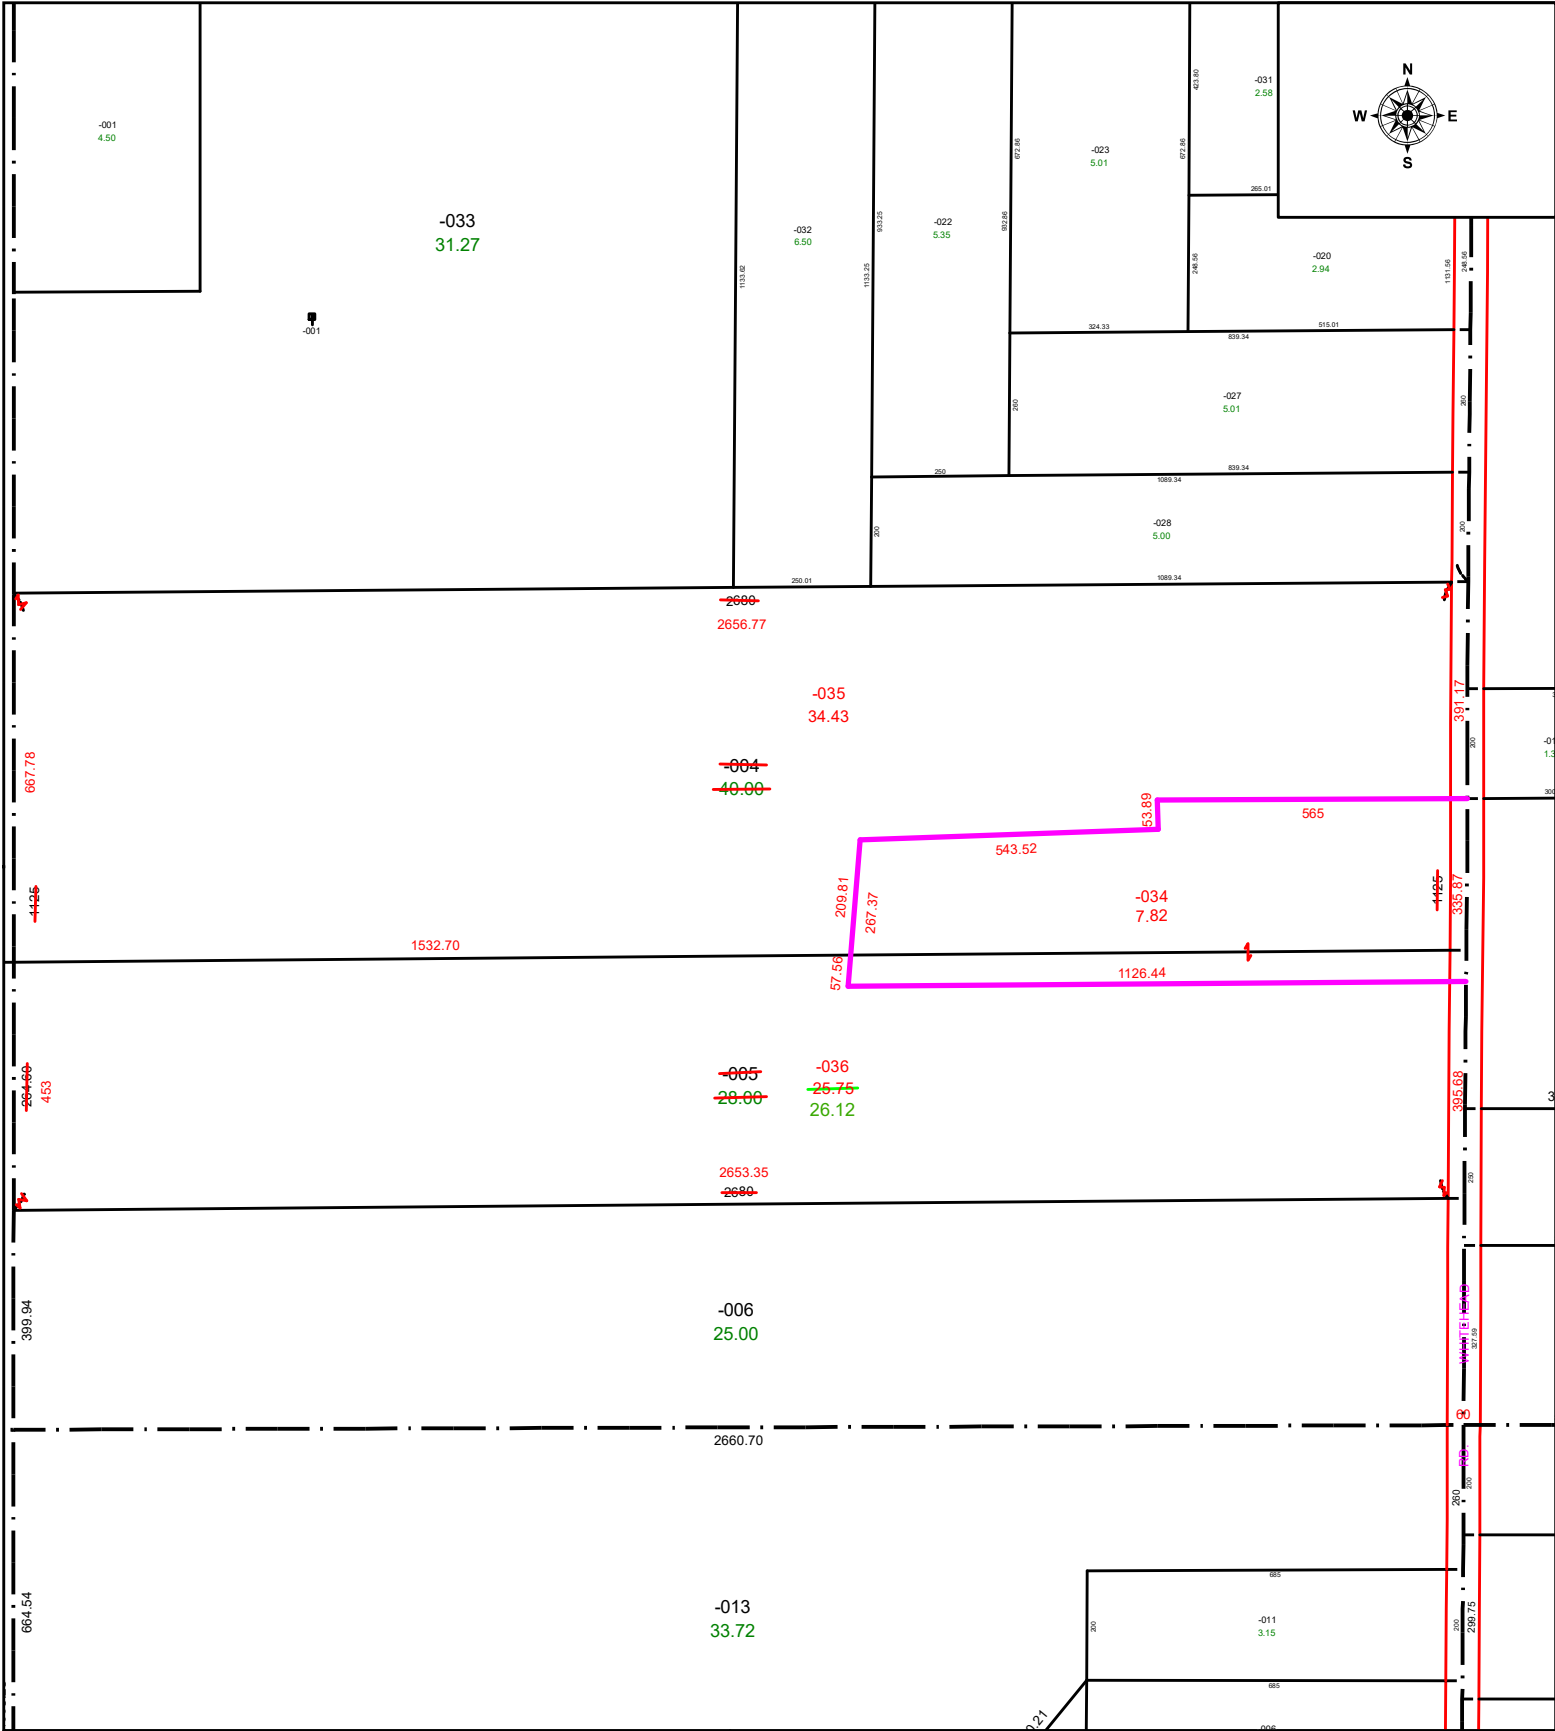


PARENT PARCEL: 15-00-003-000-004 & -005
CHILD PARCEL: 15-00-003-000-034, -035, & -036
STARTING POINT: MONUMENT BOX @ SOUTHEASTERLY CORNER OF O.L. 3 & C/L OF WHITEHEAD RD

25-04986

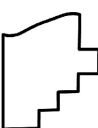

**SPLITS/DEEDS PROCESSED**
LORAIN COUNTY TAX MAP DEPARTMENT
226 MIDDLE AVE. ELYRIA, OH

SURVEYED BY: THOMAS SIMON SURVEY # 51410
CLOSURE: 1: 747685
MAP PAGE(S): 15-00-003
APPROVED BY: WRZ DATE: 3/13/2025
SCALE: 1" = 350 PRIOR INSTRUMENT: #2023-0909033