
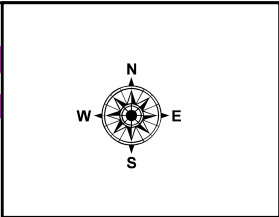
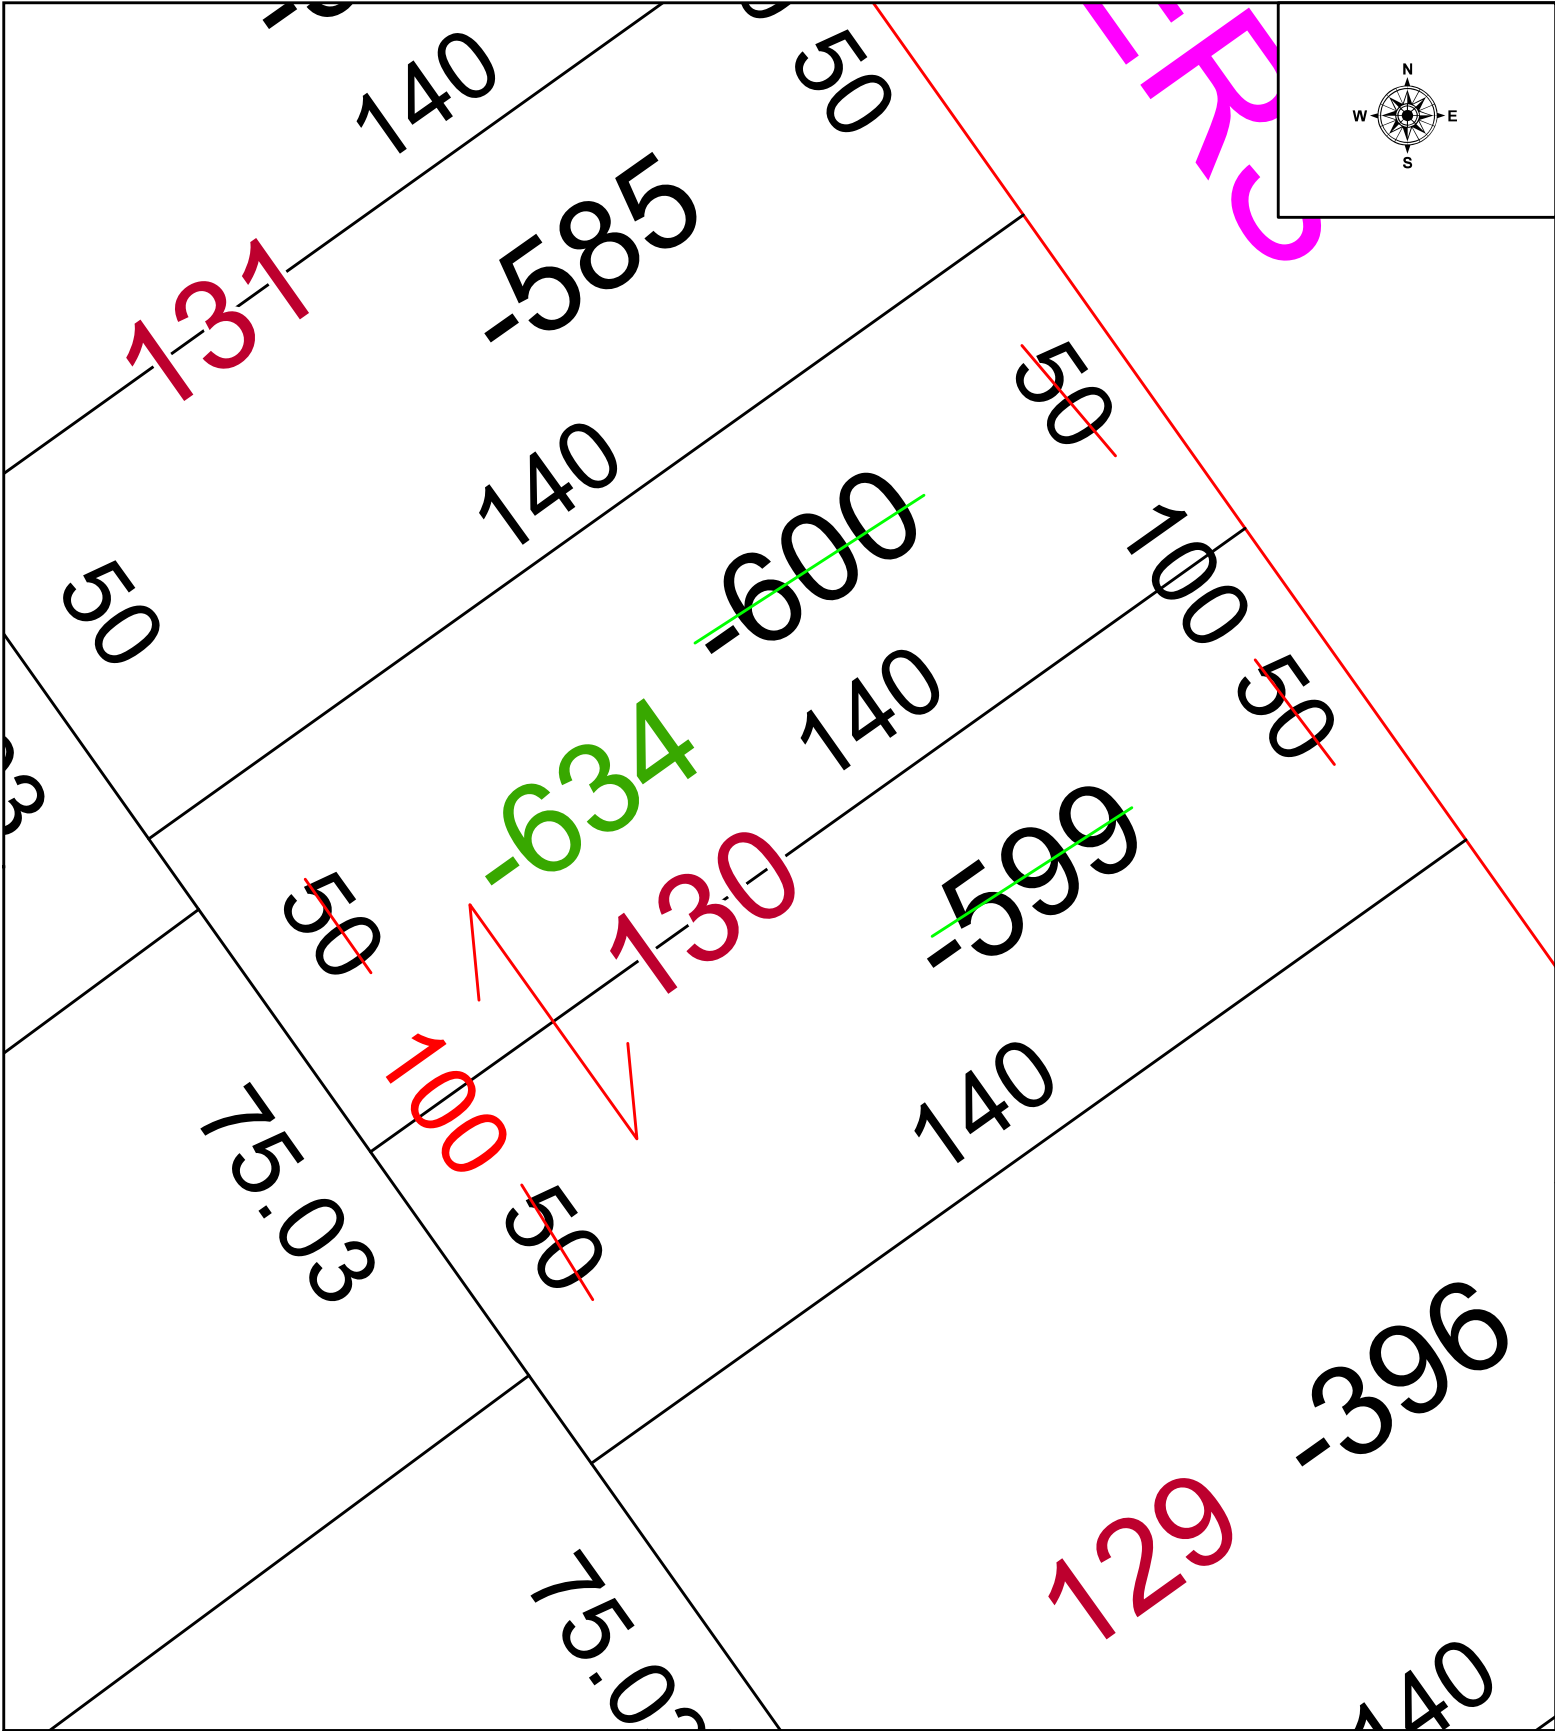


PARENT PARCEL: 10-00-005-101-599 & -600
CHILD PARCEL: 10-00-005-101-634
STARTING POINT:

25-04988

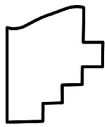


SPLITS/DEEDS PROCESSED
LORAIN COUNTY TAX MAP DEPARTMENT
226 MIDDLE AVE. ELYRIA, OH

SURVEYED BY: N/A SURVEY # N/A
CLOSURE: 1: N/A
MAP PAGE(S): 10-00-005
APPROVED BY: WRZ DATE: 3/14/2025
SCALE: 1" = 25 PRIOR INSTRUMENT: #2004-0996071