



PARENT PARCEL: 15-00-071-000-004
CHILD PARCEL: 15-00-071-000-021 THRU -026
STARTING POINT: INTERSECTION OF C/L OF VERMONT ST & SOUTHERLY LINE OF O.L. 71

25-04989

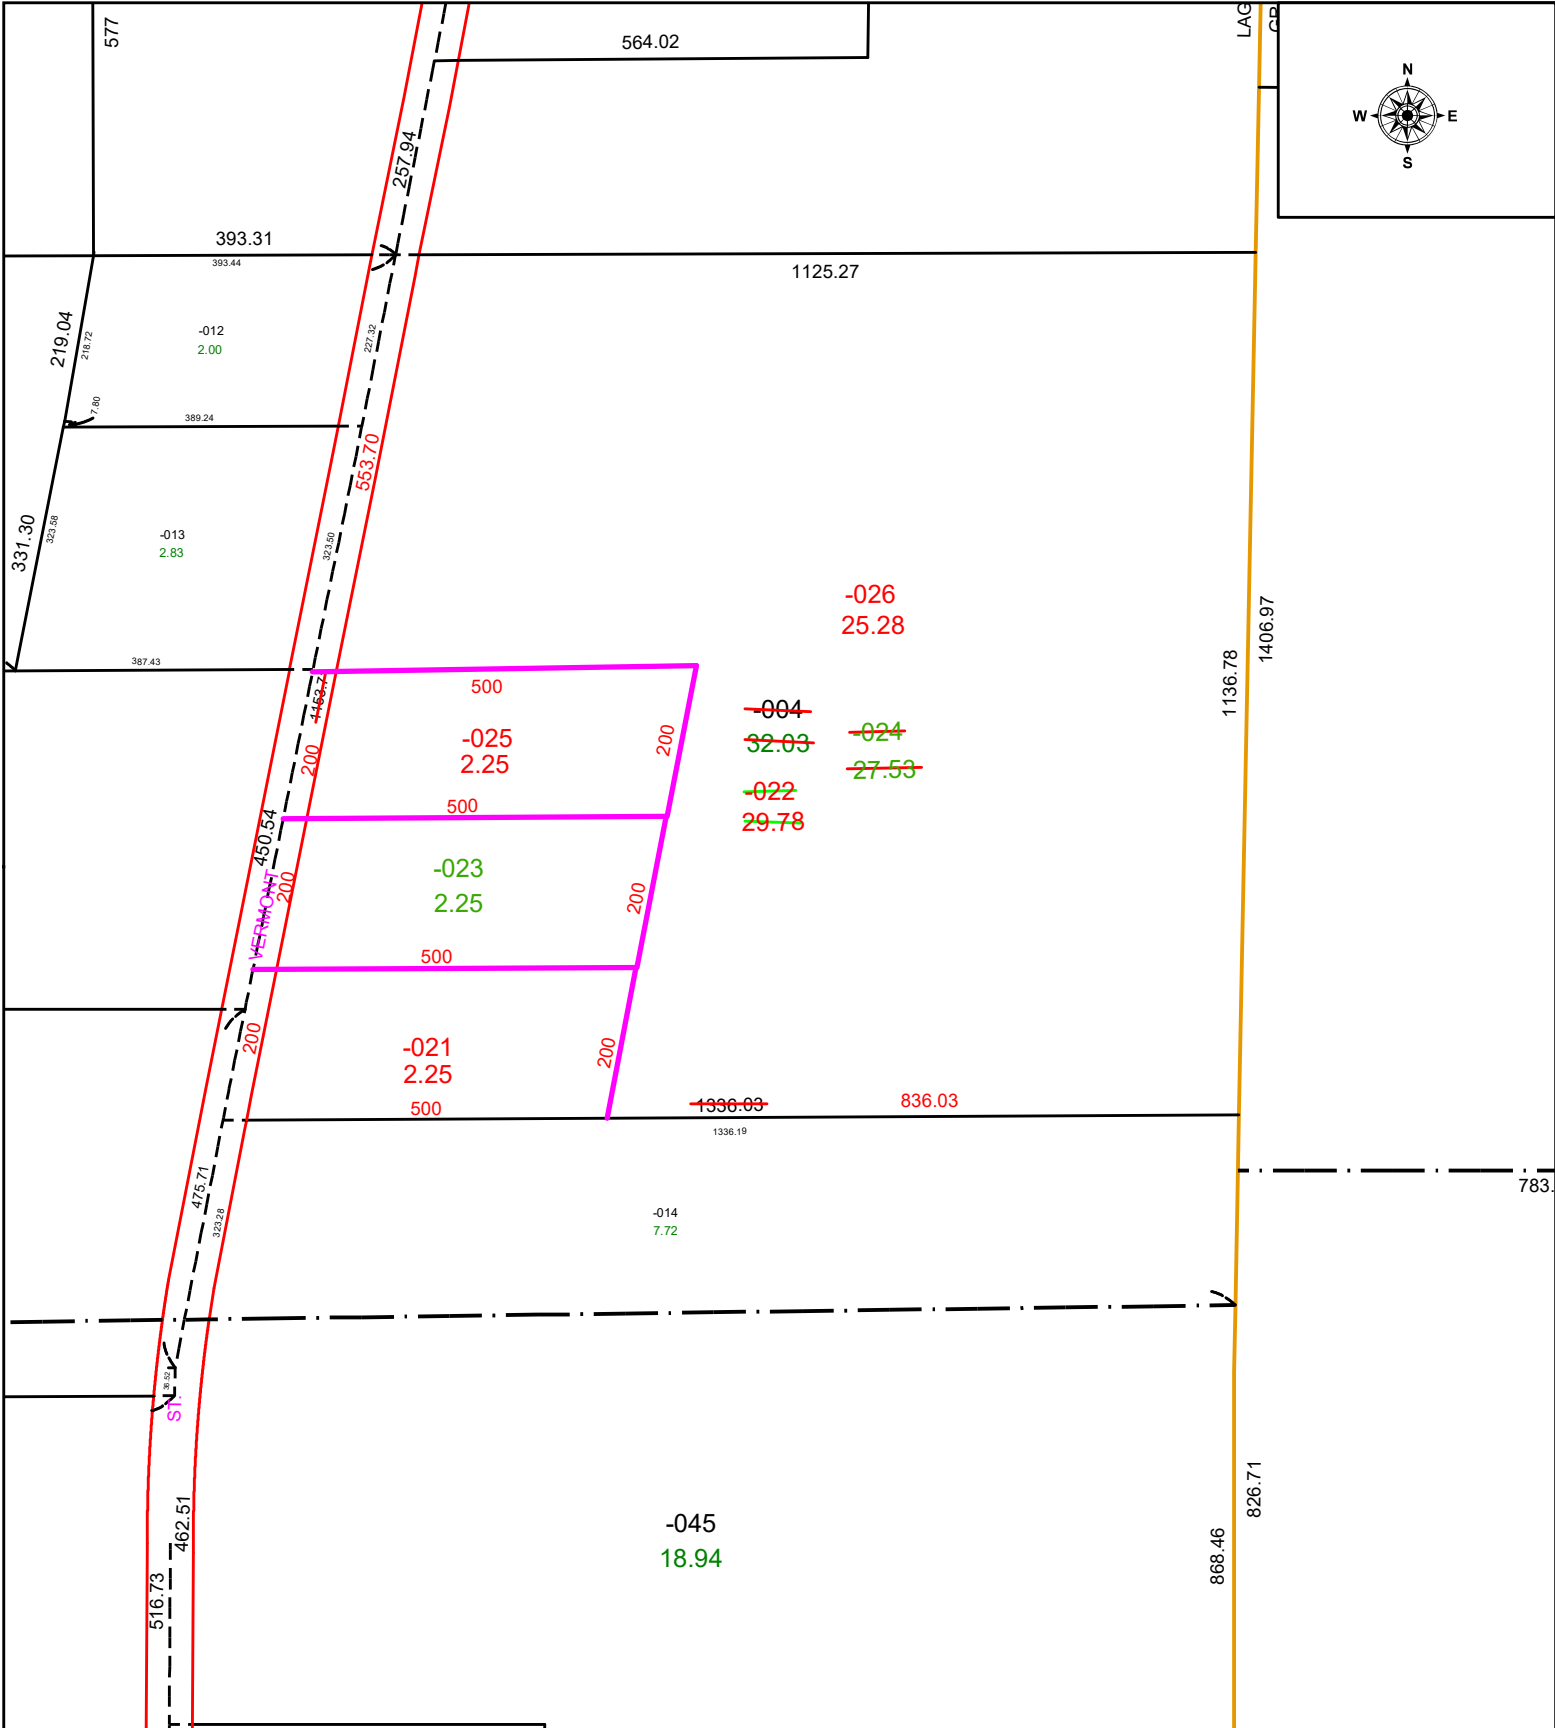

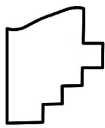

SPLITS/DEEDS PROCESSED
LORAIN COUNTY TAX MAP DEPARTMENT
226 MIDDLE AVE. ELYRIA, OH

SURVEYED BY:	JOSHUA RIEDY	SURVEY #	51411
CLOSURE:	1: INF		
MAP PAGE(S):	15-00-071		
APPROVED BY:	WRZ	DATE:	3/19/2025
SCALE:	1" = 250	PRIOR INSTRUMENT:	#2023-0936639