


PARENT PARCEL: 19-01-021-000-004, 19-01-022-000-003, 19-01-023-000-003, 19-01-025-000-011, 19-01-026-002 & -007
CHILD PARCEL: 19-01-021-000-014, 19-01-022-000-011, 19-01-026-000-008, & ST: 19-01-022-000-003 19-01-025-000-011
STARTING POINT: AC CORR PER SURV BY JOHNATHAN A. EASTON

25-04990



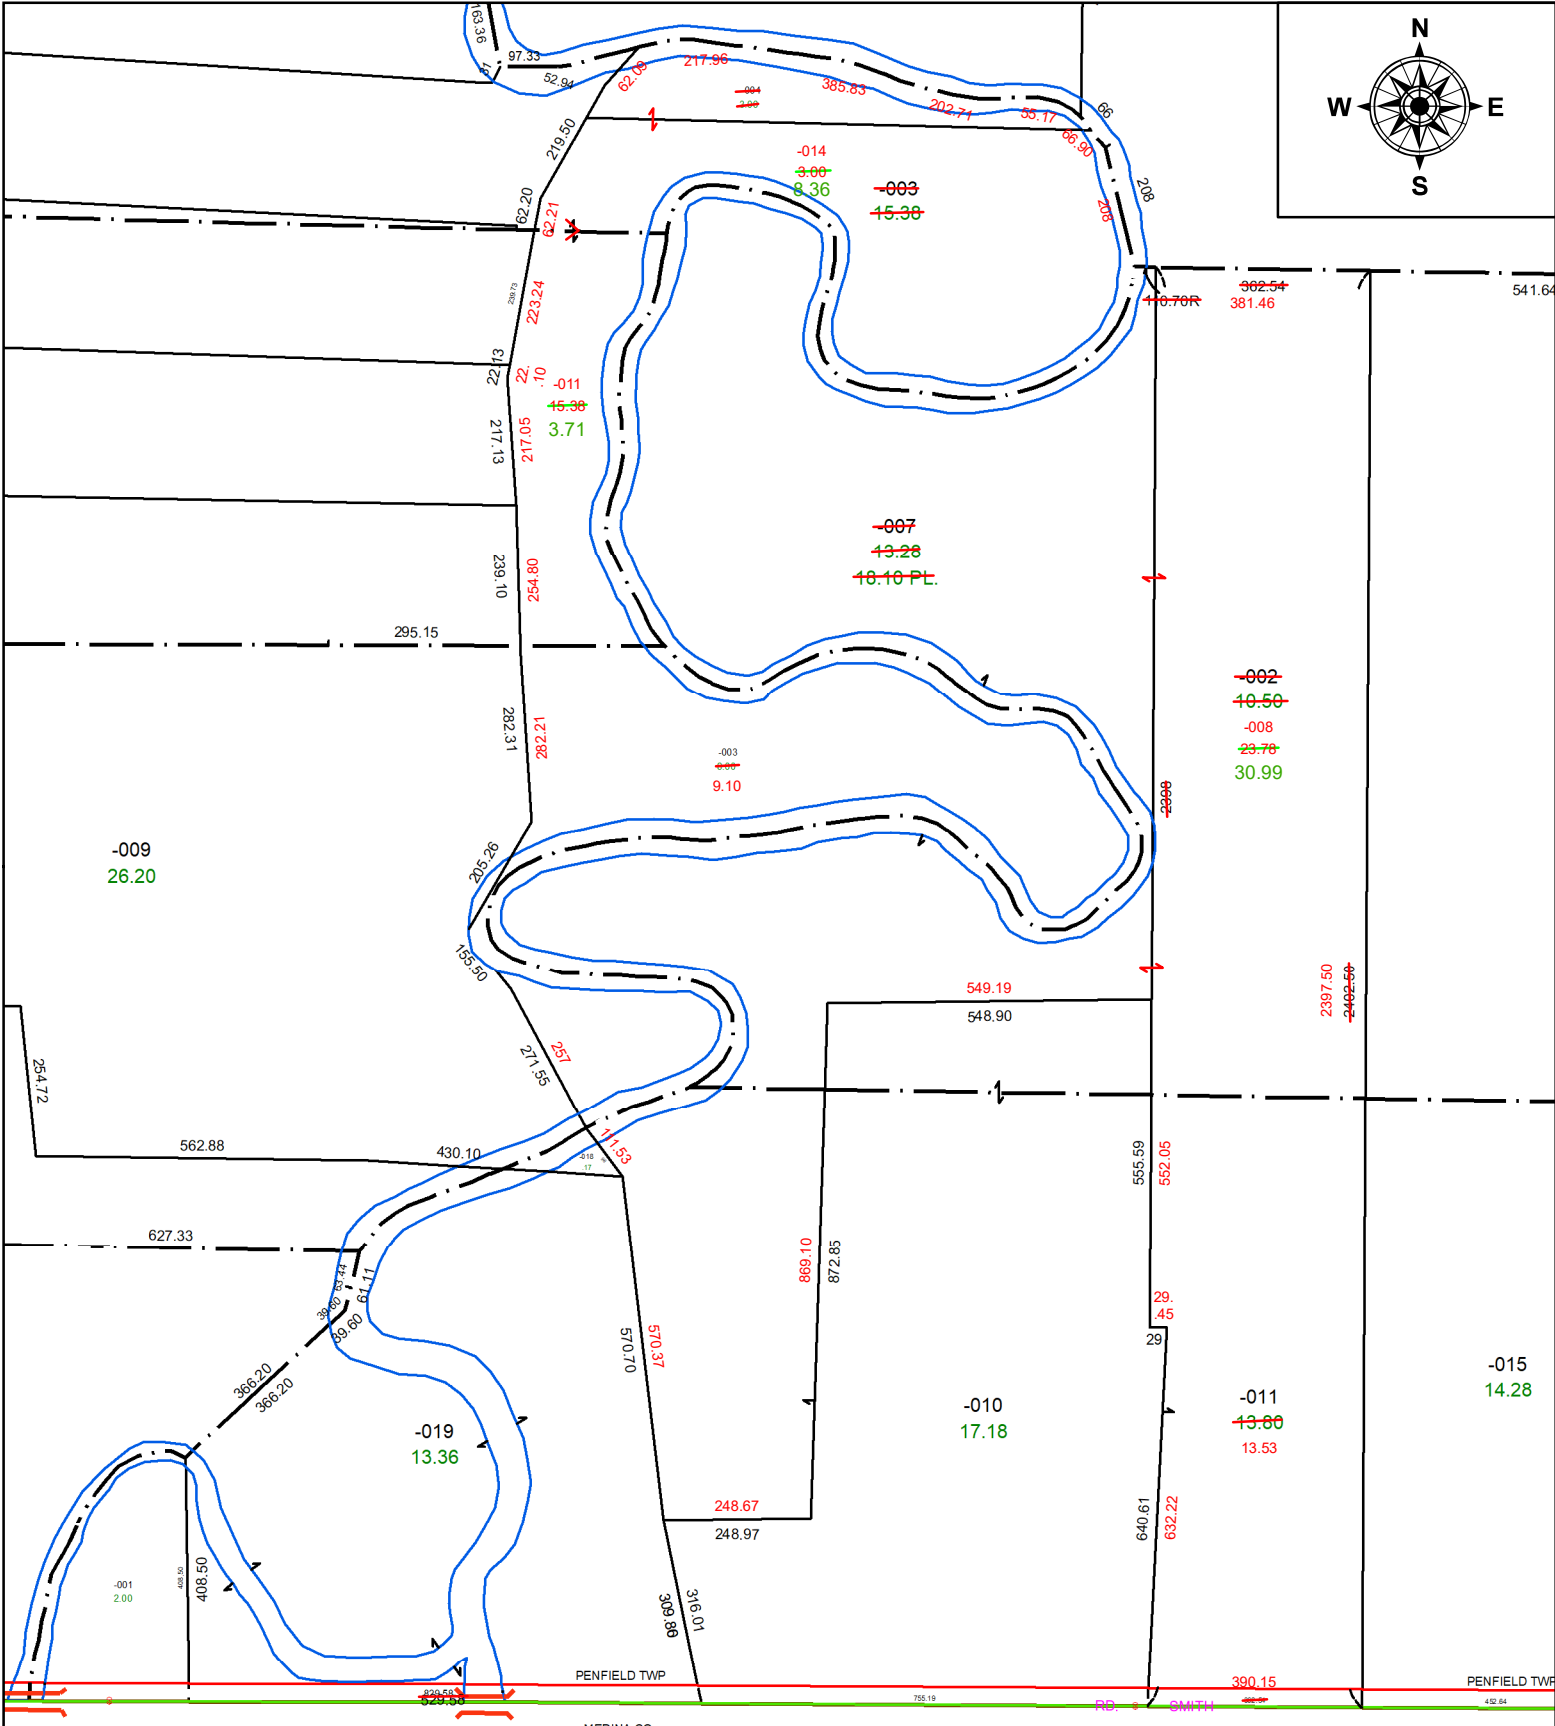

SPLITS/DEEDS PROCESSED
LORAIN COUNTY TAX MAP DEPARTMENT
226 MIDDLE AVE. ELYRIA, OH

SURVEYED BY: JOHNATHAN A. EASTON	SURV # 51422
CLOSURE: 1: 590831	
MAP PAGE(S): 19-01-021	
APPROVED BY: AC	DATE: April 11, 2025
SCALE: 1 in = 325 ft	PRIOR INSTRUMENT: 2016- 0576539