
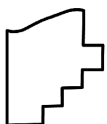


PARENT PARCEL: 09-00-067-000-010

CHILD PARCEL: **AC CORR PER SURV BY JOHN A. DECHANT JR**

STARTING POINT: C/L OF OBERLIN AND BUTTERNUT RIDGE RD

22-04996-A

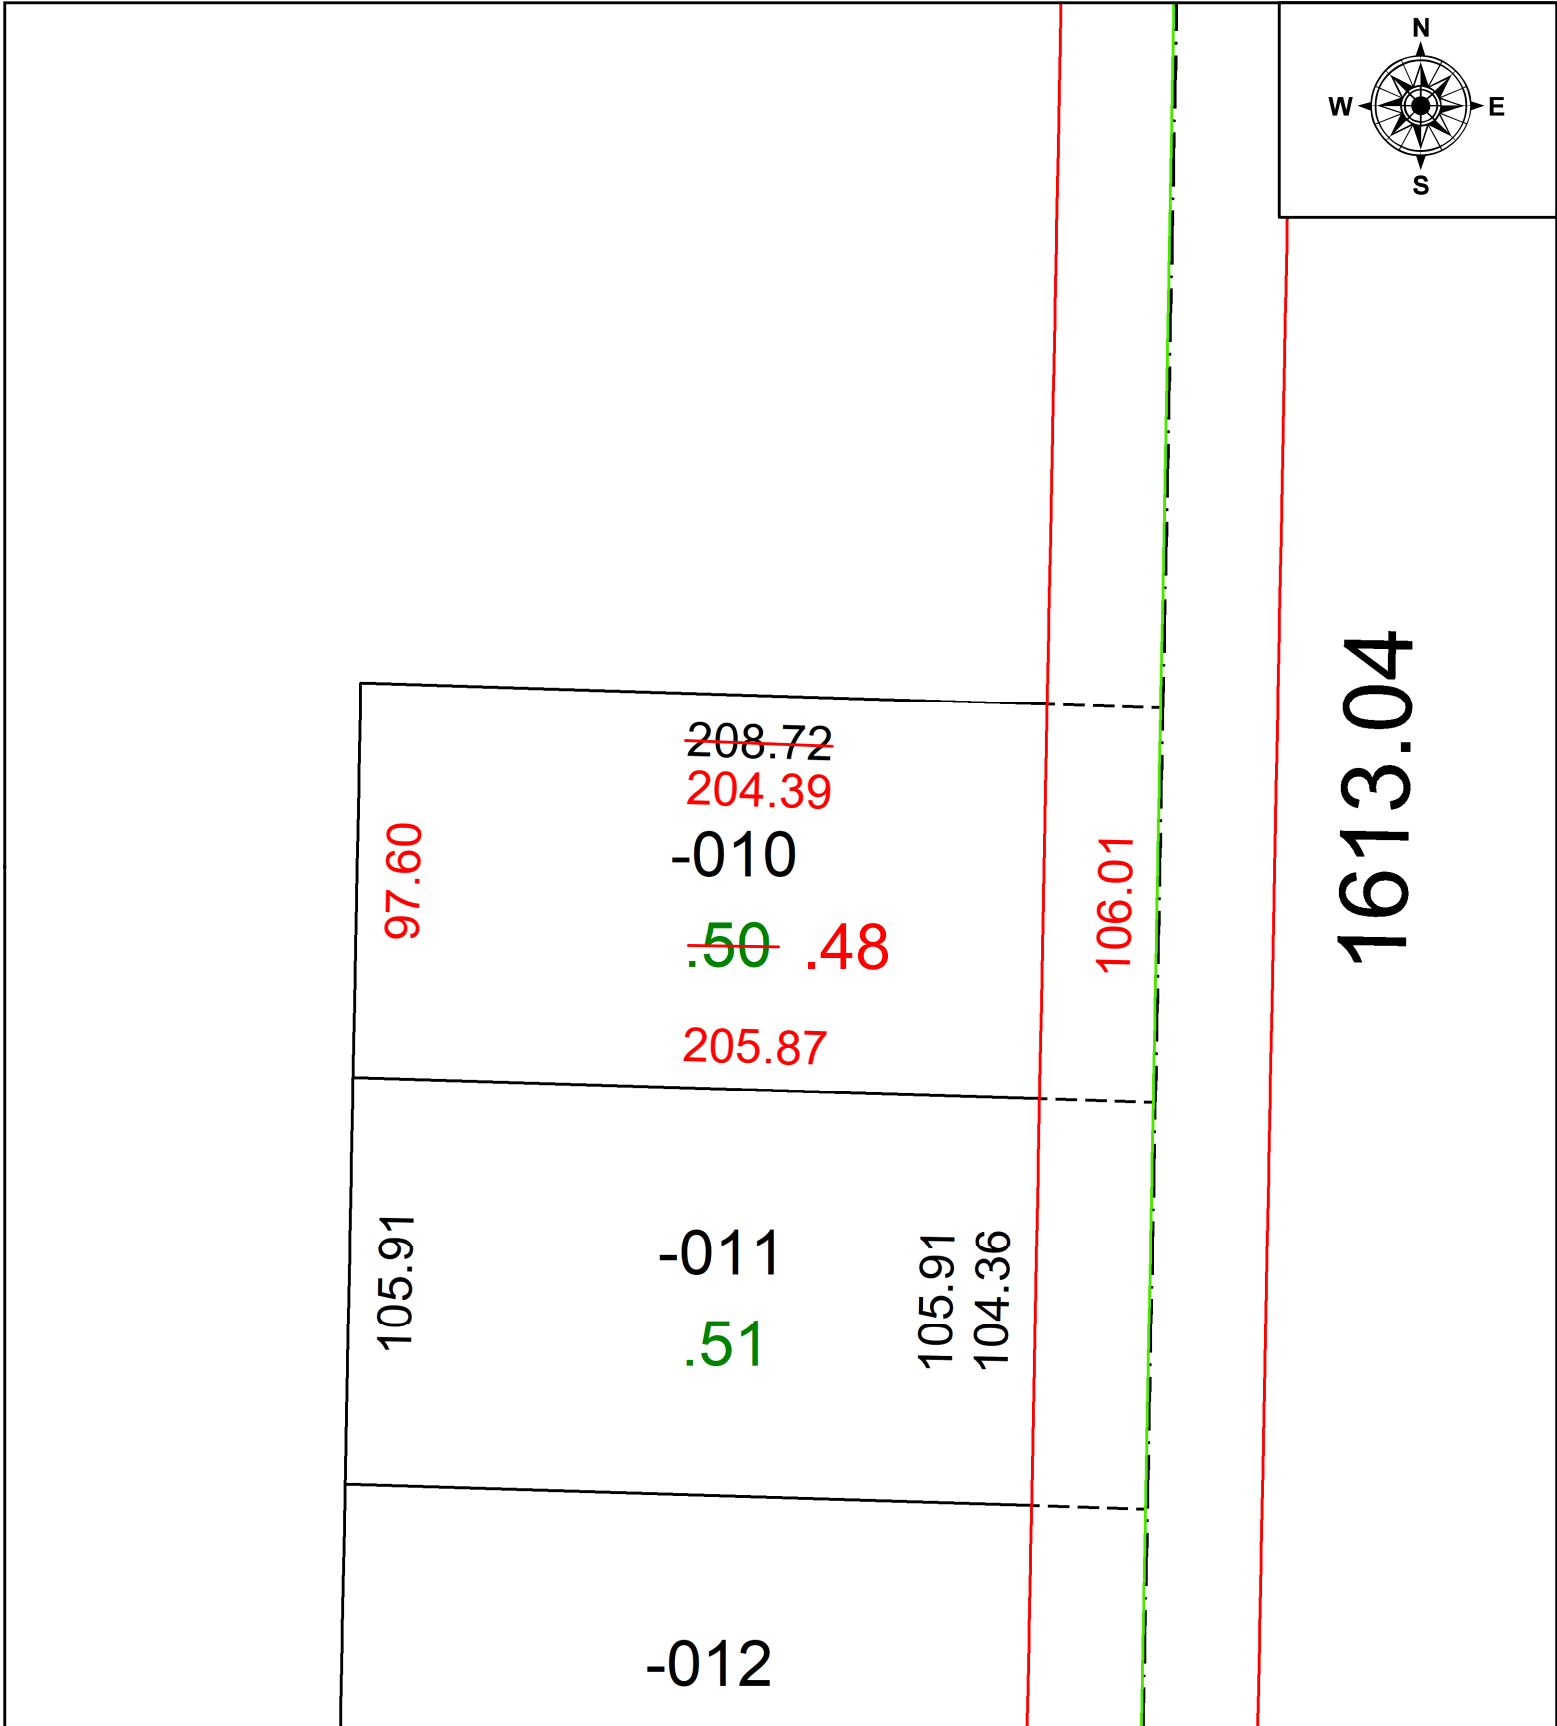

SPLITS/DEEDS PROCESSED
 LORAIN COUNTY TAX MAP DEPARTMENT
 226 MIDDLE AVE. ELYRIA, OH

SURVEYED BY: JOHN A. DECHANT JR. SURV # 50757

CLOSURE: 1: 100789

MAP PAGE(S): 09-00-067-B

APPROVED BY: AC DATE: December 14, 2022

SCALE: 1 in = 50 ft PRIOR INSTRUMENT: 2019- 0734981