


PARENT PARCEL: 12-00-004-000-219 & 12-00-004-900-003
CHILD PARCEL: 12-00-004-000-224, 12-00-017-000-265, 12-00-004-900-005 & -006
STARTING POINT: EMERALD WOODS SUB. NO. 5 PV. 112 PG. 86 UNCOMBIANATION PER TAXING DISTRICT

22-04999-U-1

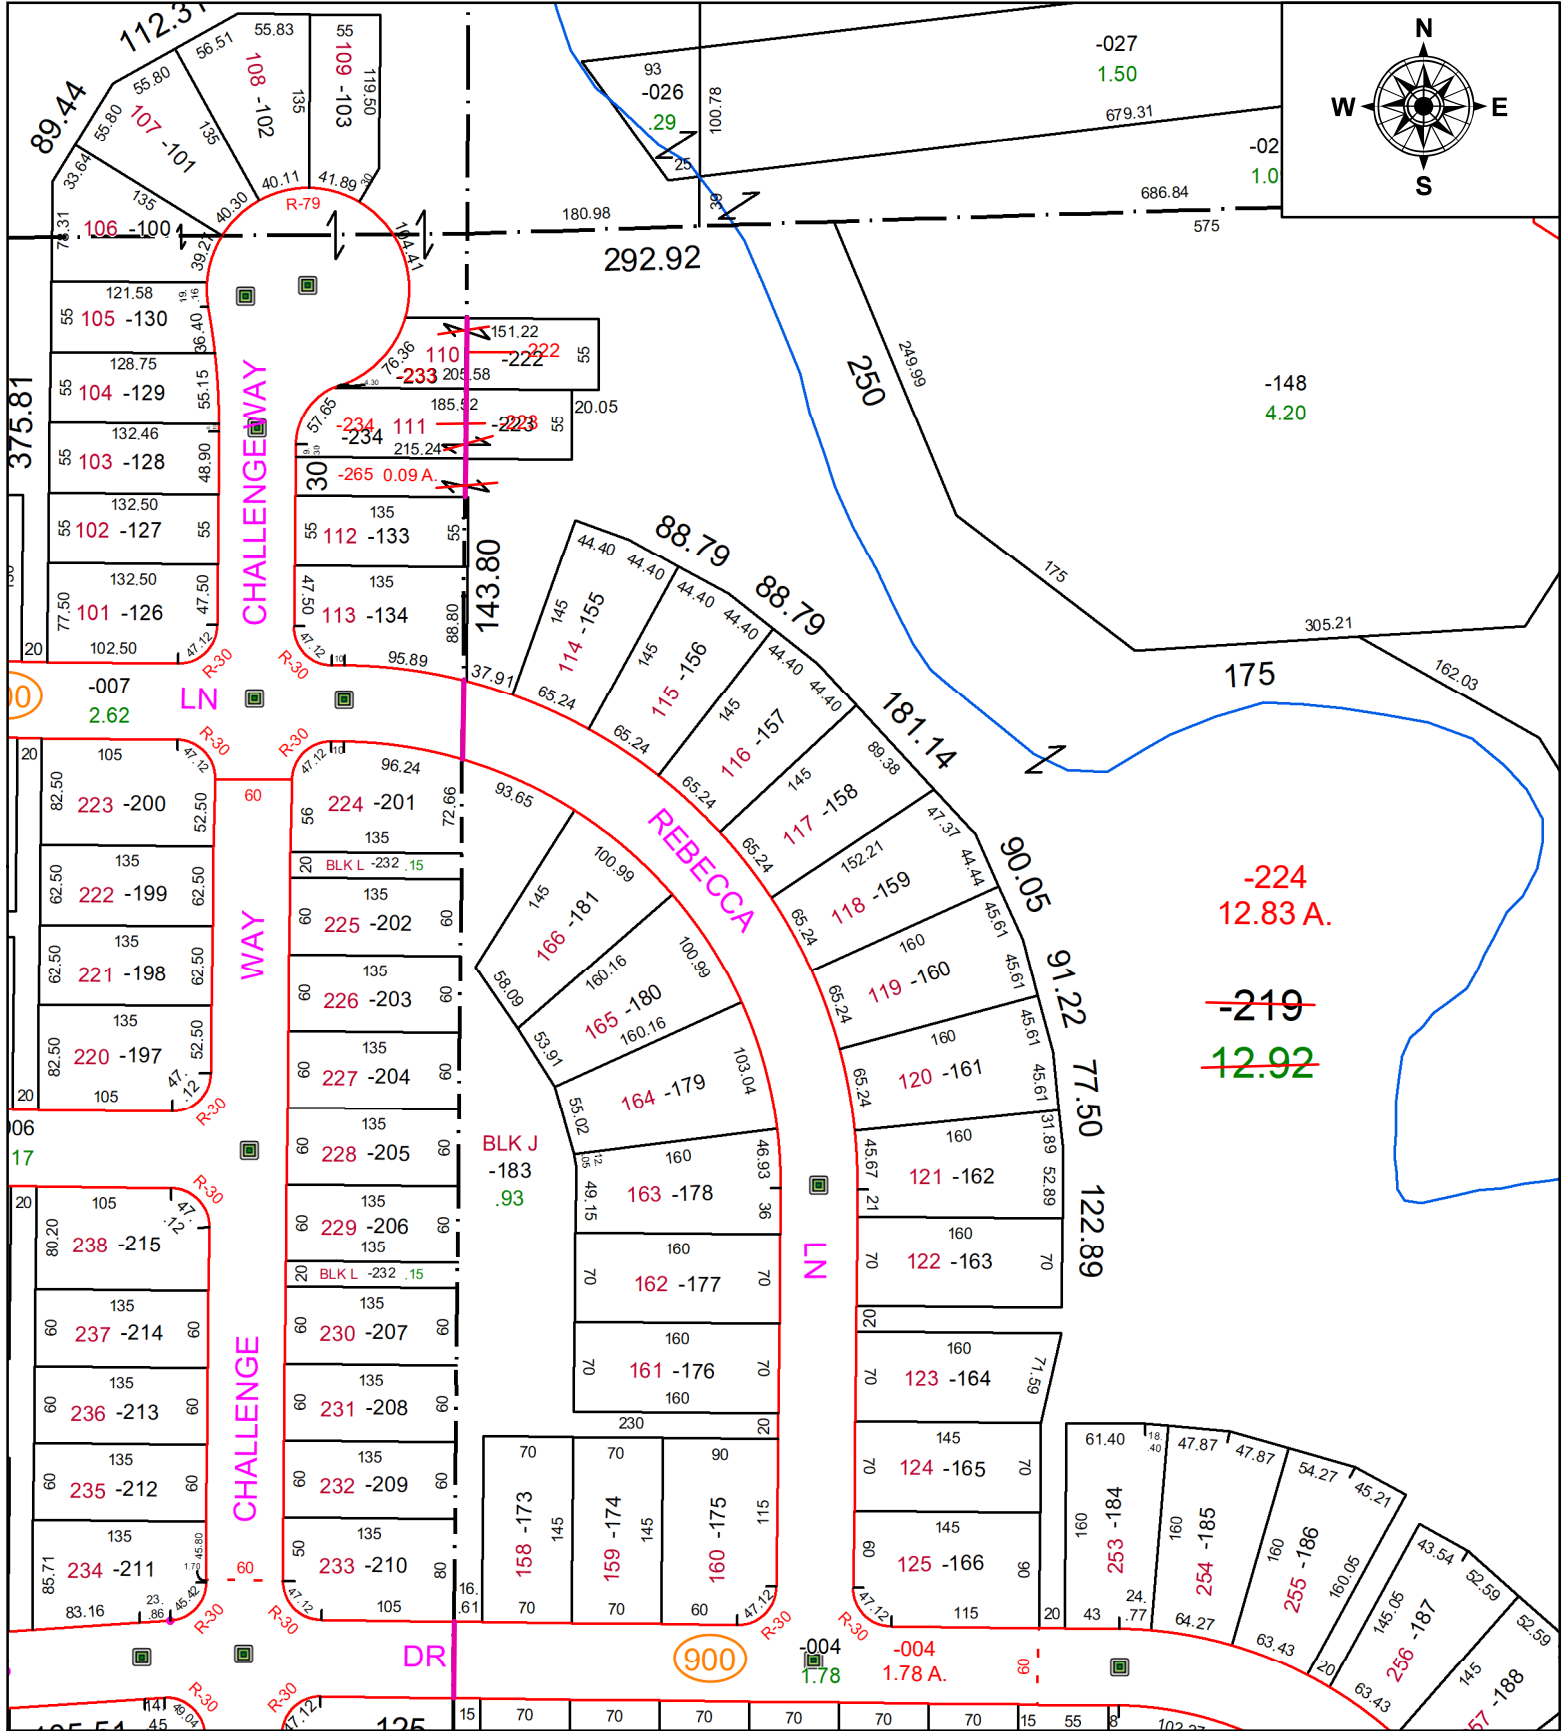

SPLITS/DEEDS PROCESSED
 LORAIN COUNTY TAX MAP DEPARTMENT
 226 MIDDLE AVE. ELYRIA, OH

SURVEYED BY: MICHAEL ACKERMAN
CLOSURE: 1: INF
MAP PAGE(S): 12-00-004 & -017
APPROVED BY: TJS **DATE:** 12/16/2022
SCALE: 1" = 150' **PRIOR INSTRUMENT:** 2021-094378