


PARENT PARCEL: 12-00-004-000-219 & 12-00-004-900-003

CHILD PARCEL: 12-00-004-000-224, 12-00-017-000-265, 12-00-004-900-005 & -006

STARTING POINT: EMERALD WOODS SUB. NO. 5 PV. 112 PG. 86 UNCOMBIANATION PER TAXING DISTRICT

22-04999-U-2

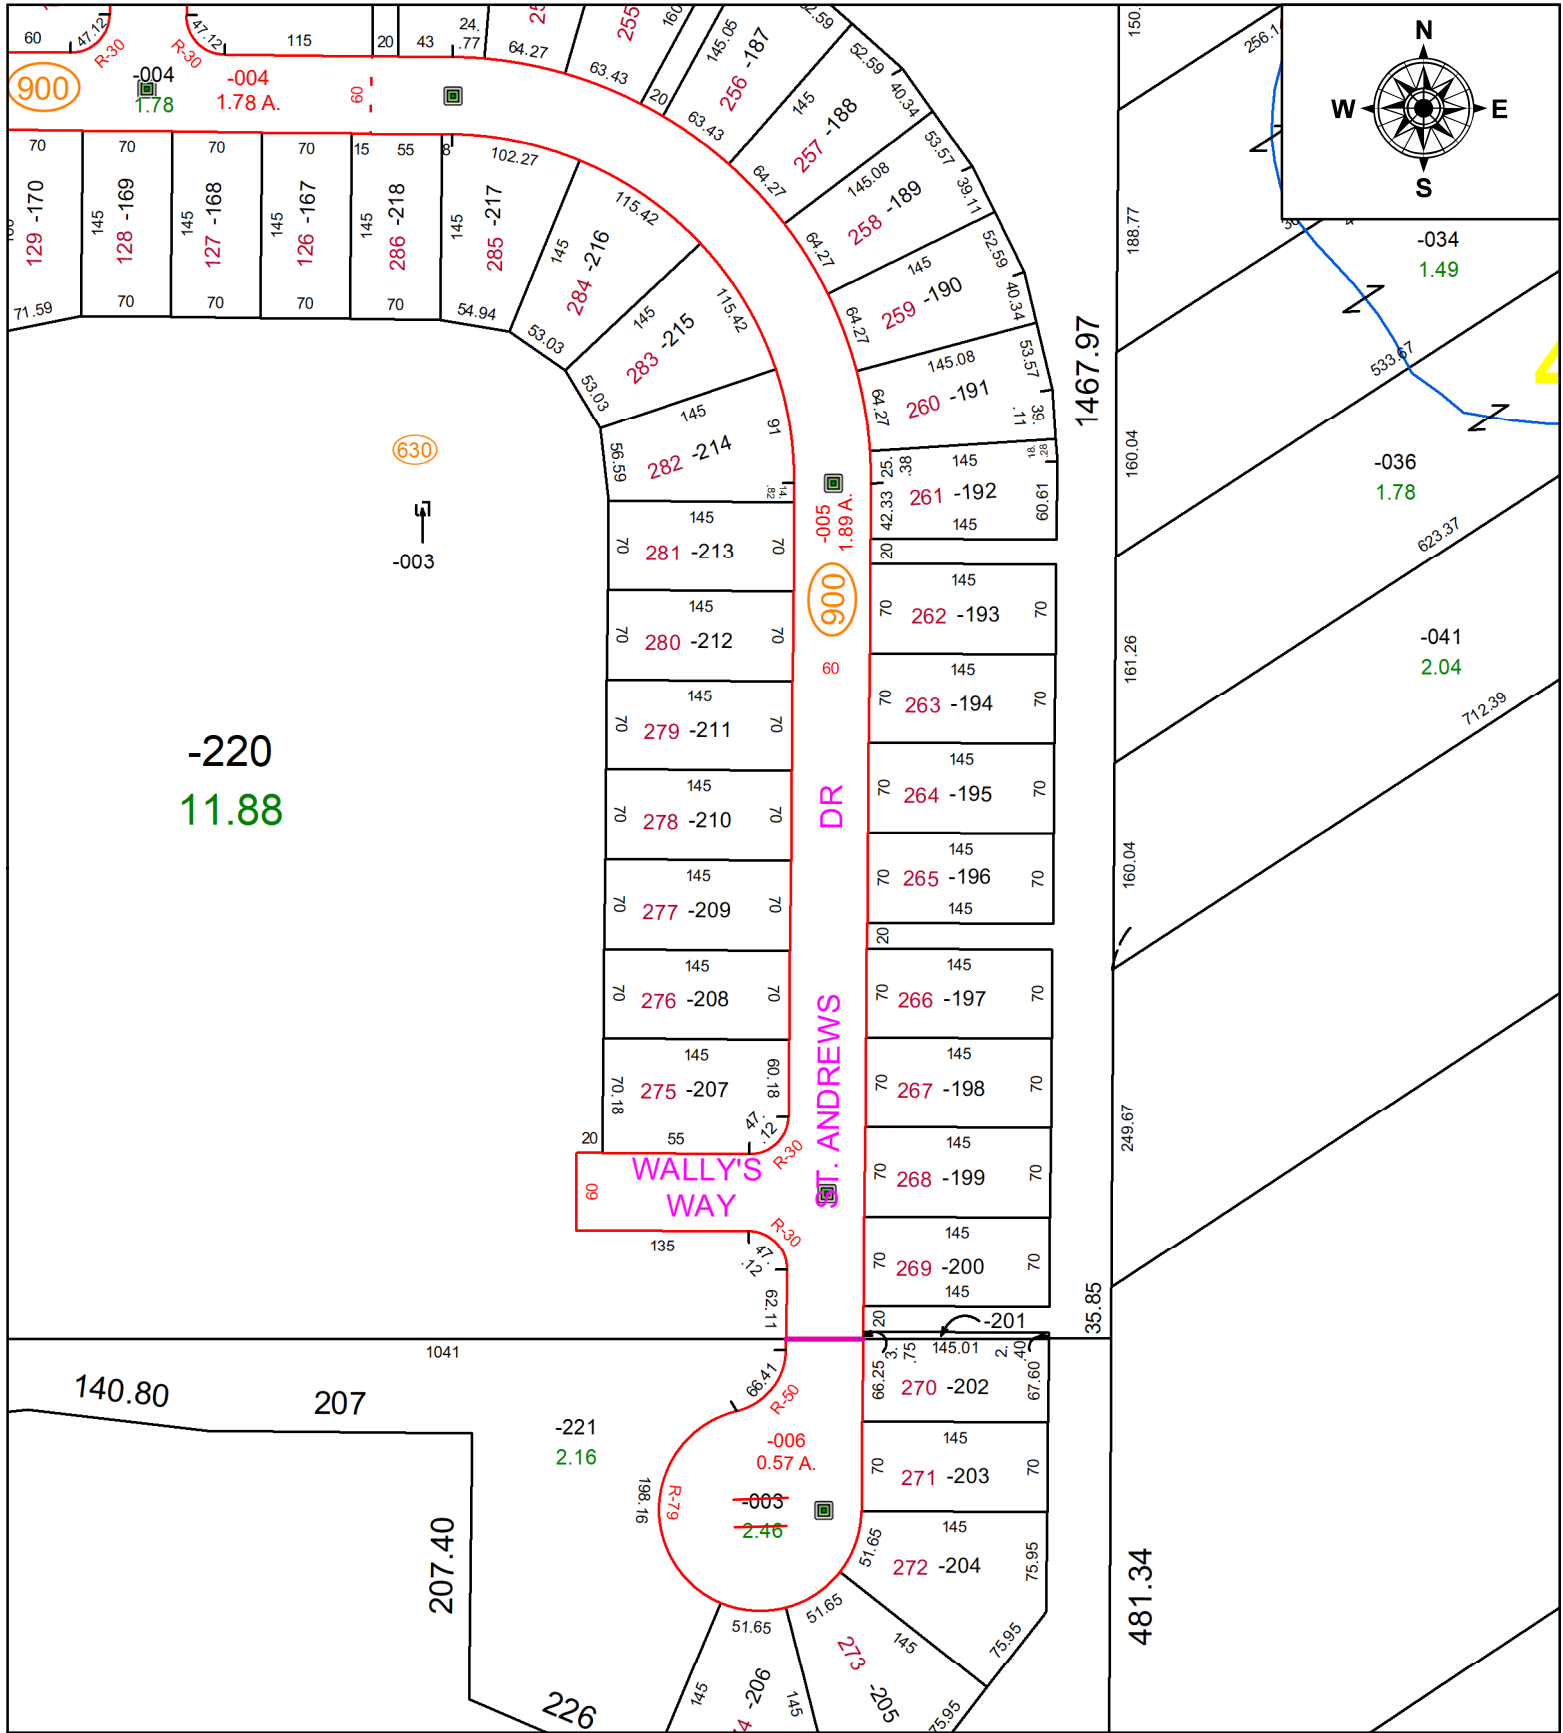

**SPLITS/DEEDS PROCESSED**  
 LORAIN COUNTY TAX MAP DEPARTMENT  
 226 MIDDLE AVE. ELYRIA, OH

**SURVEYED BY:** MICHAEL ACKERMAN  
**CLOSURE:** 1: INF  
**MAP PAGE(S):** 12-00-004 & -017  
**APPROVED BY:** TJS **DATE:** 12/16/2022  
**SCALE:** 1" = 150' **PRIOR INSTRUMENT:** 2021-094378