
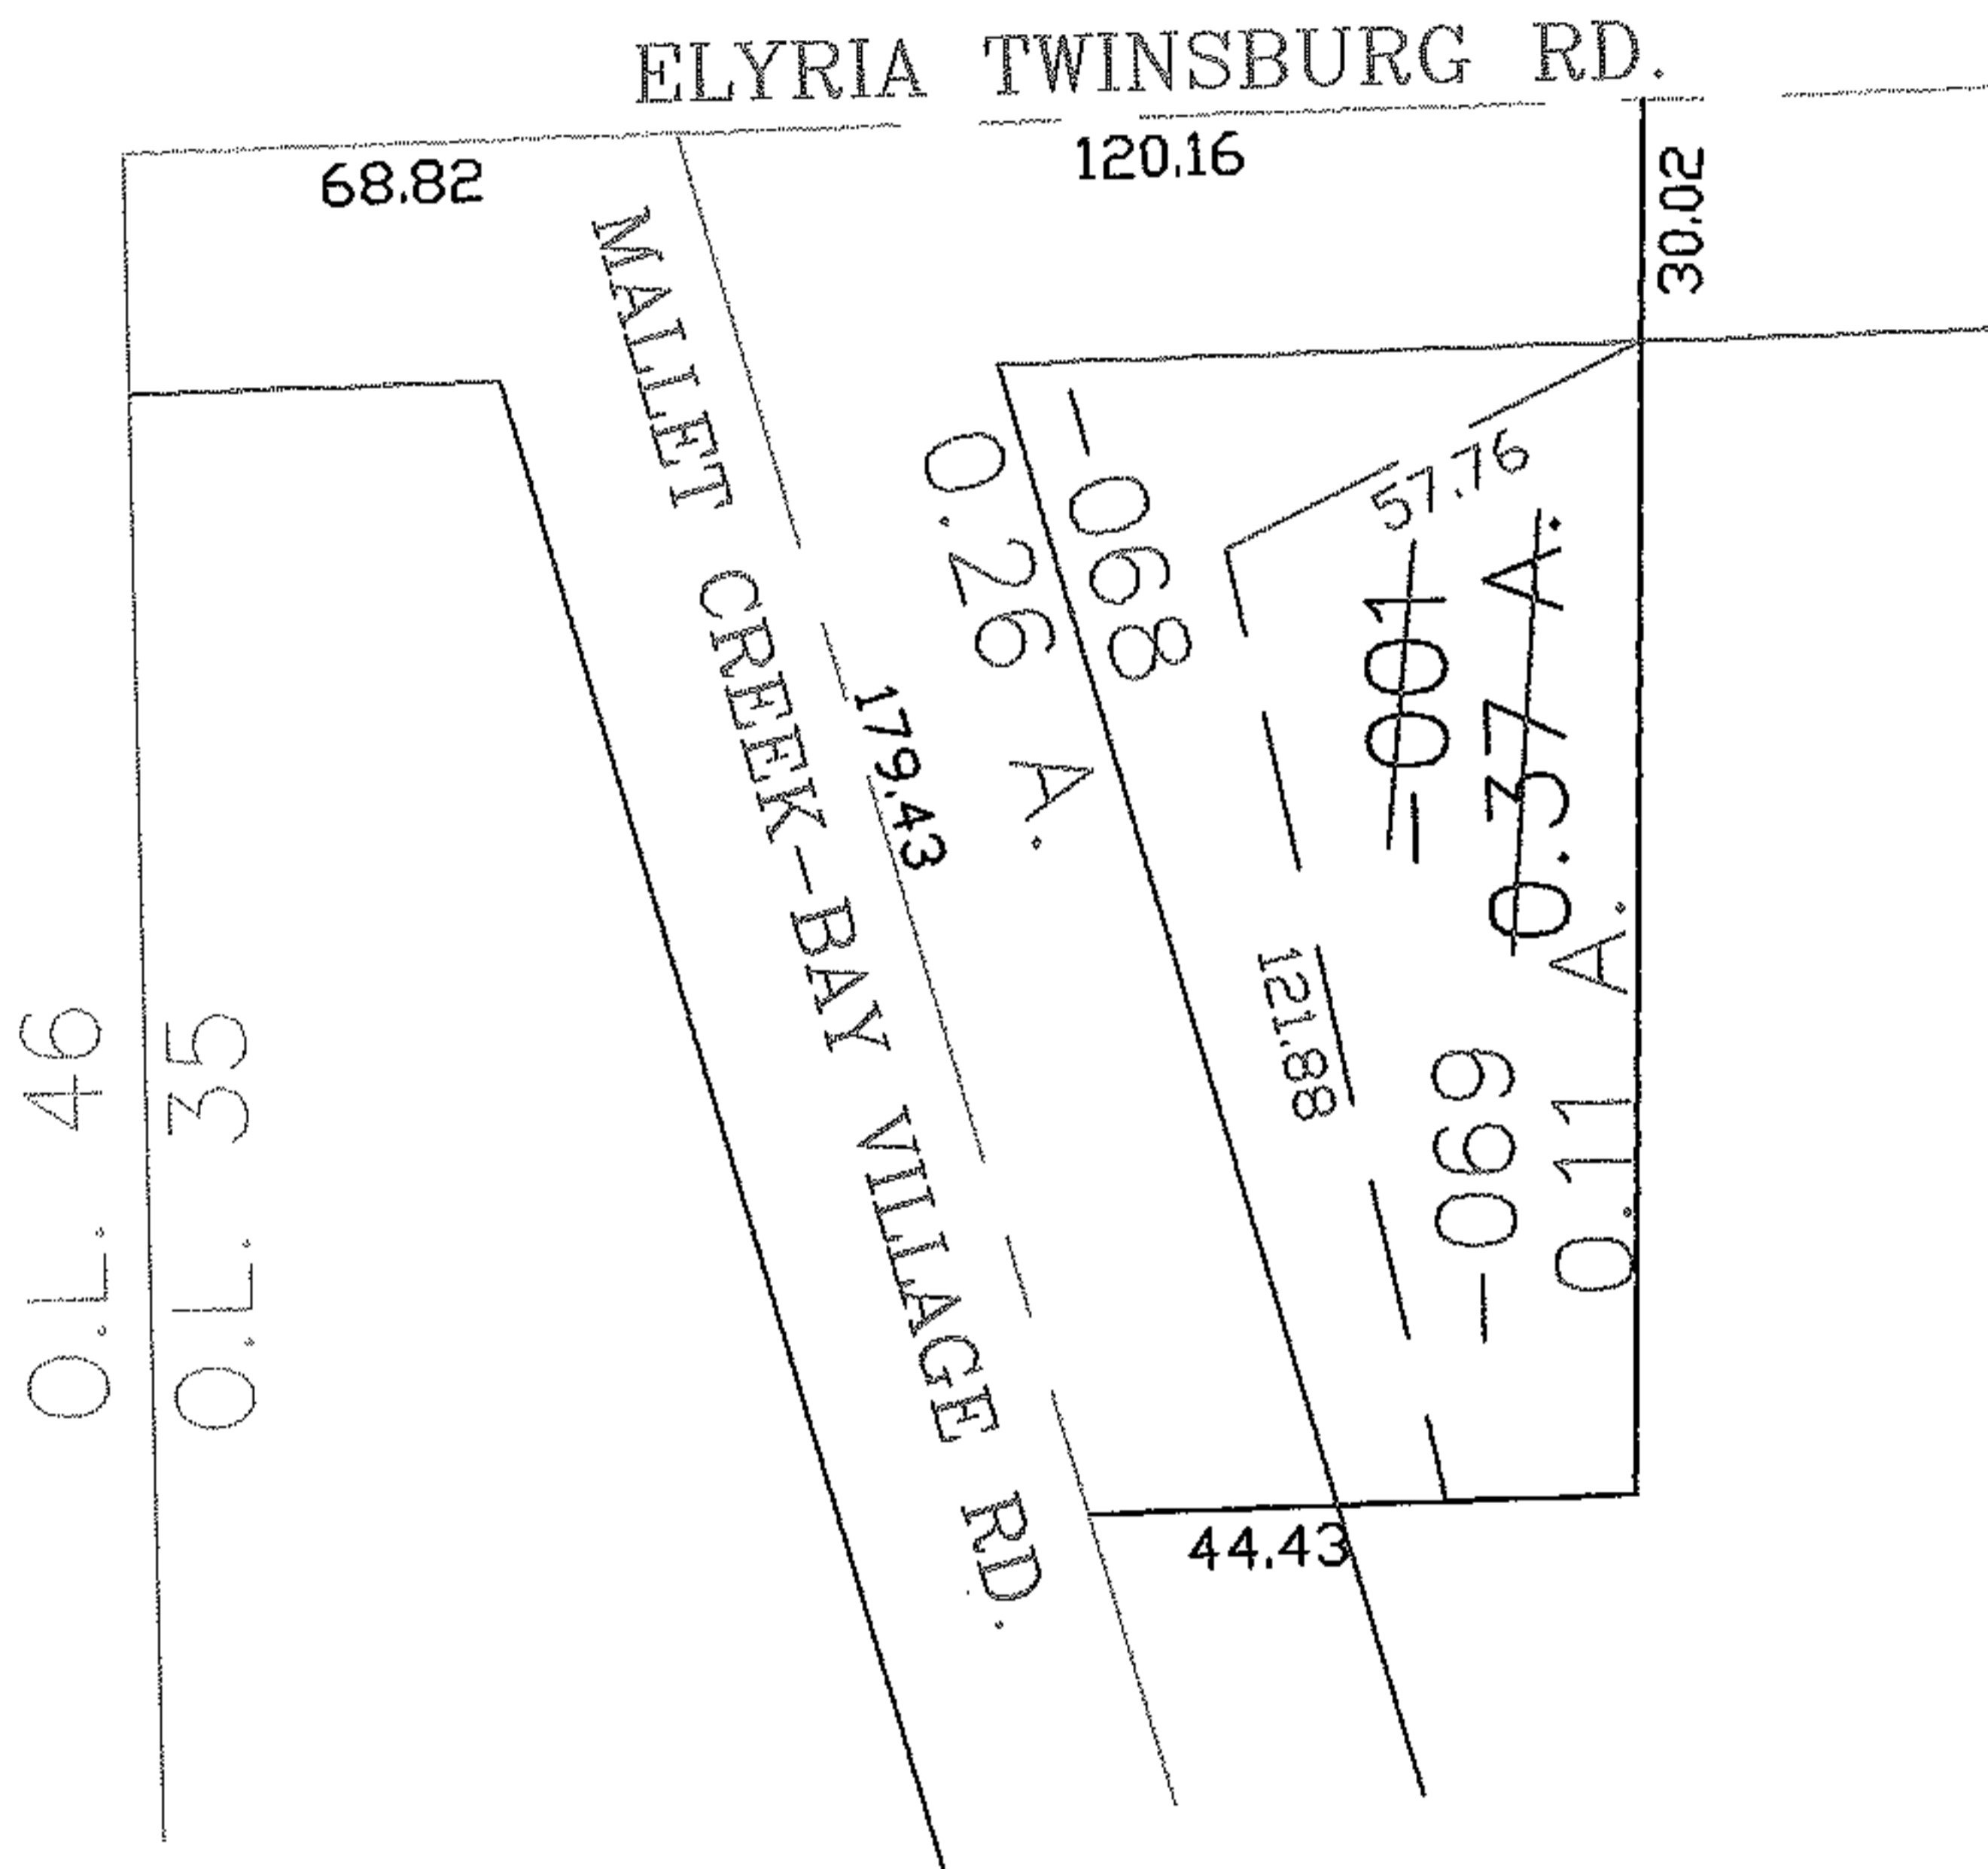


PARENT PARCEL: 12-00-035-102-001

CHILD PARCEL: 12-00-035-102-068, -069

STARTING POINT: CENTERLINE OF ELYRIA TWINSBURG RD. & O.L. 35

NO. 00134

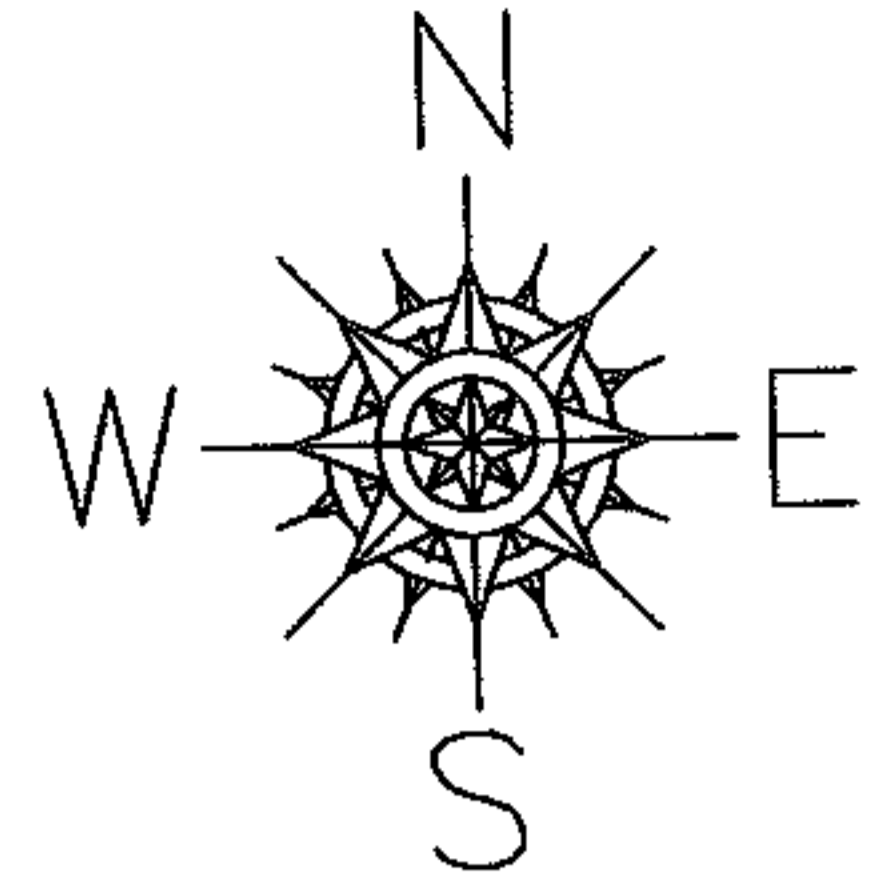

**SPLITS/DEEDS PROCESSED**

LORAIN COUNTY TAX MAP DEPARTMENT  
226 MIDDLE AVE. ELYRIA, OHIO

0.00 : 10,000 MARK ALLEN YEAGER

CLOSURE: 0.00 : 10,000

MAP PAGE(S): 12-00-035-A

APPROVED BY: JAH DATE: 3-1-05

SCALE: 1" = 100 PRIOR INSTRUMENT: DV R/110