
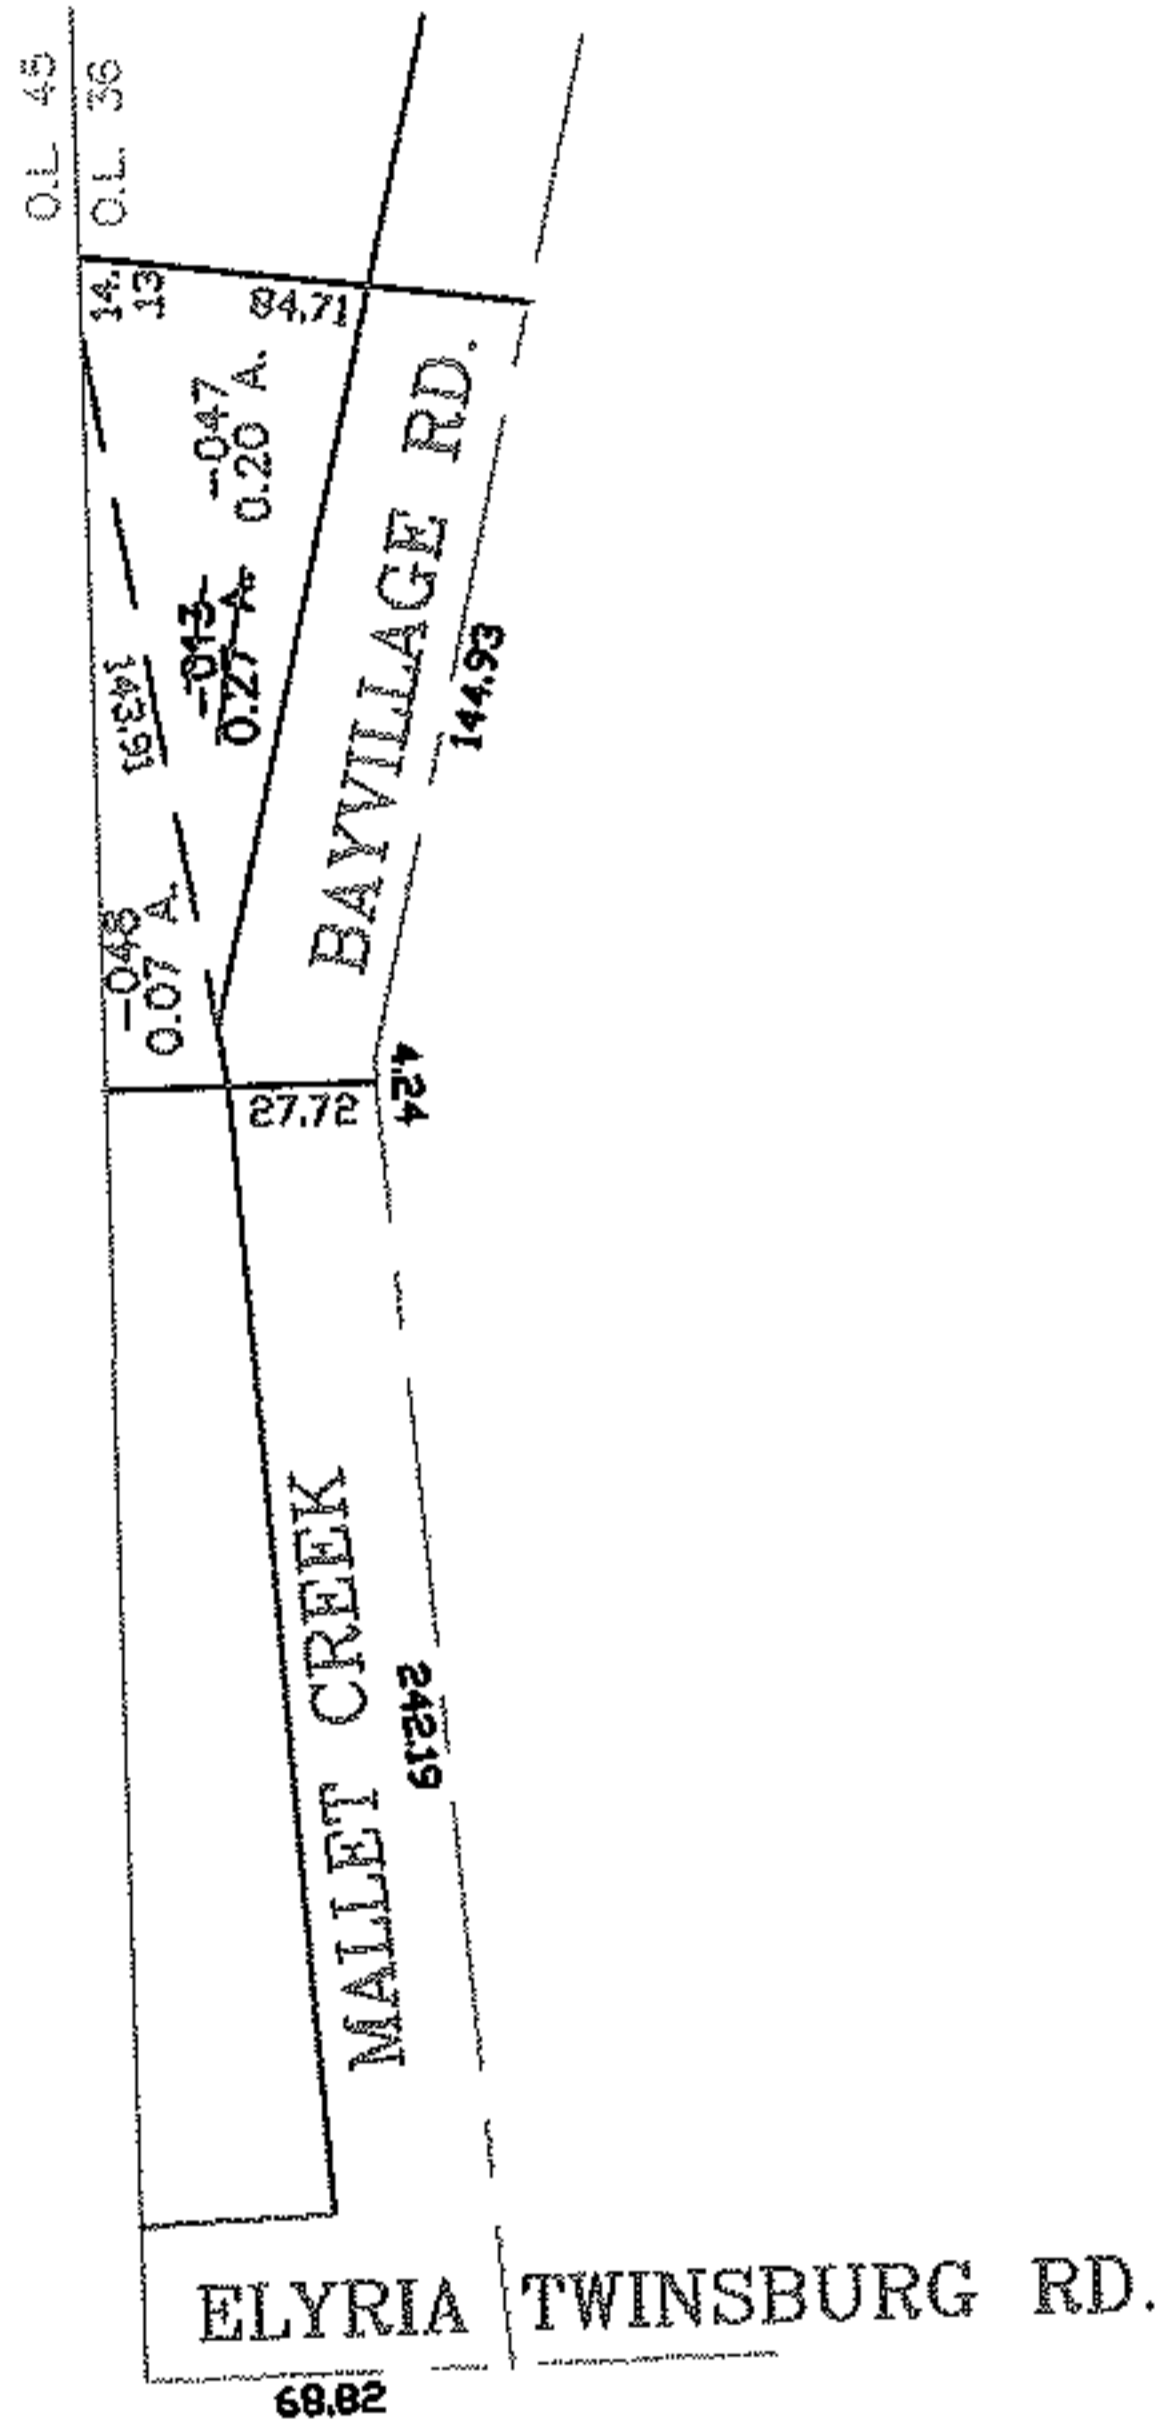


PARENT PARCEL: 12-00-036-000-013

CHILD PARCEL: 12-00-036-000-047, -048

STARTING POINT: CENTERLINE OF ELYRIA TWINSBURG RD. & O.L. 36

NO. 00136

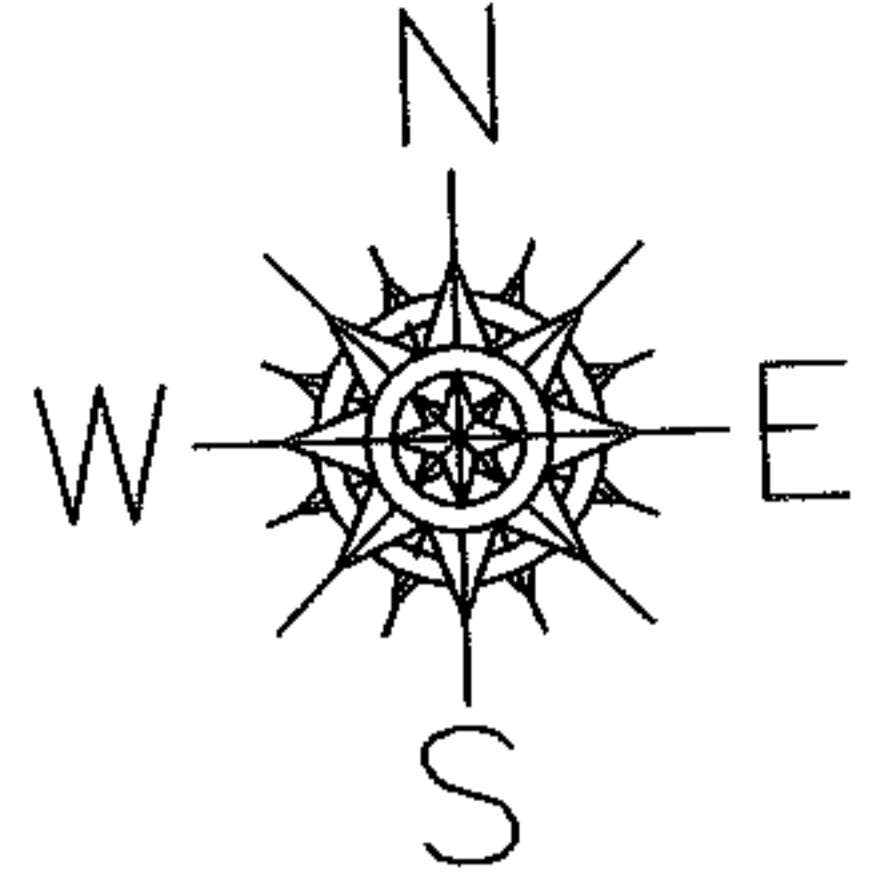

**SPLITS/DEEDS PROCESSED**

LORAIN COUNTY TAX MAP DEPARTMENT  
226 MIDDLE AVE. ELYRIA, OHIO

SURVEYED BY: MARK ALLEN YEAGER

CLOSURE: 0.00 : 10.000

MAP PAGE(S): 12-00-036-A

APPROVED BY: JAH DATE: 3-4-05

SCALE: 1" = 100' PRIOR INSTRUMENT: 990600038