
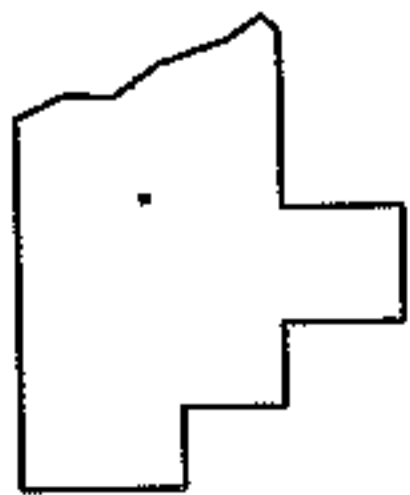
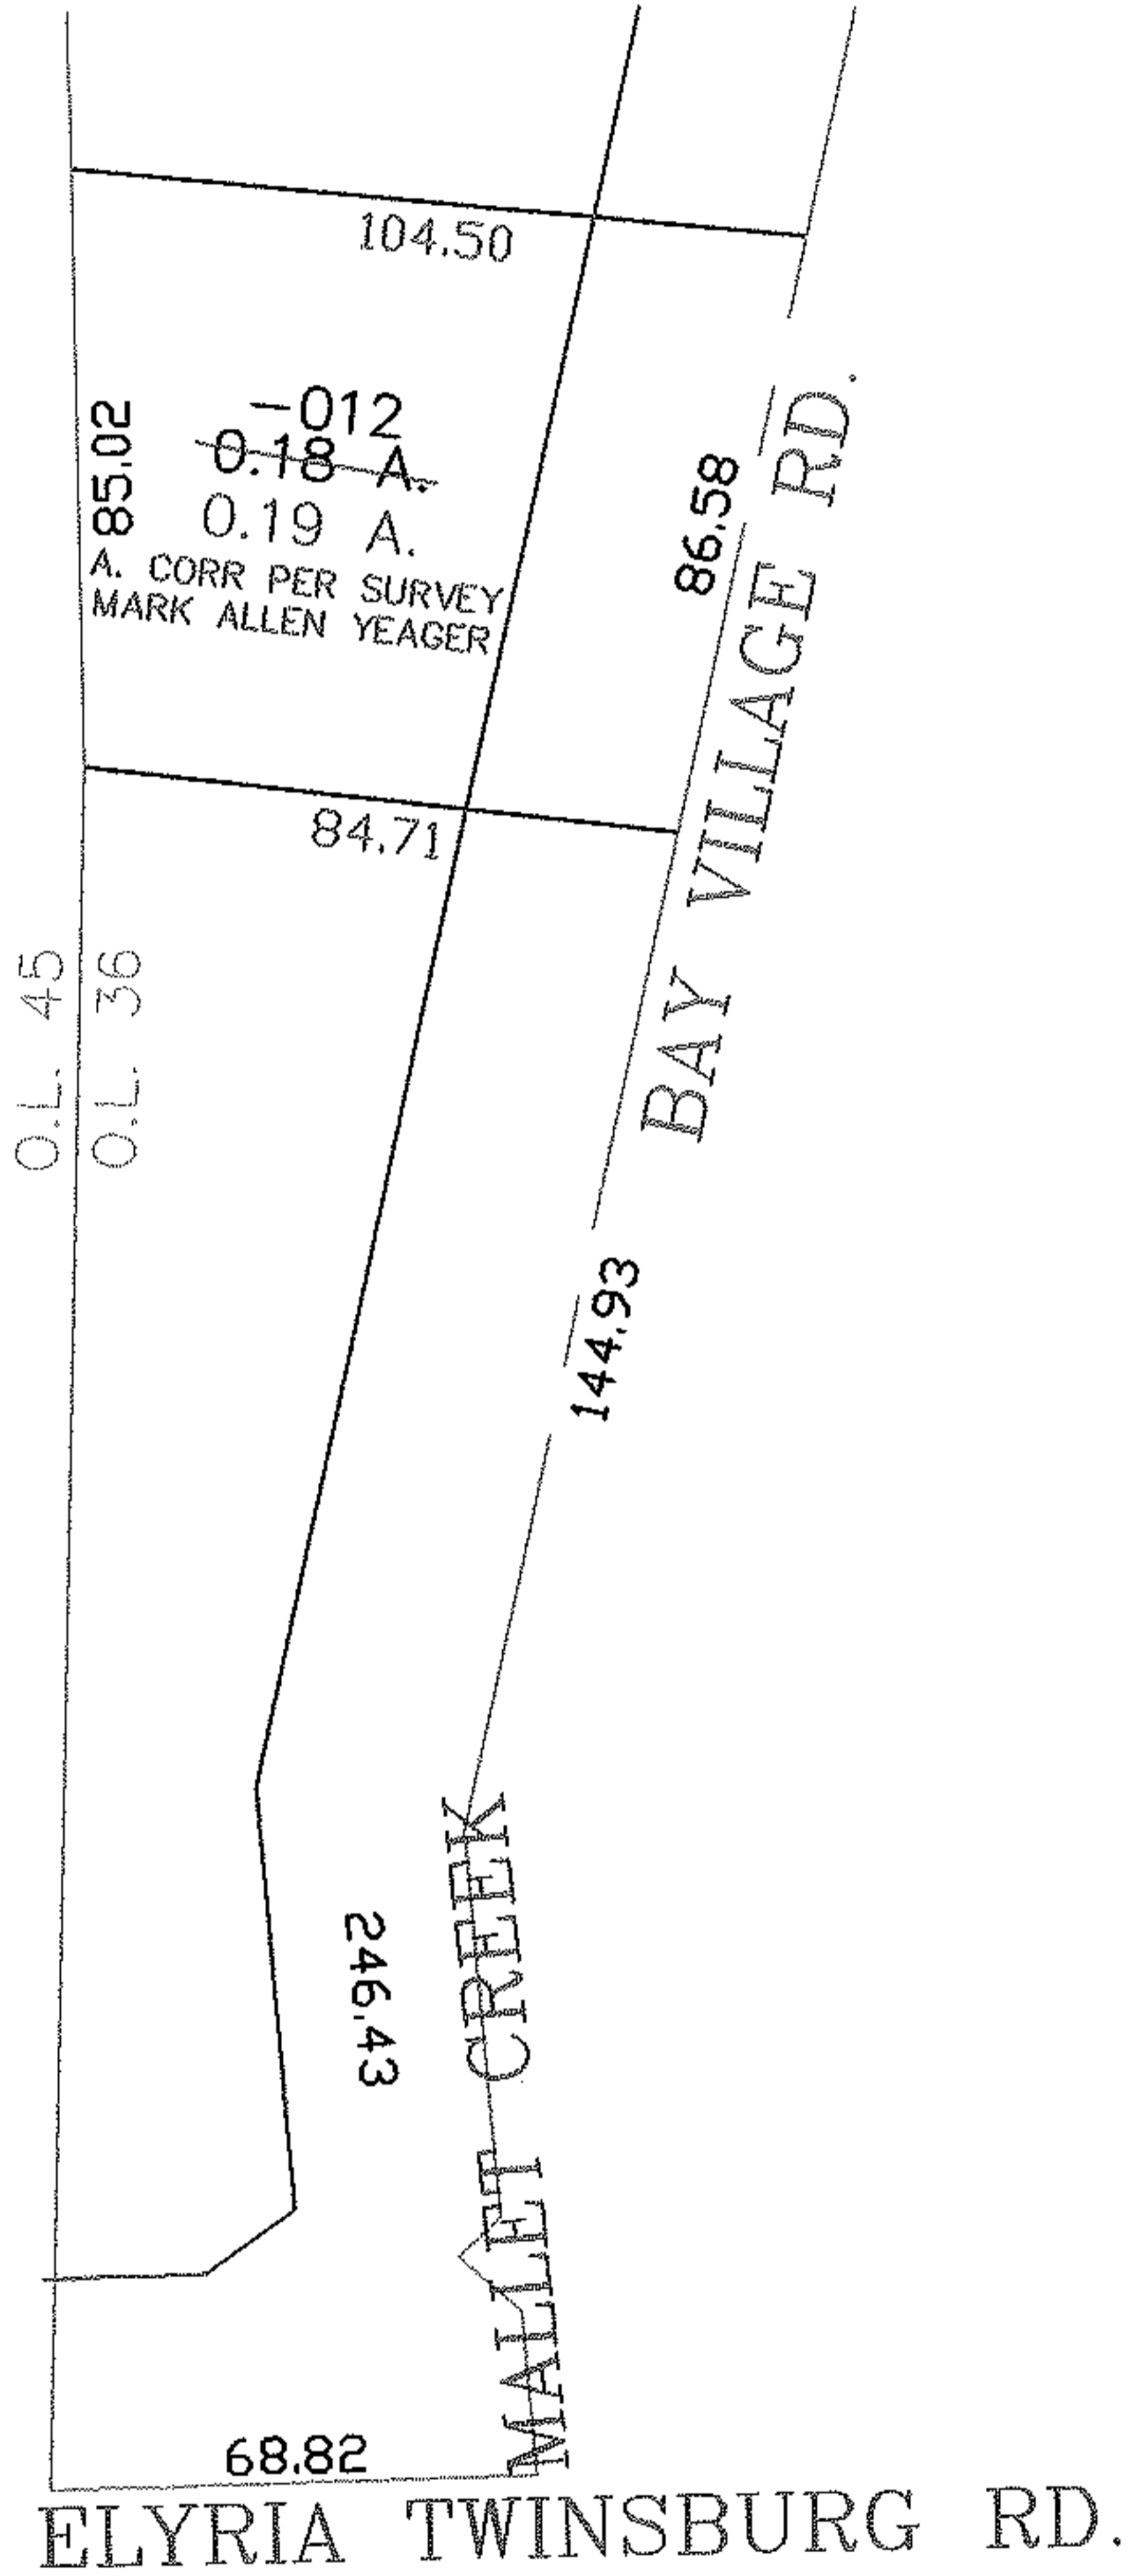


PARENT PARCEL: 12-00-036-000-012

CHILD PARCEL: SAME

STARTING POINT: CENTERLINE OF ELYRIA TWINSBURG RD. & O.L. 36

NO. 00137

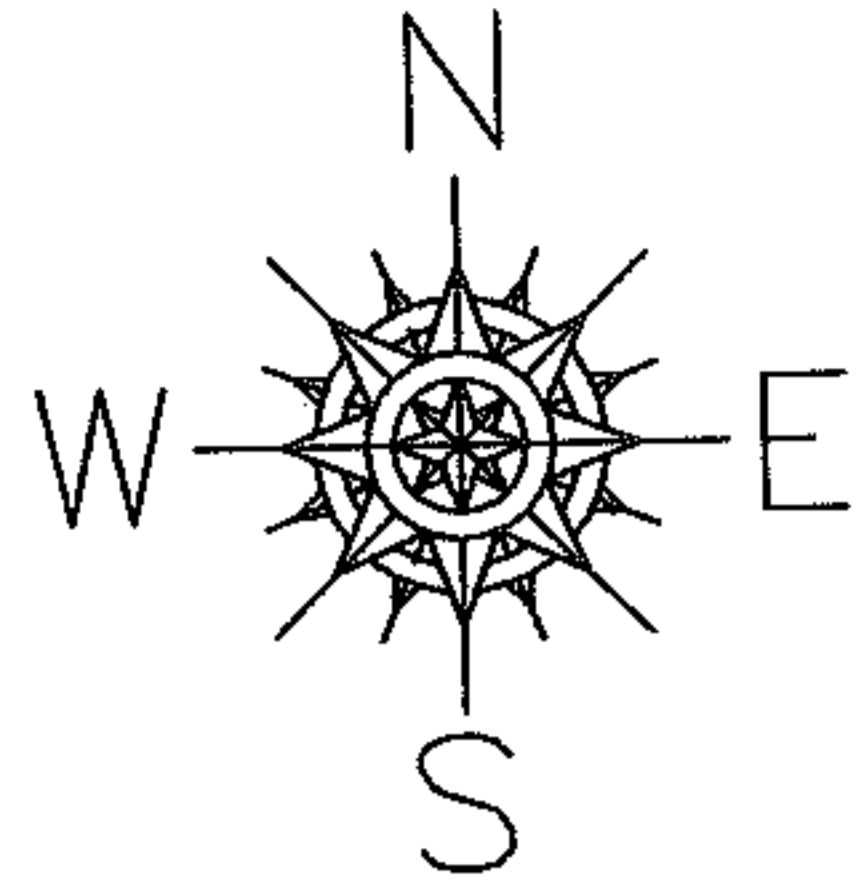

**SPLITS/DEEDS PROCESSED**

LORAIN COUNTY TAX MAP DEPARTMENT  
226 MIDDLE AVE. ELYRIA, OHIO

SURVEYED BY: MARK ALLEN YEAGER  
 CLOSURE: 0.00 : 10.000  
 MAP PAGE(S): 12-00-036-A  
 APPROVED BY: JAH DATE: 3-7-05  
 SCALE: 1" = 100 PRIOR INSTRUMENT: 990600038