
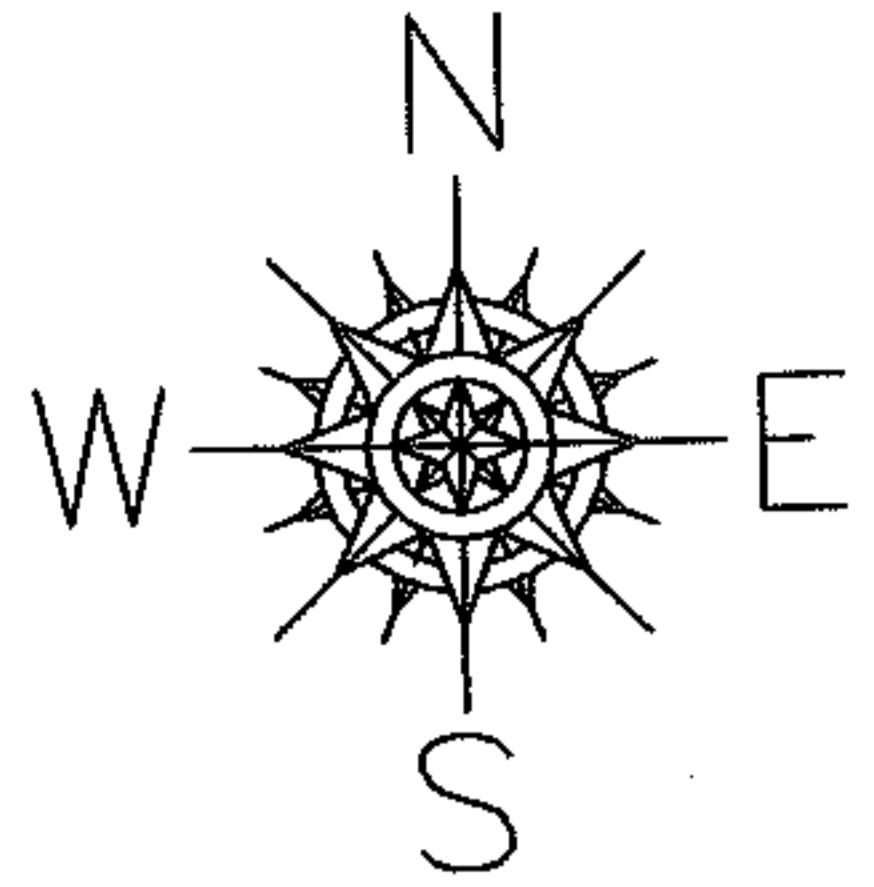


PARENT PARCEL: 12-00-036-000-027

CHILD PARCEL: SAME

STARTING POINT: CENTERLINE OF ELYRIA TWINSBURG RD. & O.L. 36

NO. 00138

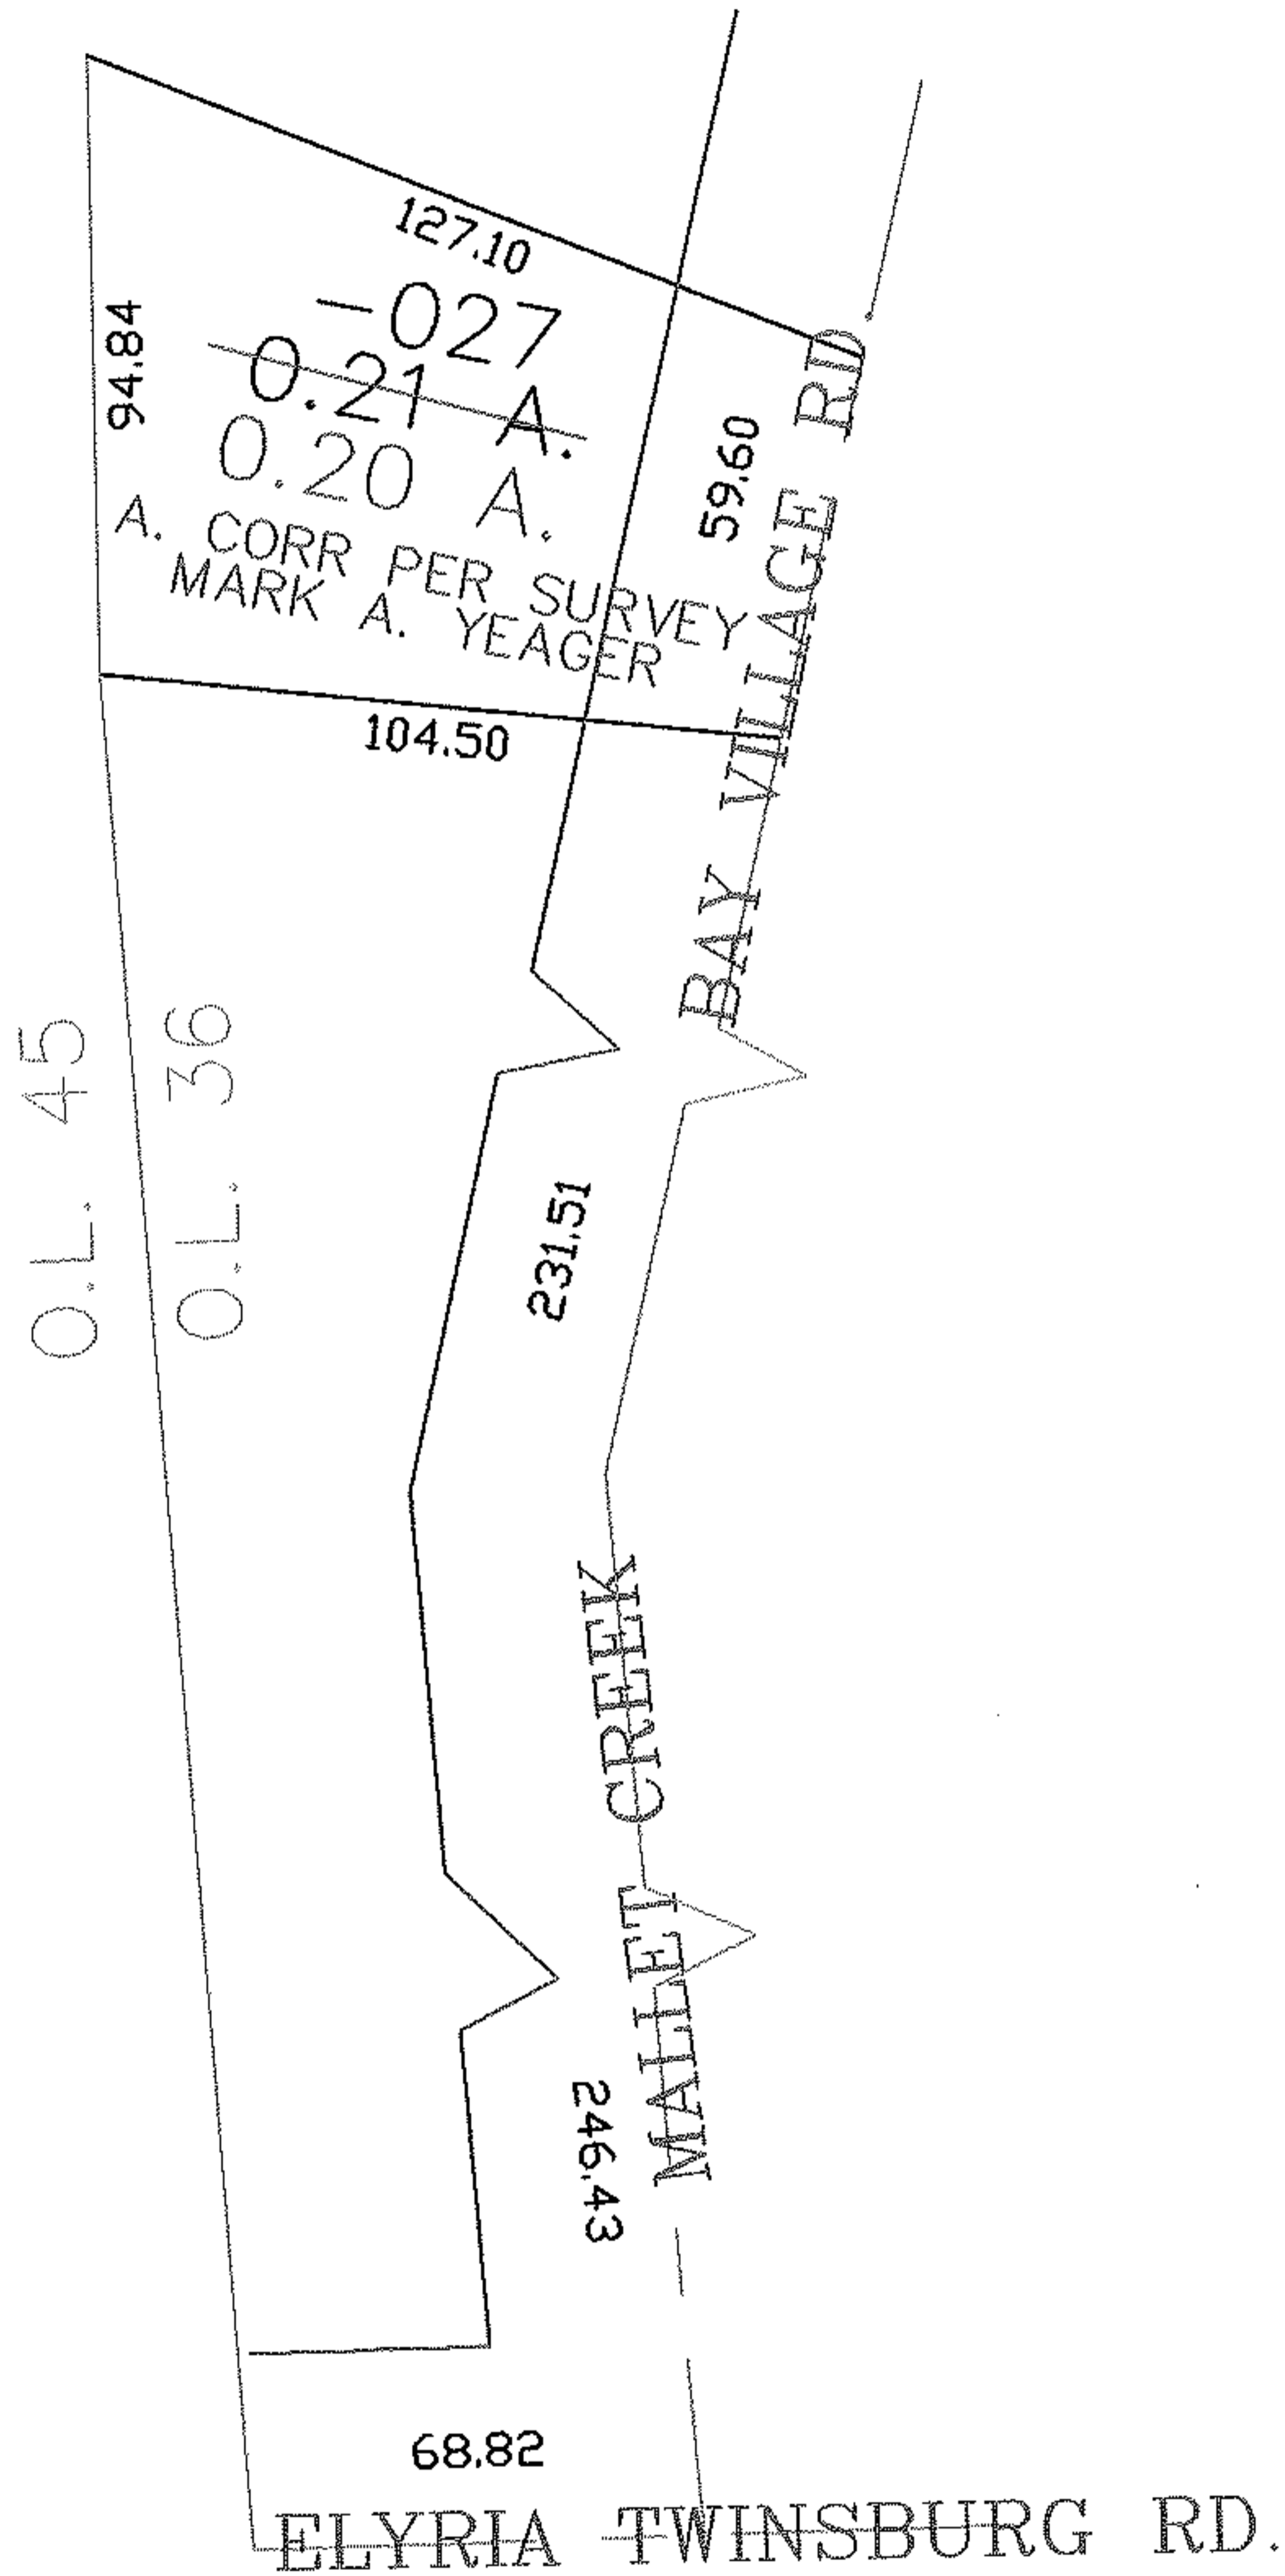

SPLITS/DEEDS PROCESSED

LORAIN COUNTY TAX MAP DEPARTMENT
226 MIDDLE AVE. ELYRIA, OHIO

SURVEYED BY: MARK A. YEAGER

CLOSURE: 0.00 : 10.000

MAP PAGE(S): 12-00-036-A

APPROVED BY: JAH DATE: 3-7-05

SCALE: 1" = 100 PRIOR INSTRUMENT: 990600038