
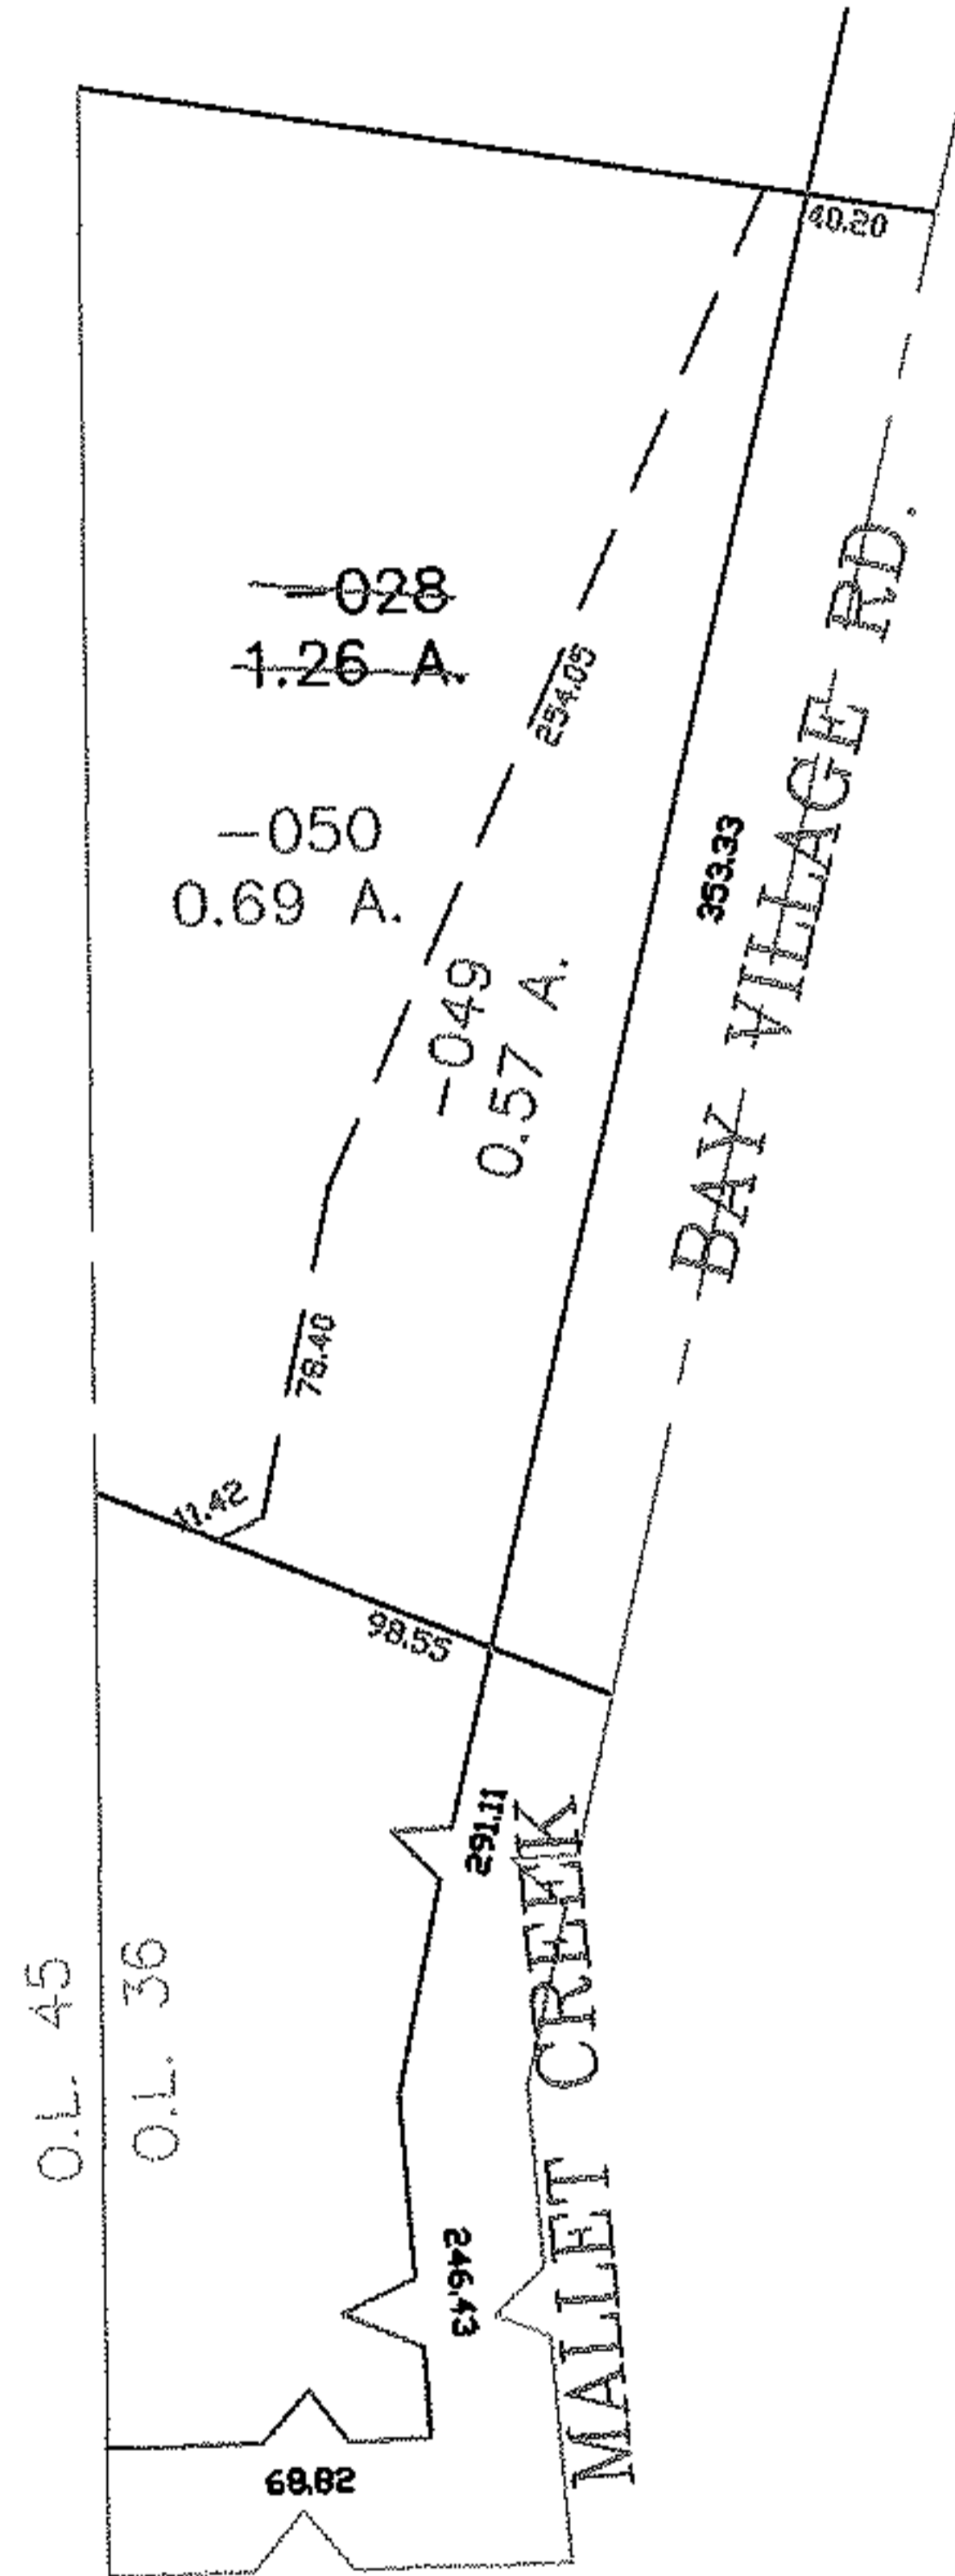


PARENT PARCEL: 12-00-036-000-028

CHILD PARCEL: 12-00-036-000-049, -050

STARTING POINT: CENTERLINE OF ELYRIA TWINSBURG RD & O.L. 36

NO. 00139

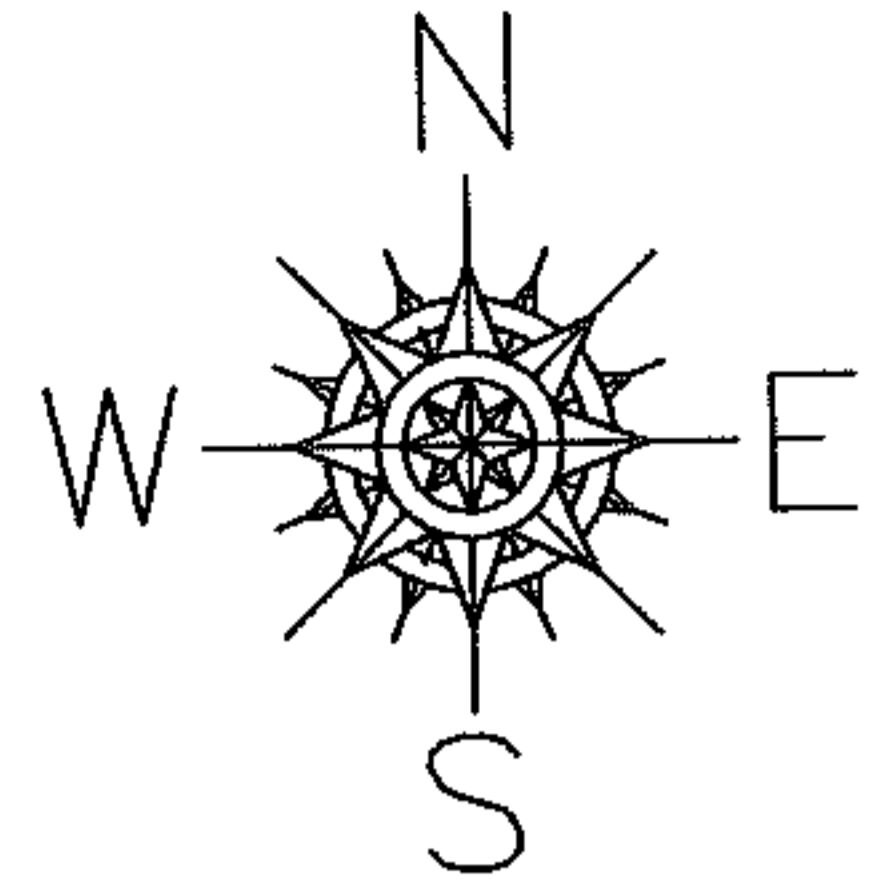

ELYRIA TWINSBURG RD.

SPLITS/DEEDS PROCESSED

LORAIN COUNTY TAX MAP DEPARTMENT
226 MIDDLE AVE. ELYRIA, OHIO

SURVEYED BY: MARK A YEAGER

CLOSURE: 0.00 : 10.000

MAP PAGE(S): 12-00-036-A

APPROVED BY: JAH DATE: 3-7-05

SCALE: 1" = 100 PRIOR INSTRUMENT: DV 1222/420