
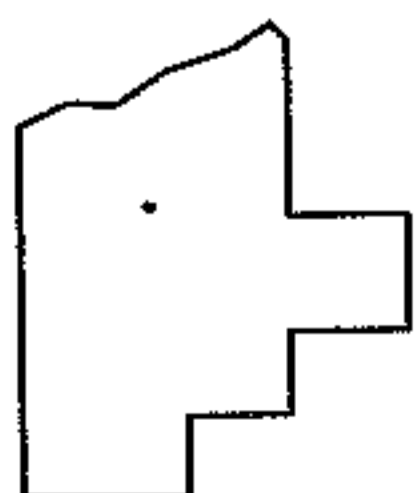
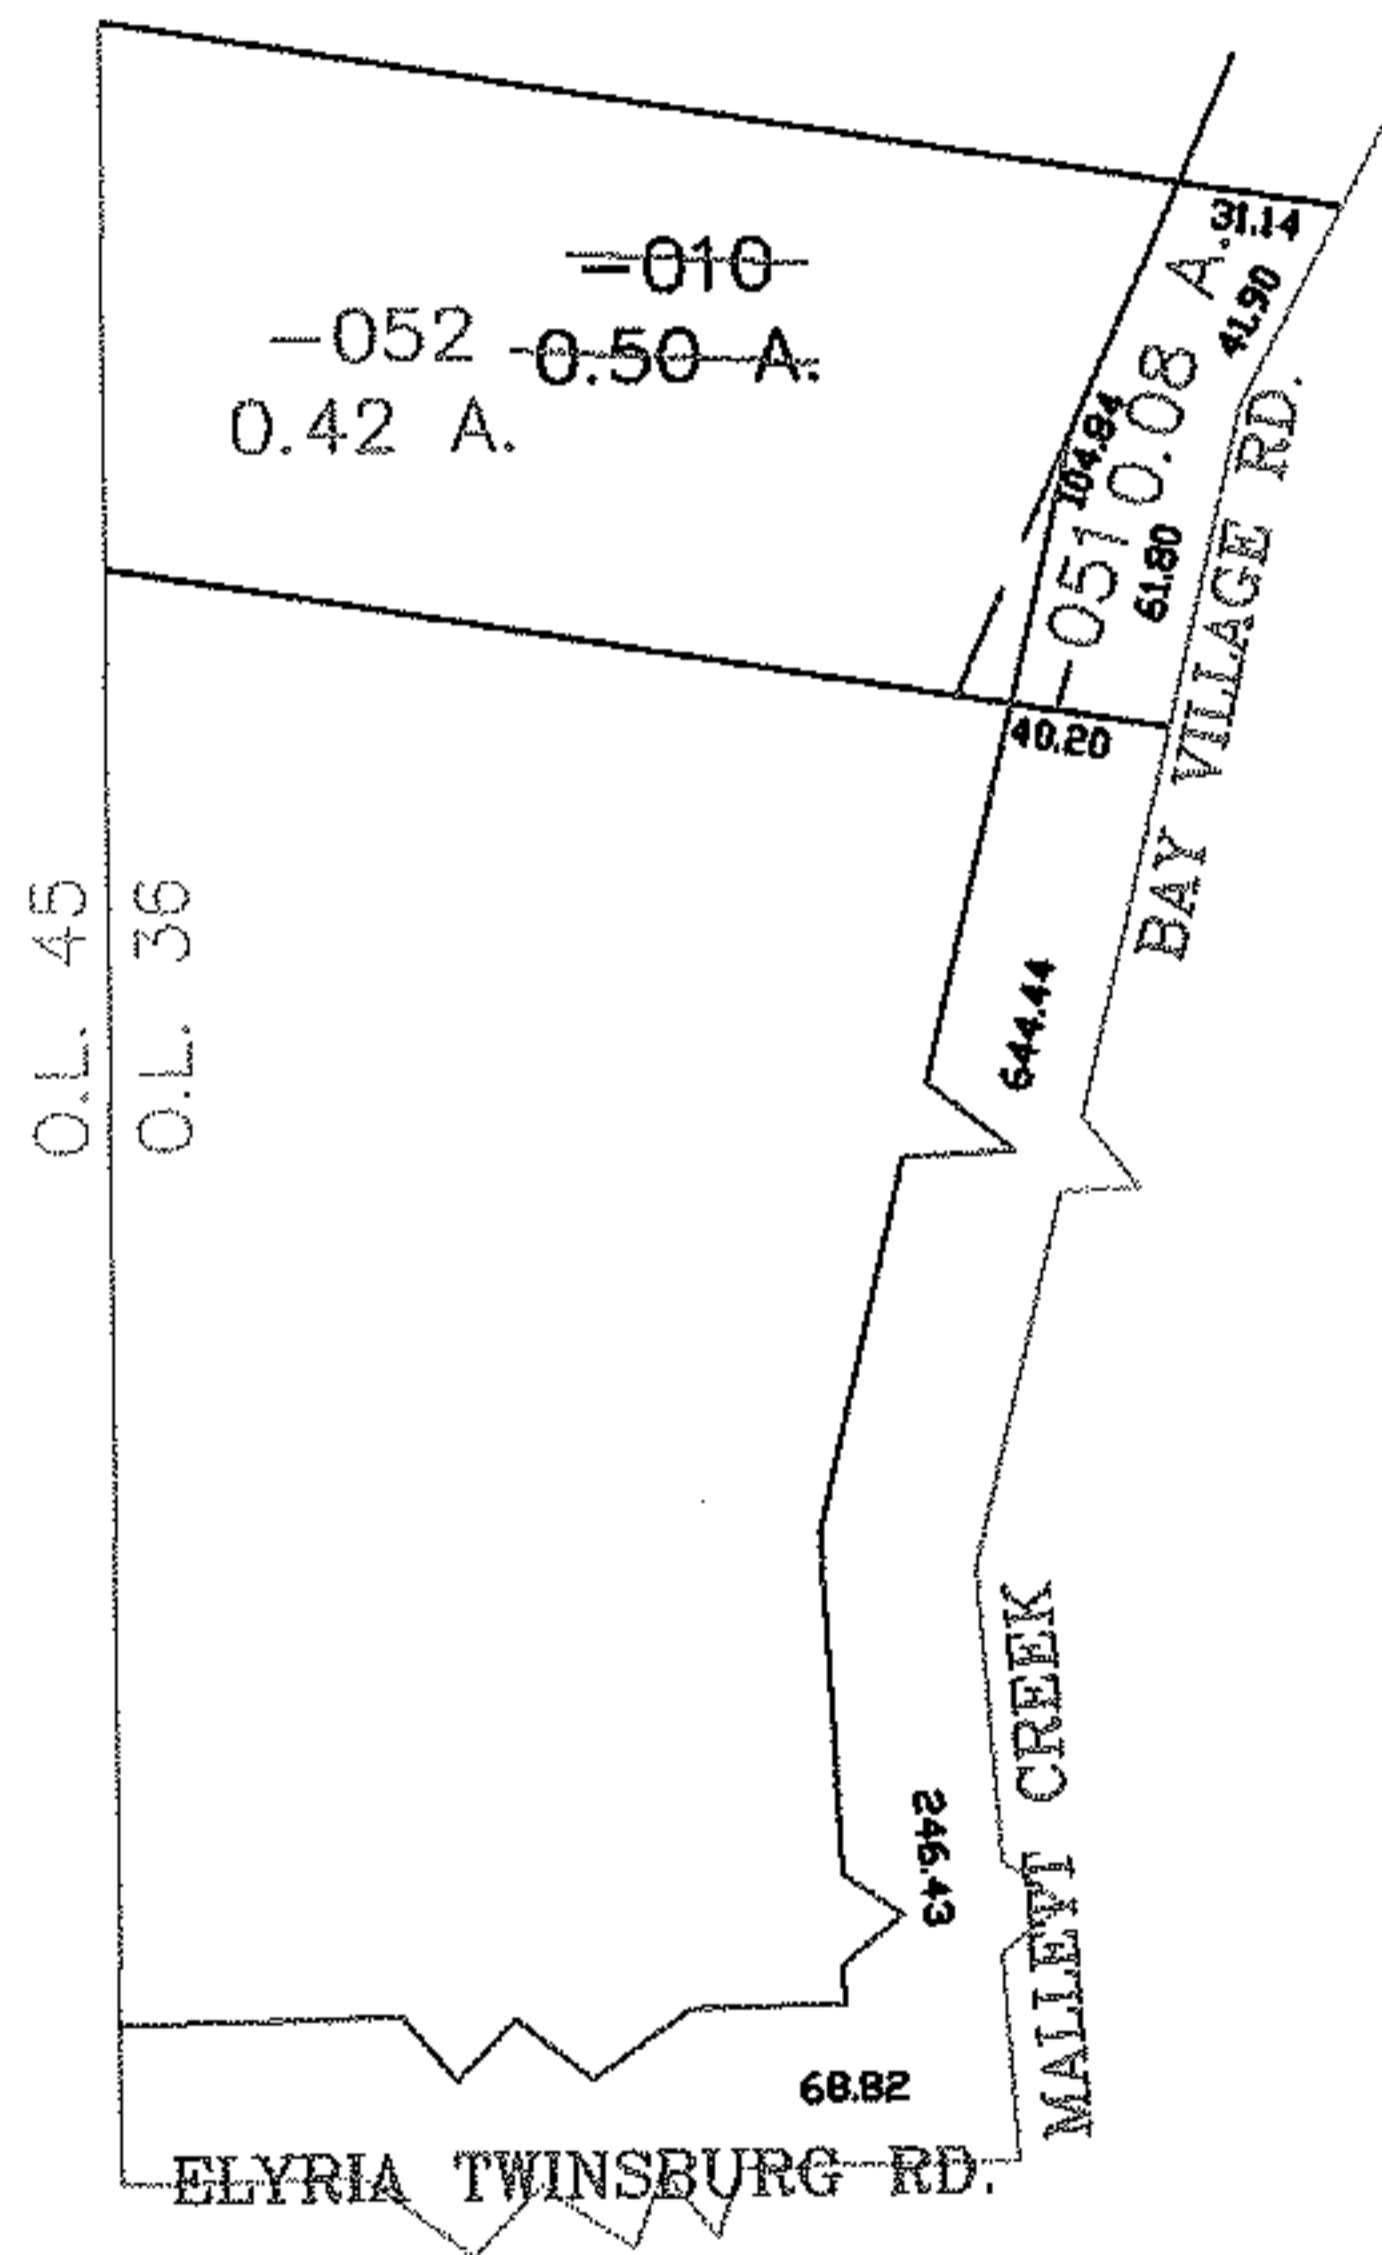


PARENT PARCEL: 12-00-036-000-010

CHILD PARCEL: 12-00-036-000-051, -052

STARTING POINT: CENTERLINE OF ELYRIA TWINSBURG RD. & O.L. 36

NO. 00140

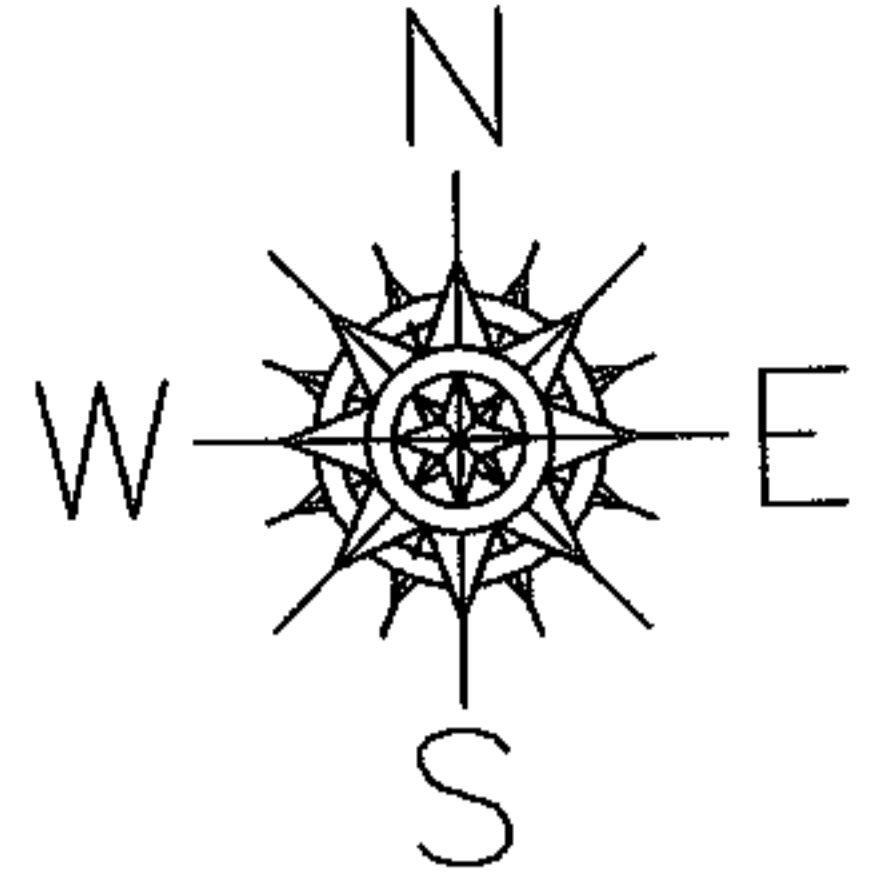

SPLITS/DEEDS PROCESSED

LORAIN COUNTY TAX MAP DEPARTMENT
226 MIDDLE AVE. ELYRIA, OHIO

SURVEYED BY: MARK A YEAGER

CLOSURE: 0.00 : 10.000

MAP PAGE(S): 12-00-036-A

APPROVED BY: JAH DATE: 3-7-05

SCALE: 1" = 100 PRIOR INSTRUMENT: OR 1088/696