
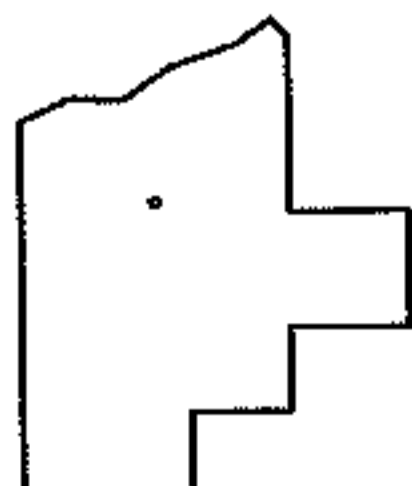
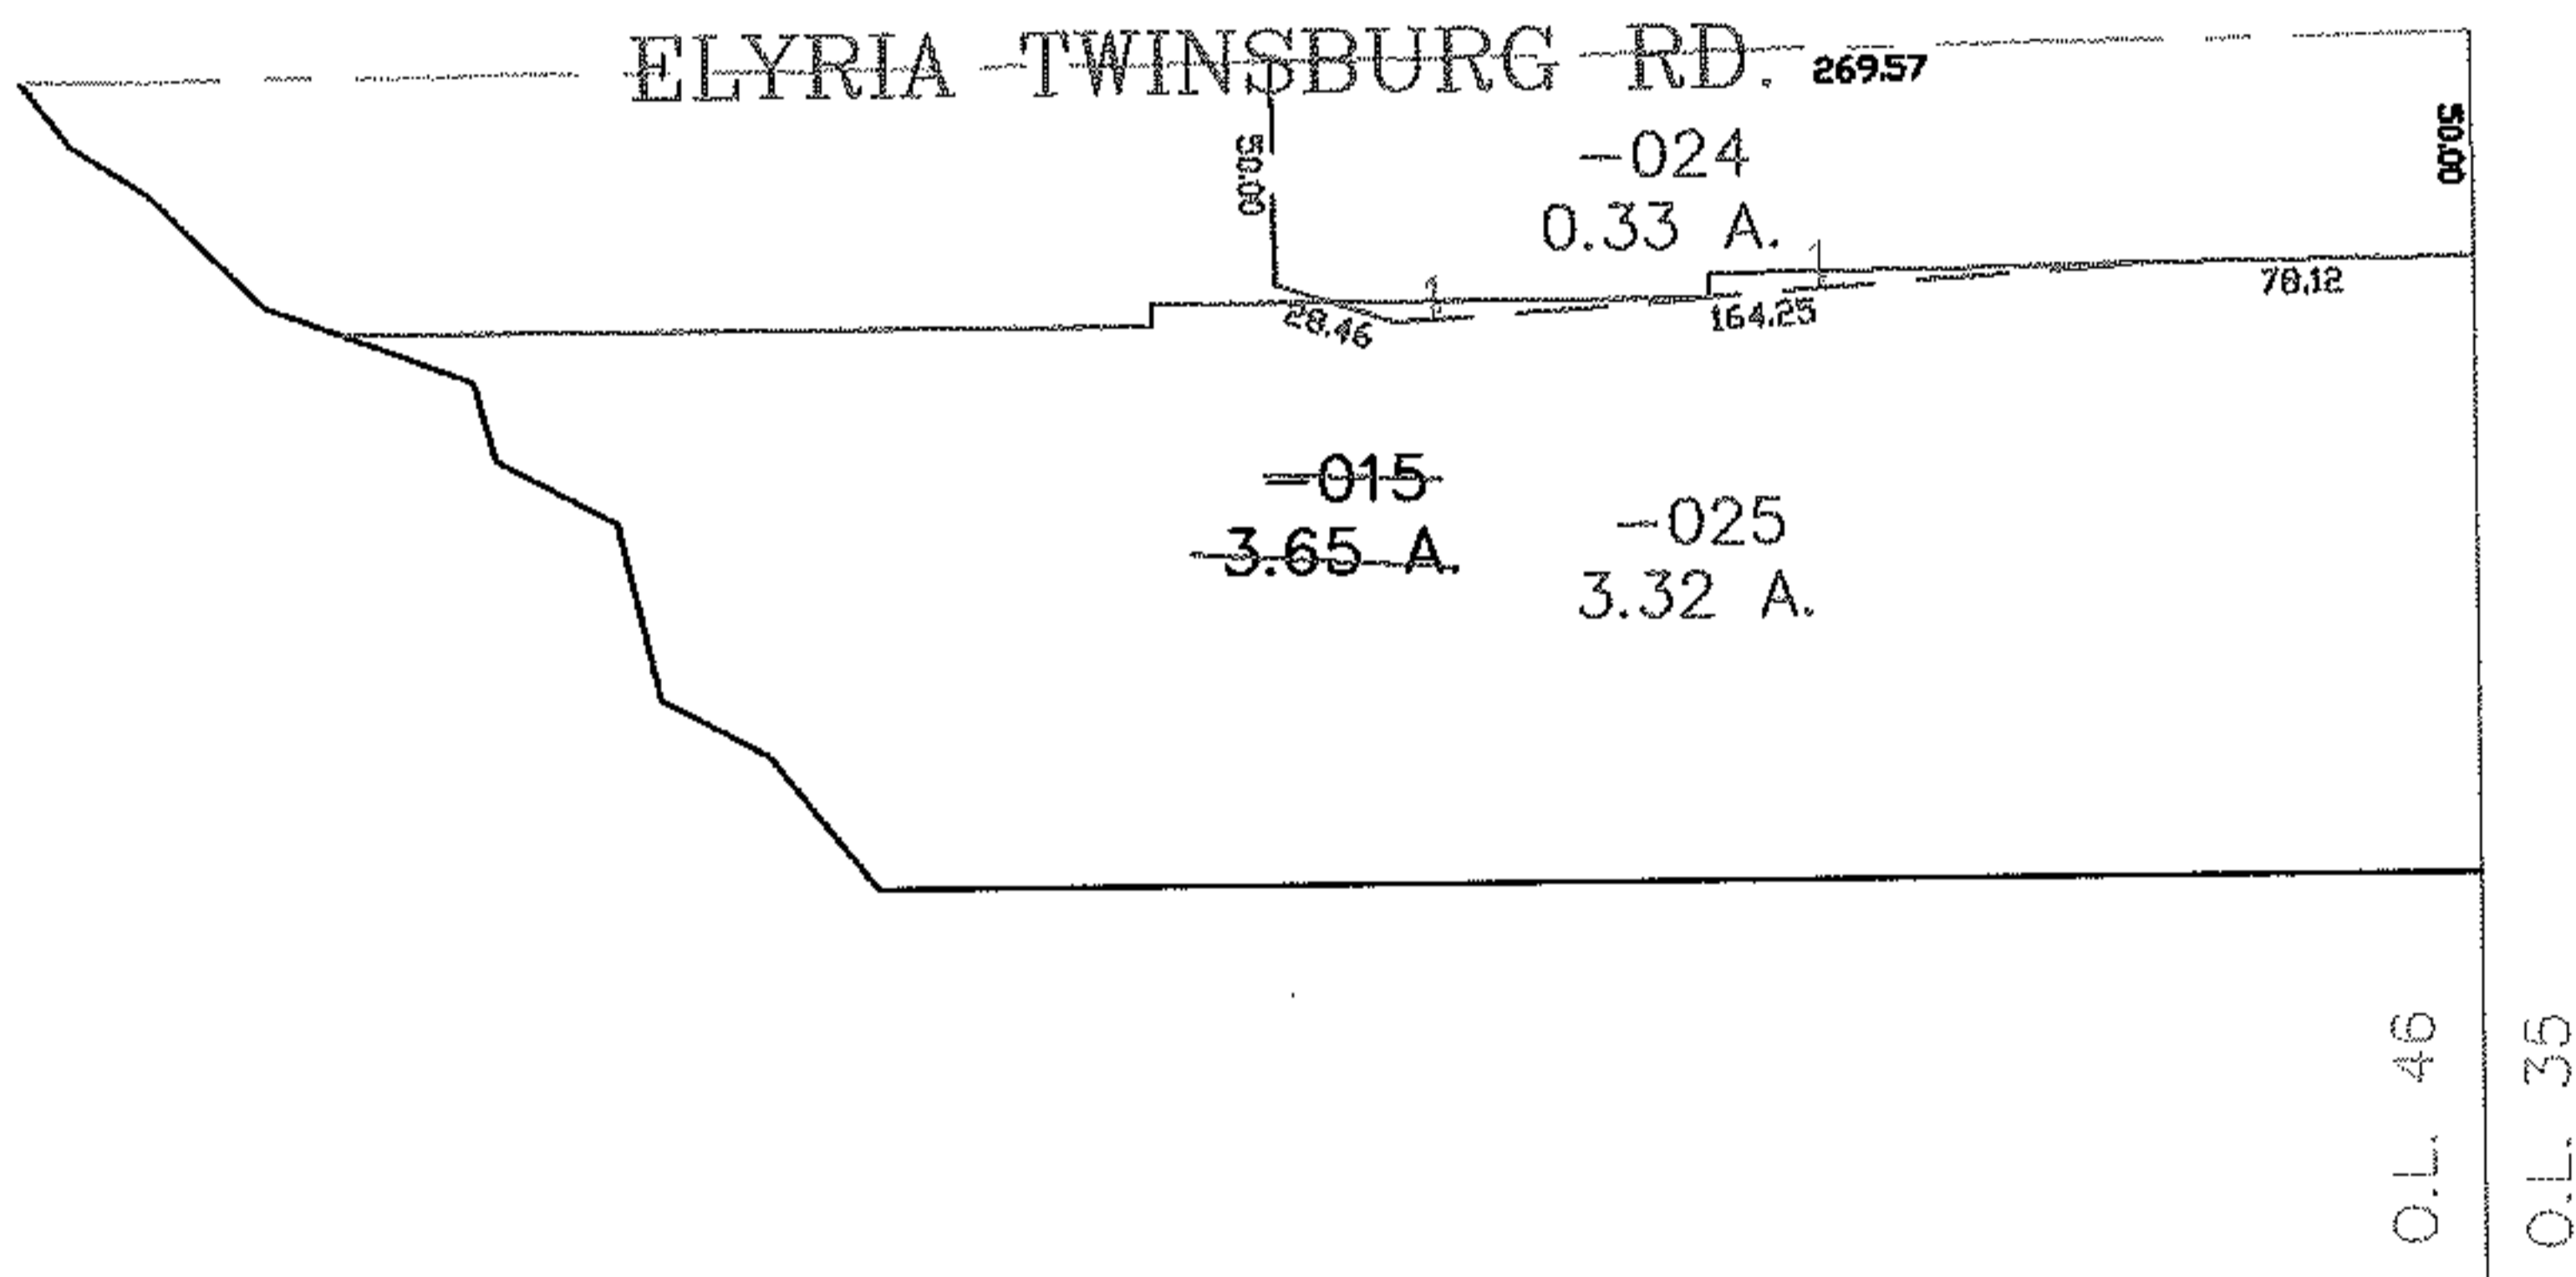


PARENT PARCEL: 12-00-046-000-015

CHILD PARCEL: 12-00-046-000-024, -025

STARTING POINT: CENTERLINE OF ELYRIA TWINSBURG RD. & O.L. 46

NO. 00141

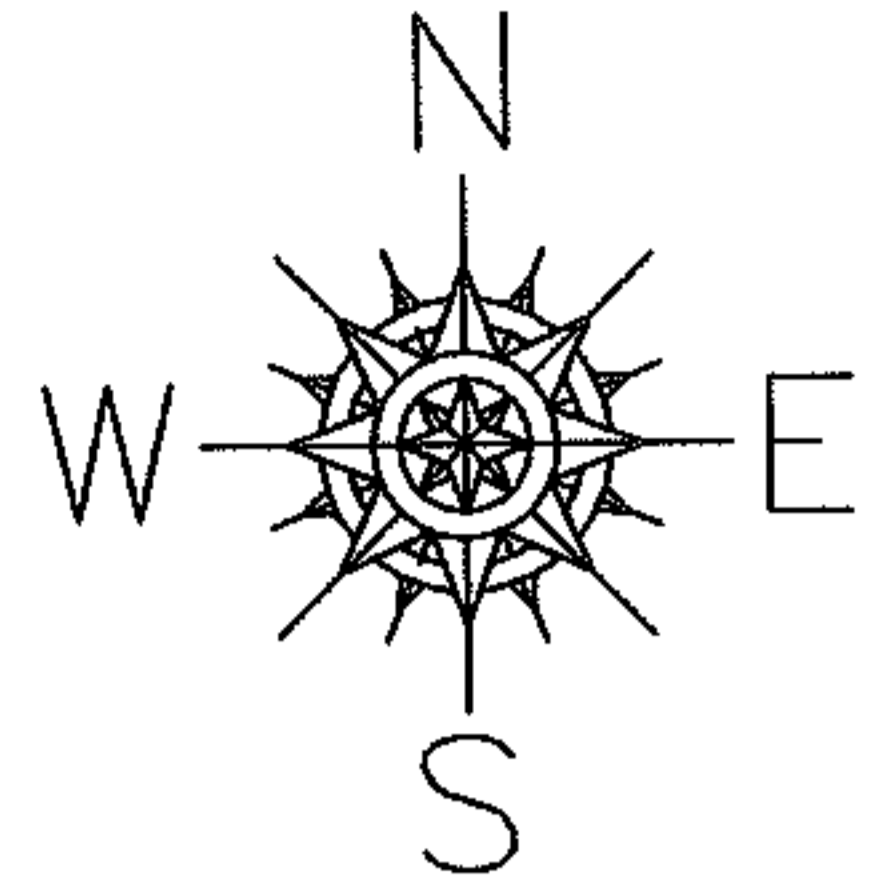

SPLITS/DEEDS PROCESSED

LORAIN COUNTY TAX MAP DEPARTMENT
226 MIDDLE AVE. ELYRIA, OHIO

SURVEYED BY: MARK A YEAGER

CLOSURE: 0.00 : 10.000

MAP PAGE(S): 12-00-046-B

APPROVED BY: JAH DATE: 3-7-05

SCALE: 1" = 100 PRIOR INSTRUMENT: OR 1112/857