
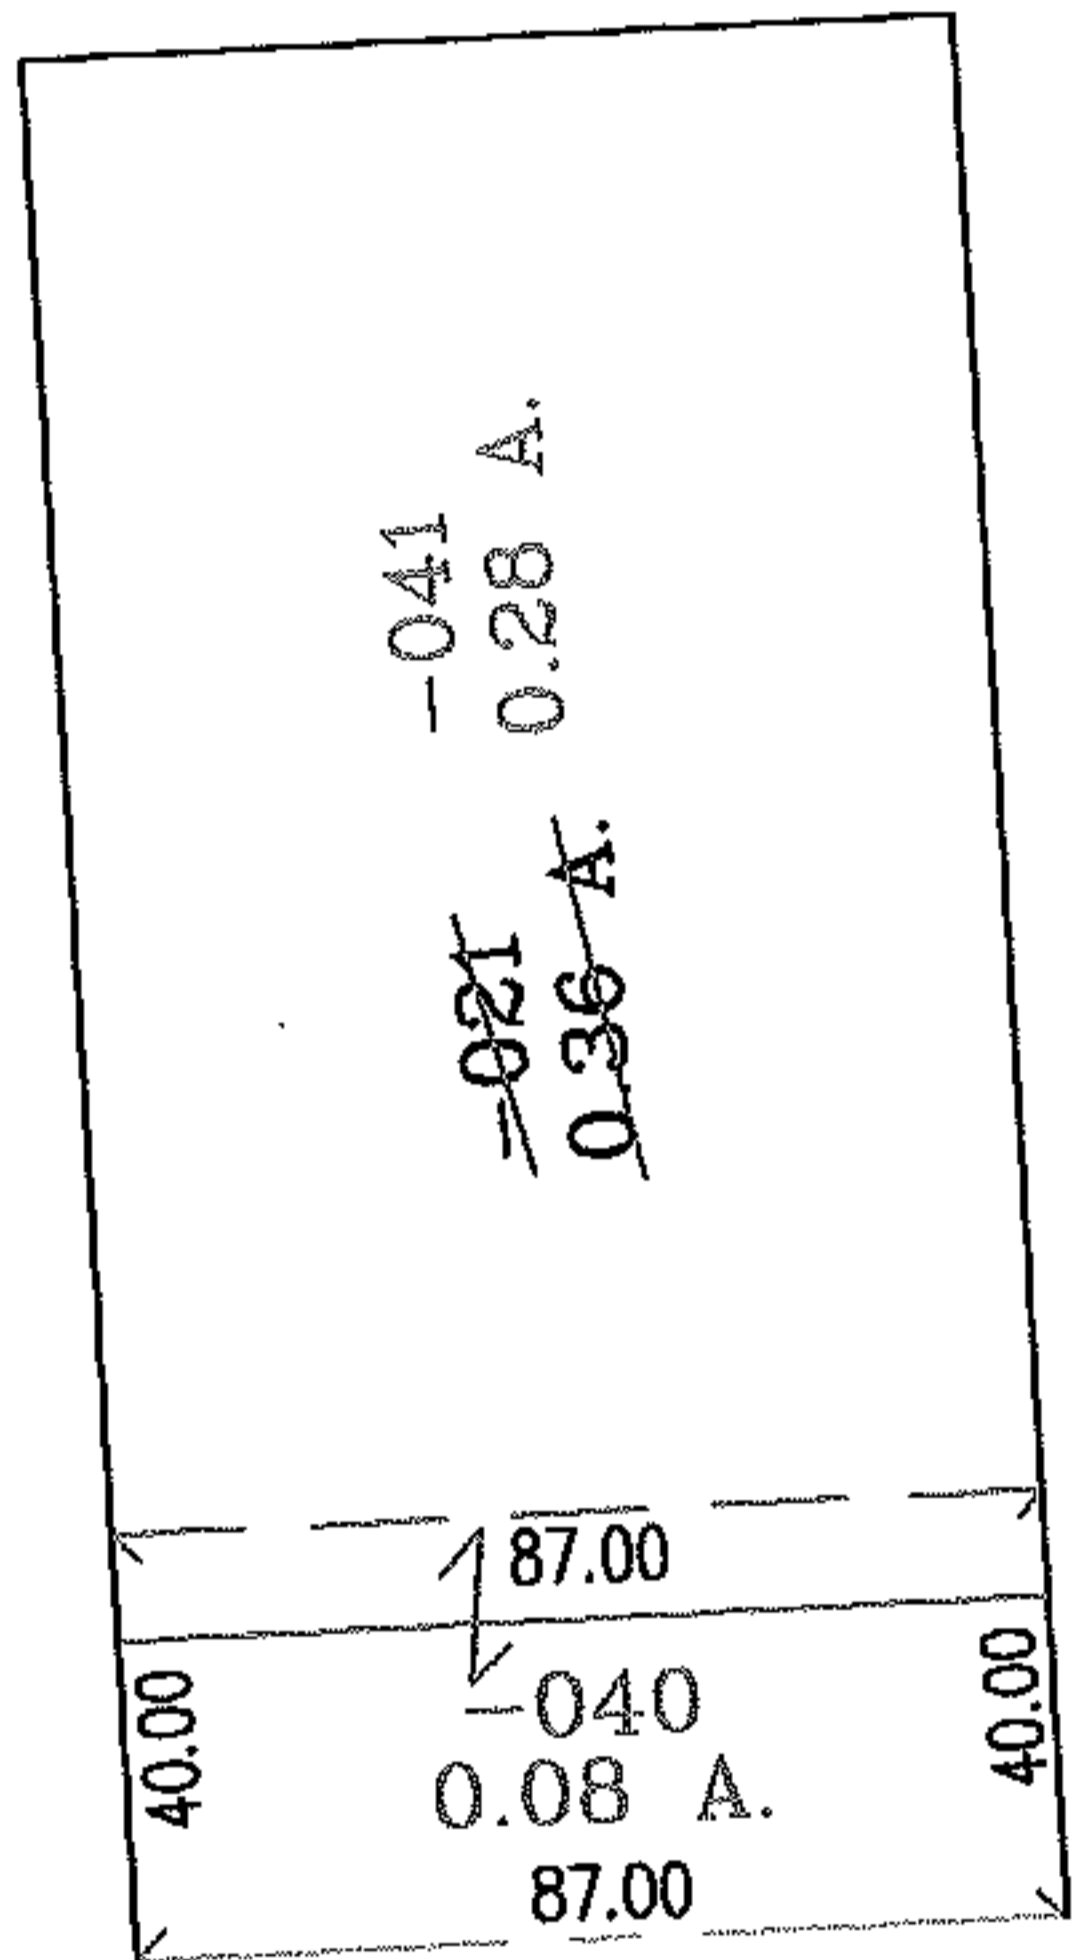


PARENT PARCEL: 12-00-045-000-021

CHILD PARCEL: 12-00-045-000-040, -041

STARTING POINT: INTERSECTION OF C/L OF S.R. 82 AND SOUTHEAST CORNER OF O.L. 45

NO. 00142

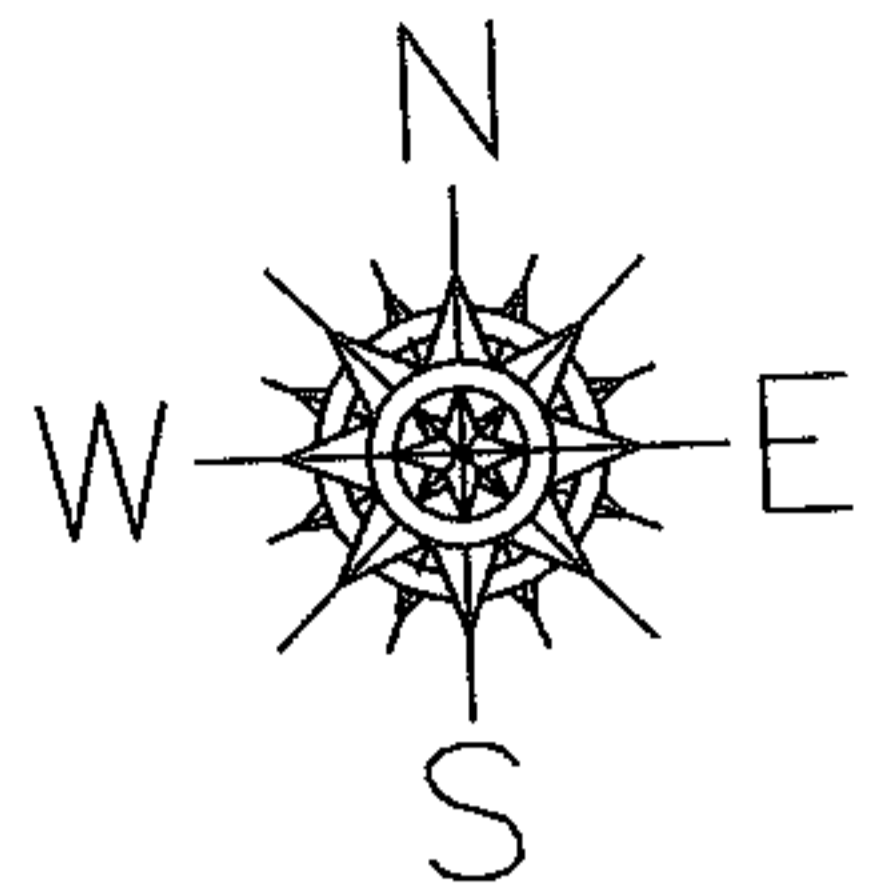


ELYRIA-TWINSBURG RD. (S.R. 82)

133.11

O.L. 46 | O.L. 45

O.L. 35 | O.L. 36

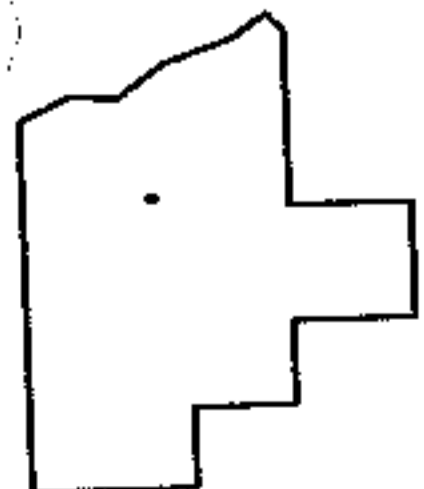

SPLITS/DEEDS PROCESSED

LORAIN COUNTY TAX MAP DEPARTMENT
226 MIDDLE AVE. ELYRIA, OHIO

SURVEYED BY: MARK ALLEN YEAGER

CLOSURE: .00:10.000

MAP PAGE(S): 12-00-045-B

APPROVED BY: RM/JH DATE: 3-8-05

SCALE: 1" = 50' PRIOR INSTRUMENT: OR 84/376