
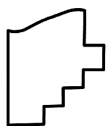


PARENT PARCEL: 04-00-010-113-101

CHILD PARCEL: **AC. CORR. PER PRIOR D.V. 1387 PG. 588**

STARTING POINT: N/A

22-05000-A

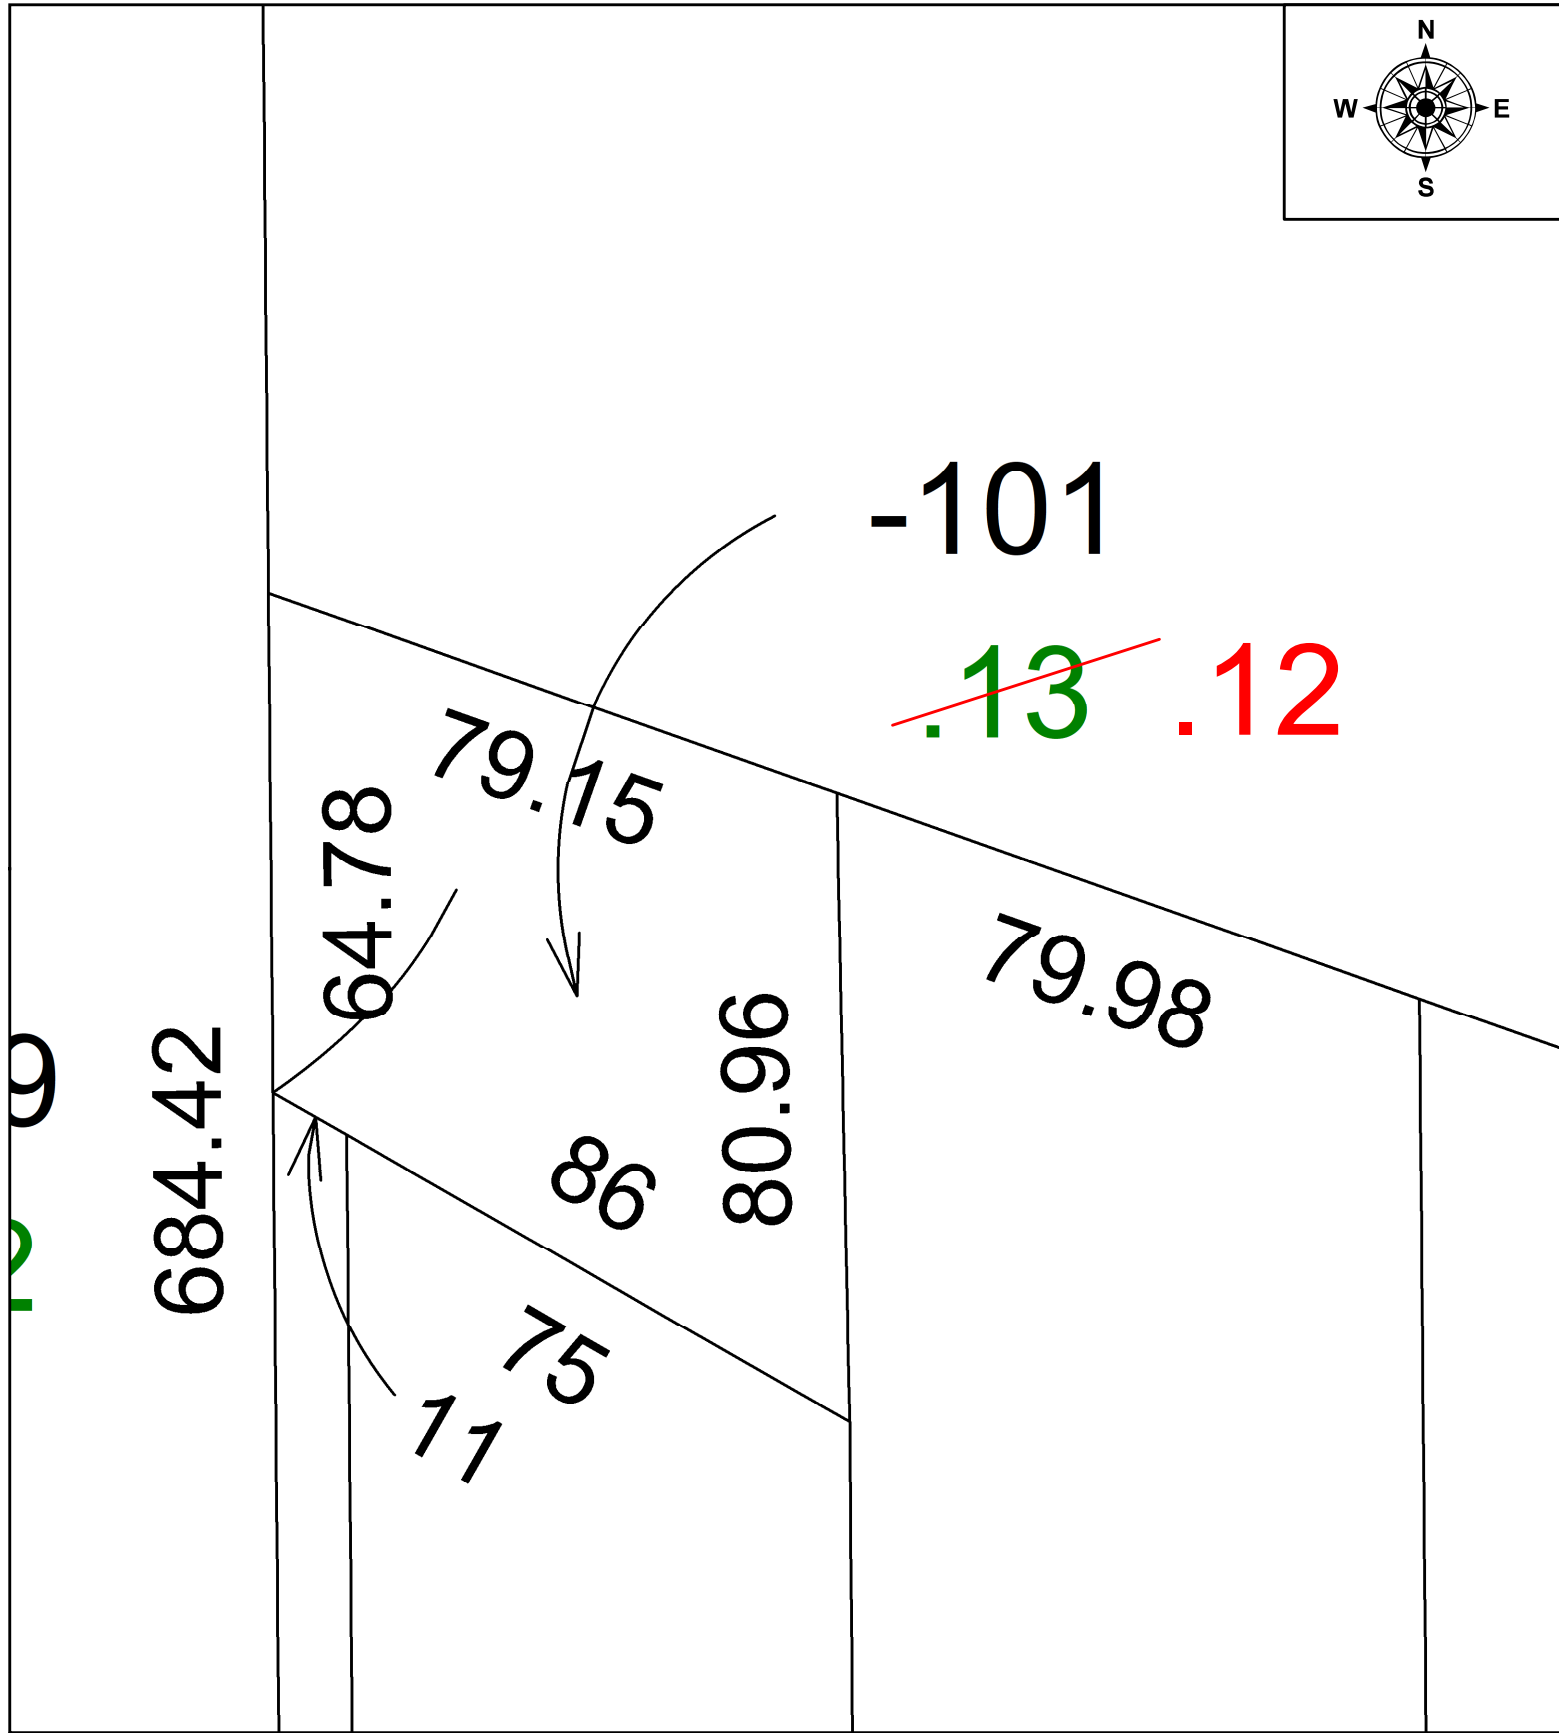

SPLITS/DEEDS PROCESSED
LORAIN COUNTY TAX MAP DEPARTMENT
226 MIDDLE AVE. ELYRIA, OH

SURVEYED BY: N/A SURVEY #: N/A
CLOSURE: N/A
MAP PAGE(S): 04-00-010
APPROVED BY: DMA DATE: 12/21/2022
SCALE: 1" = 25' PRIOR INSTRUMENT: D.V. 1387 pg. 588