
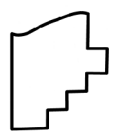


PARENT PARCEL: 21-02-010-000-001 & 21-02-007-000-004 & 21-02-007-000-002 &
21-02-006-000-001 & 21-02-006-000-003 & 21-02-005-000-002
CHILD PARCEL: 21-02-007-000-005 & 21-02-006-000-009. AC CORR FOR 21-02-010-000-001 & 21-02-005-000-002
STARTING POINT: SE CORNER OF LOT 33

25-05000

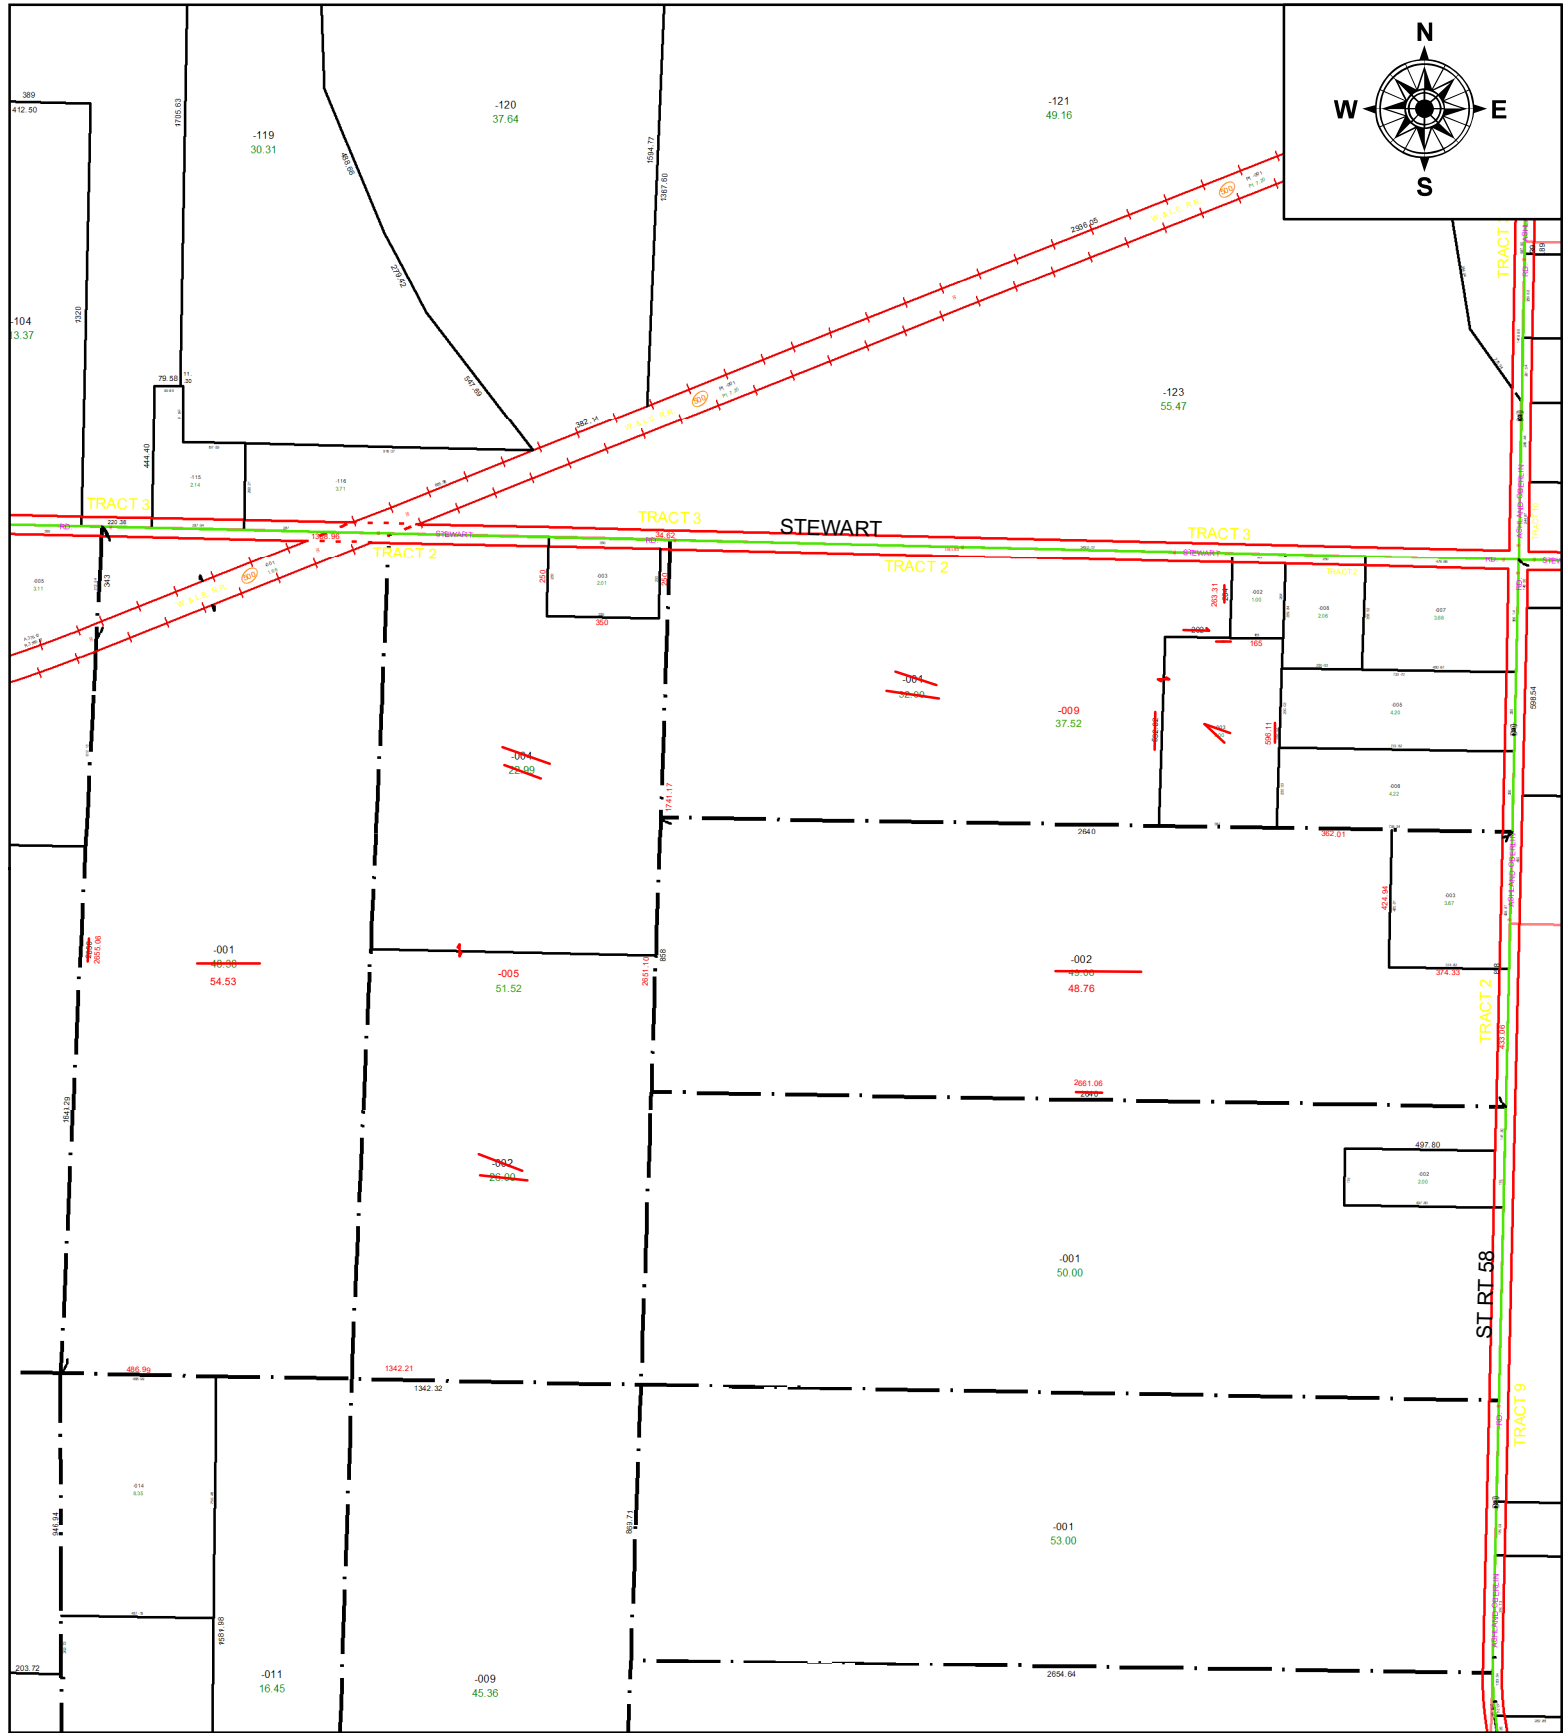

SPLITS/DEEDS PROCESSED
LORAIN COUNTY TAX MAP DEPARTMENT
226 MIDDLE AVE. ELYRIA, OH

SURVEYED BY: NATHANIEL B. RAMSEY SURVEY #: 51433
CLOSURE: 1: 12469054
MAP PAGE(S): 0500026
APPROVED BY: BB DATE: 4/23/2025
SCALE: 1" = 600' PRIOR INSTRUMENT: #20240013591