
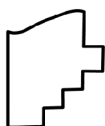
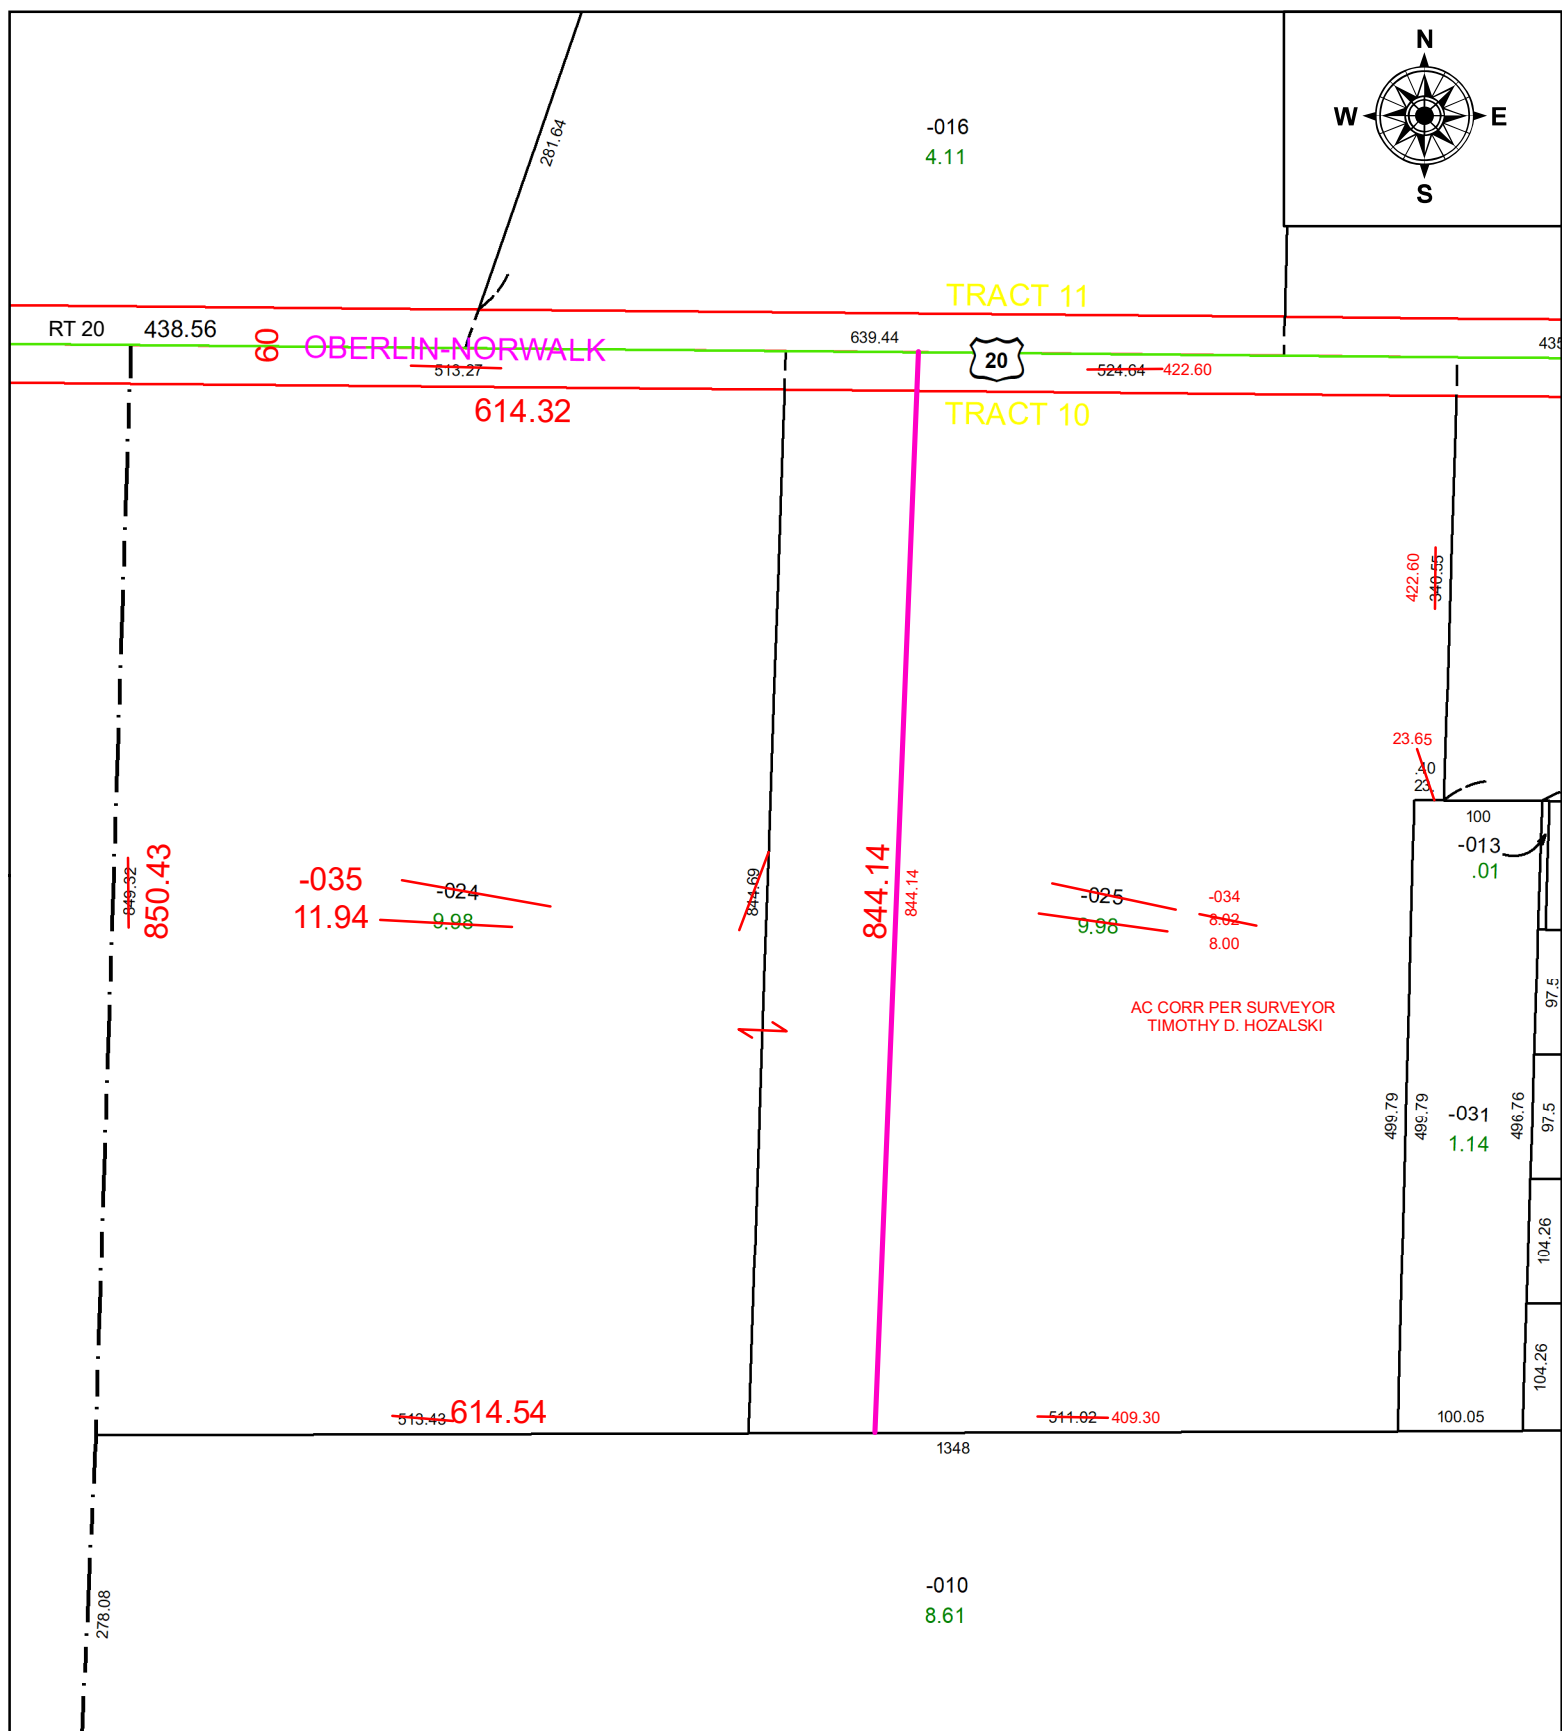


25-05003

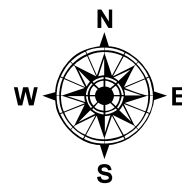

SURVEYED BY: TIMOTHY D. HOZALSKI **SURVEY #:** 51439
CLOSURE: 1: 987131
MAP PAGE(S): 13-10-003
APPROVED BY: BB **DATE:** 4/30/2025
SCALE: 1" = 150' **PRIOR INSTRUMENT:** #20160604409