
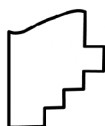


STARTING POINT: SW CORNER OF O/L 96

25-05006

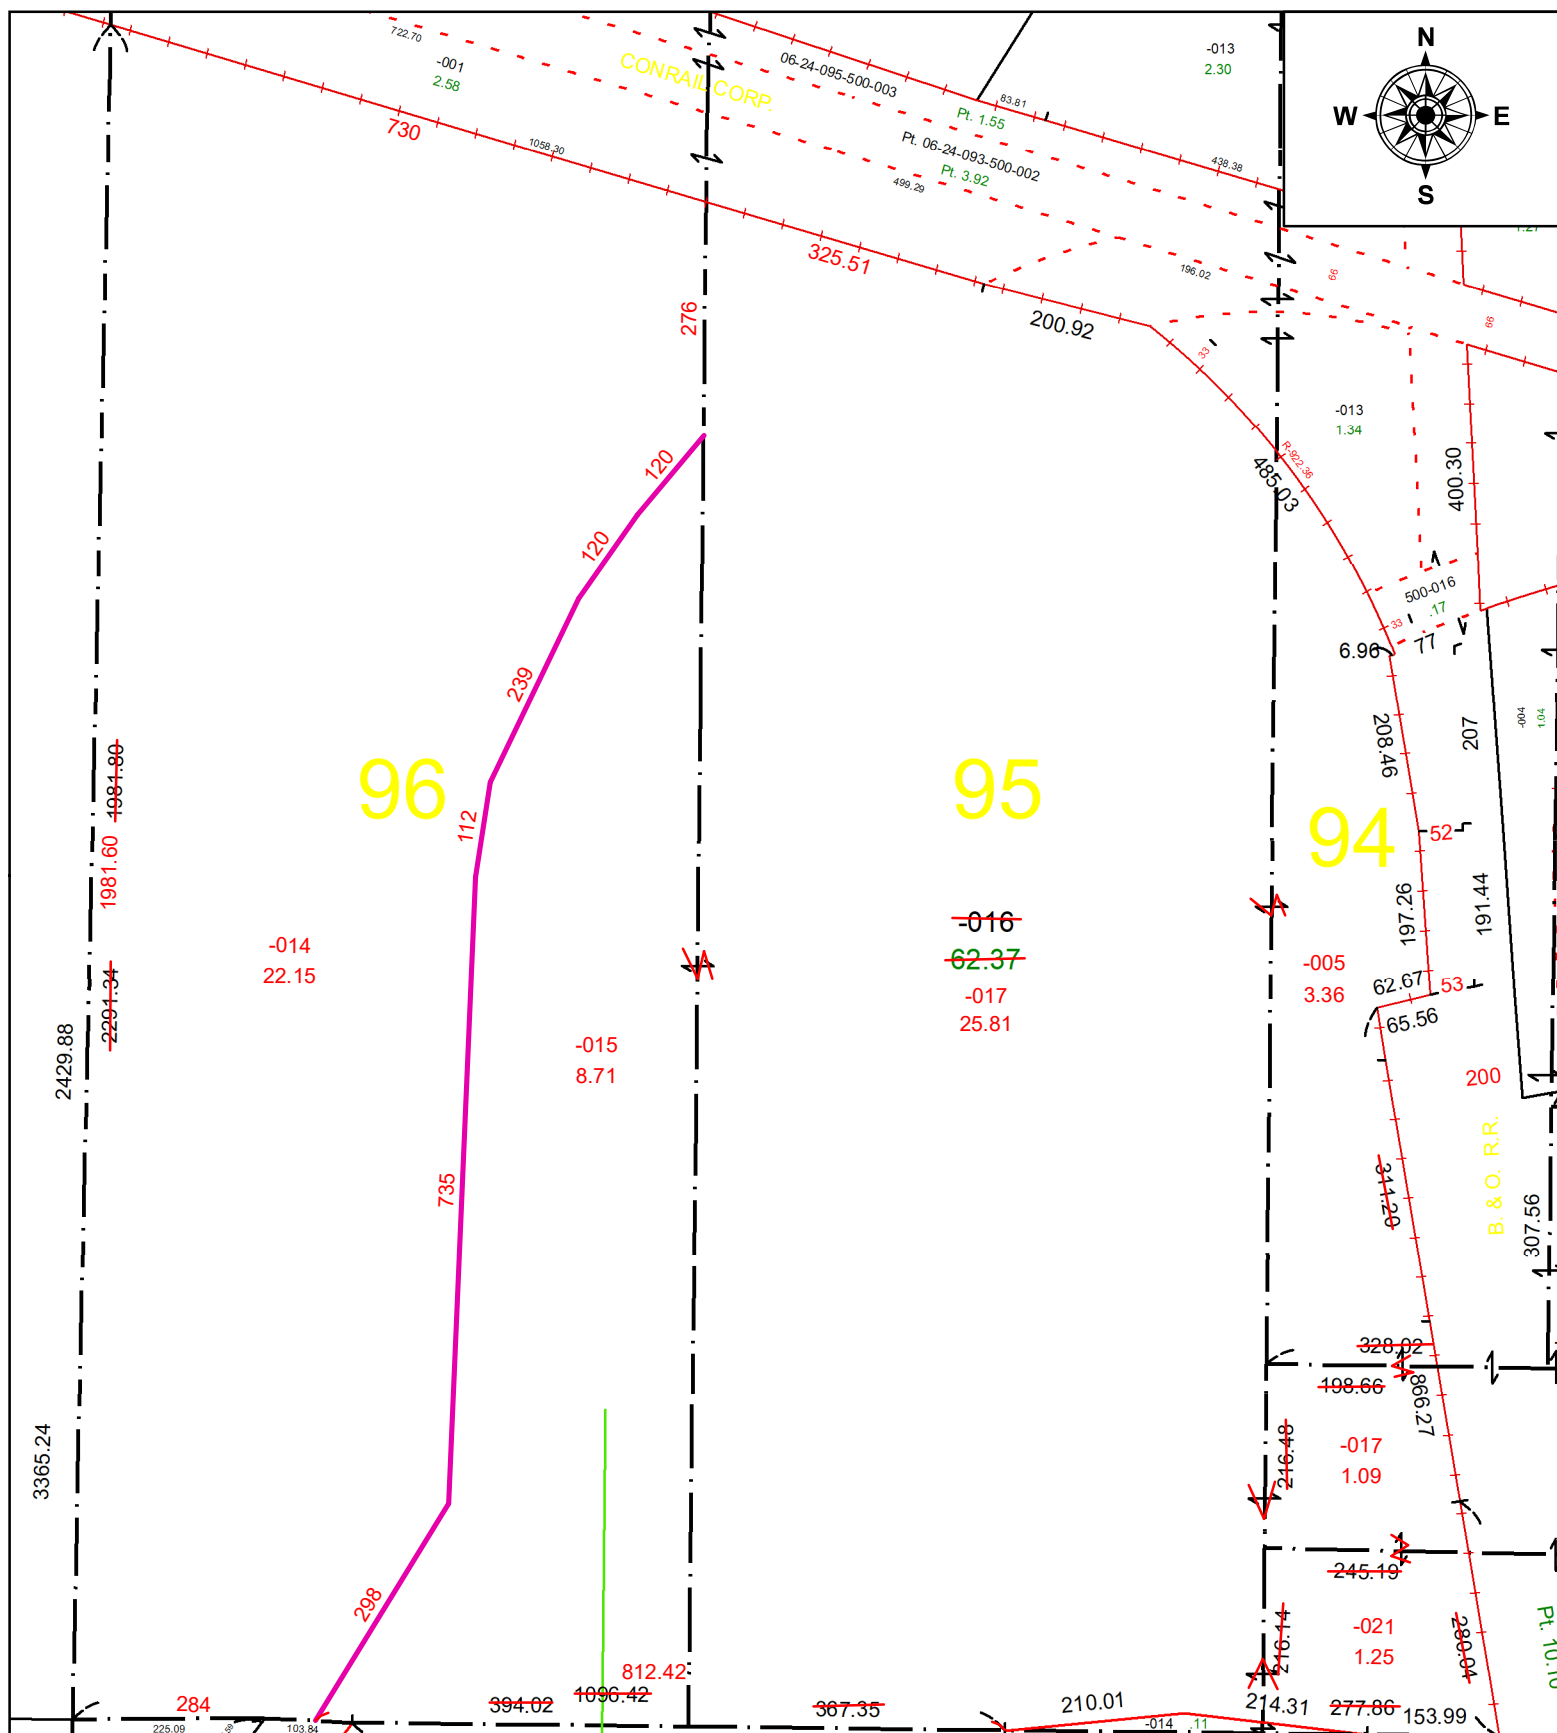

SPLITS/DEEDS PROCESSED

LORAIN COUNTY TAX MAP DEPARTMENT
226 MIDDLE AVE. ELYRIA, OH

SURVEYED BY: TREVOR A. BIXLER

SURV # 51443

CLOSURE: 1: 839063

MAP PAGE(S): 06-24

APPROVED BY: AC **DATE:** May 06, 2025

SCALE: 1 in = 225 ft **PRIOR INSTRUMENT:** 2019- 0737007