
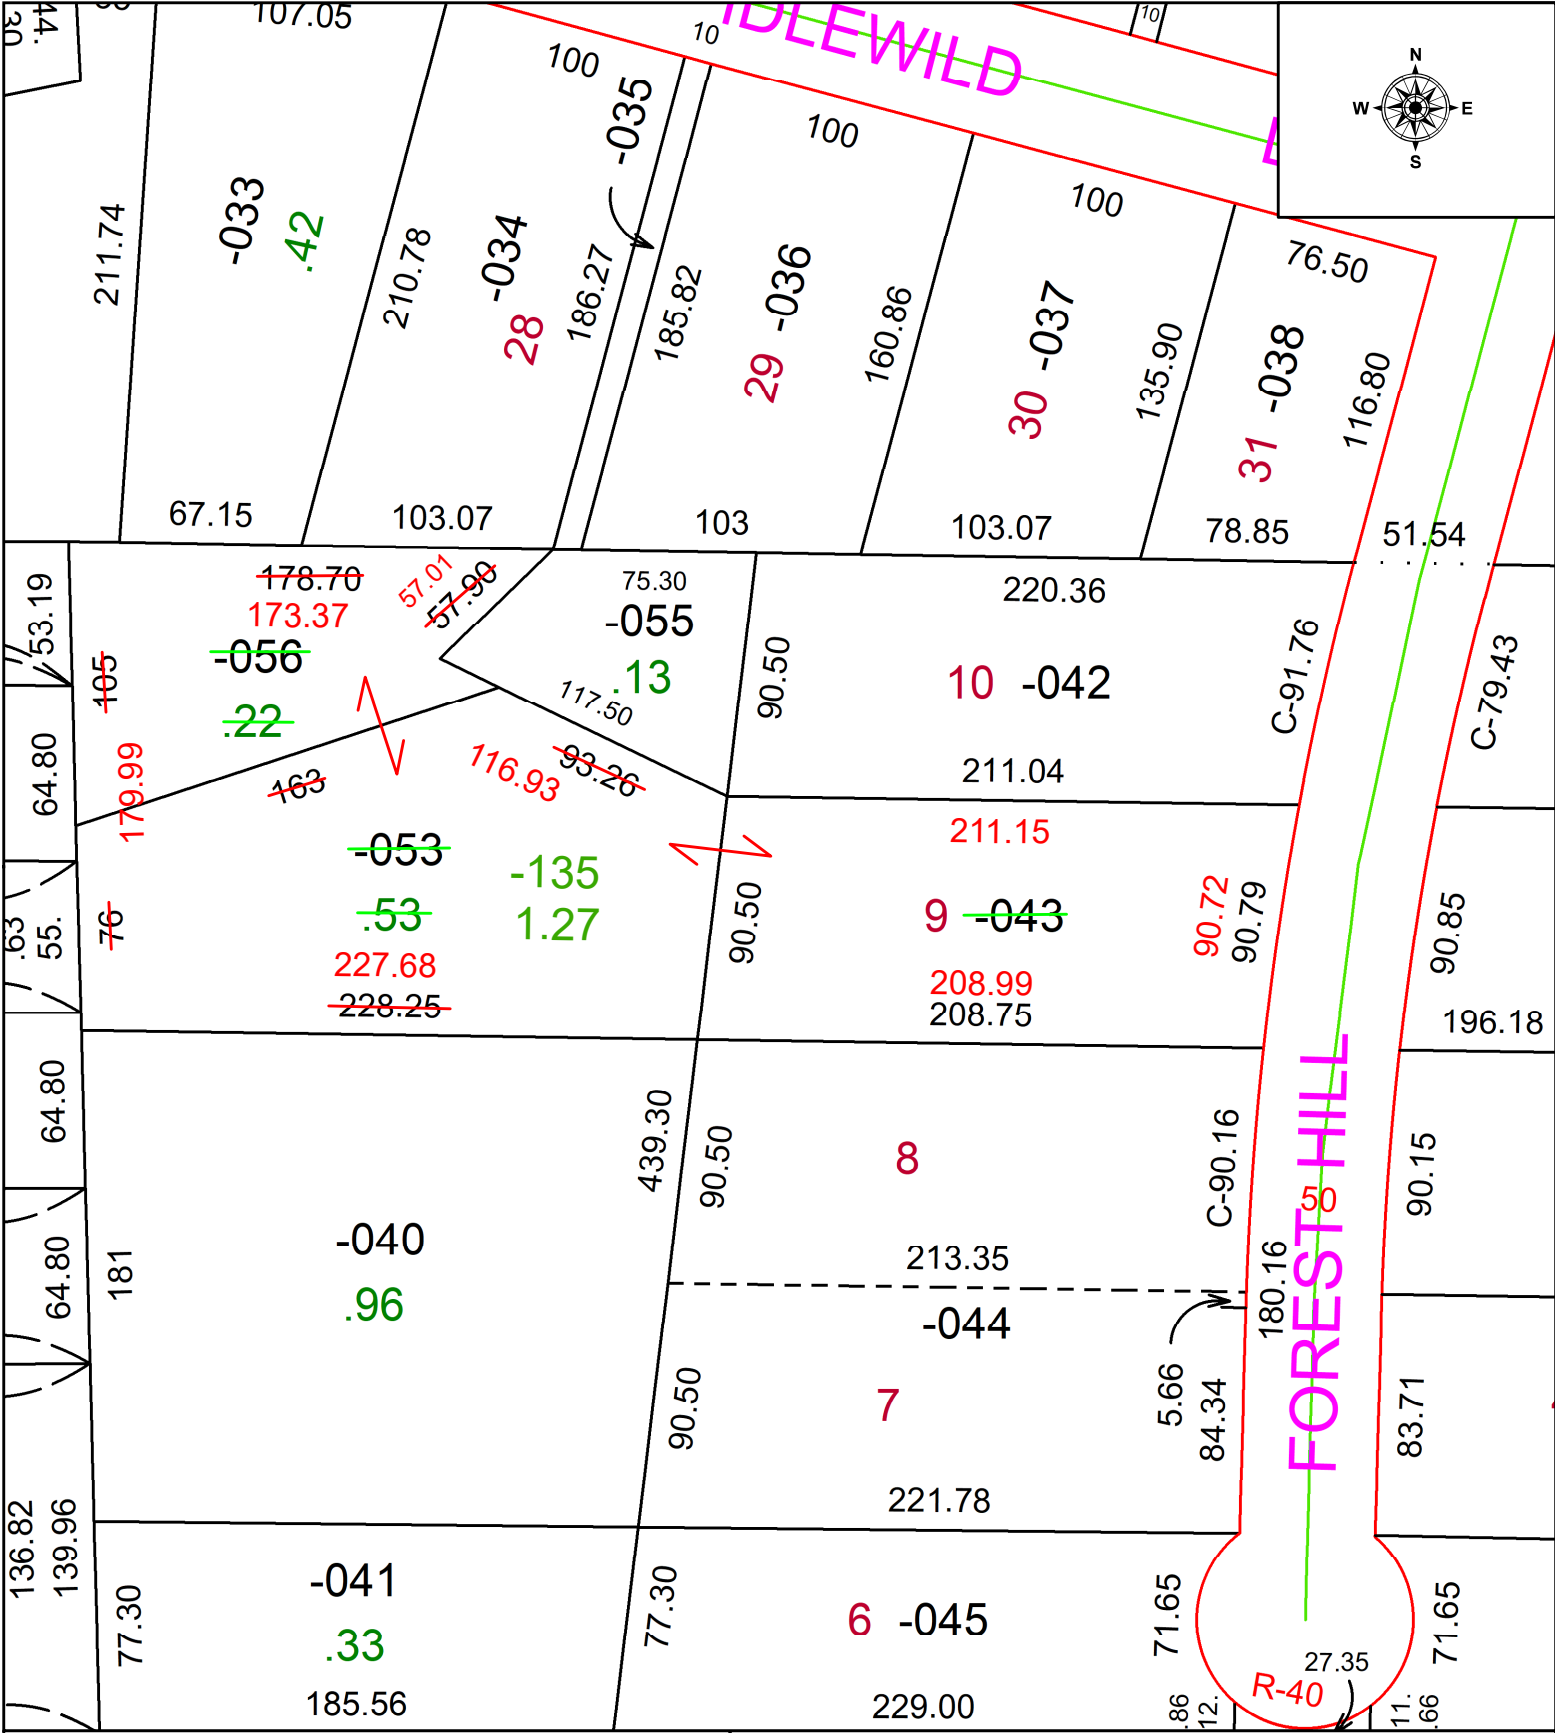


PARENT PARCEL: 05-00-025-101-043, -053, & -056
CHILD PARCEL: 05-00-025-101-135
STARTING POINT: SOUTHEASTERLY CORNER OF S/L 31 IN FOREST HILLS ALLOTMENT NO. 2

25-05007

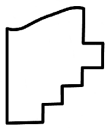

**SPLITS/DEEDS PROCESSED**
LORAIN COUNTY TAX MAP DEPARTMENT
226 MIDDLE AVE. ELYRIA, OH

SURVEYED BY: SCOTT CASEY SURVEY # 51445
CLOSURE: 1: 112078
MAP PAGE(S): 05-00-025
APPROVED BY: WRZ **DATE:** 5/8/2025
SCALE: 1" = 850 **PRIOR INSTRUMENT:** #2011-0385840