


PARENT PARCEL: 05-00-081-000-035 & -038
CHILD PARCEL: 05-00-081-000-041 & -042 & -043 & -044 & -045
STARTING POINT: C/L OD COOPER FOSTER PARK DR EASTERLY LINE OF AND OL 81

25-05011

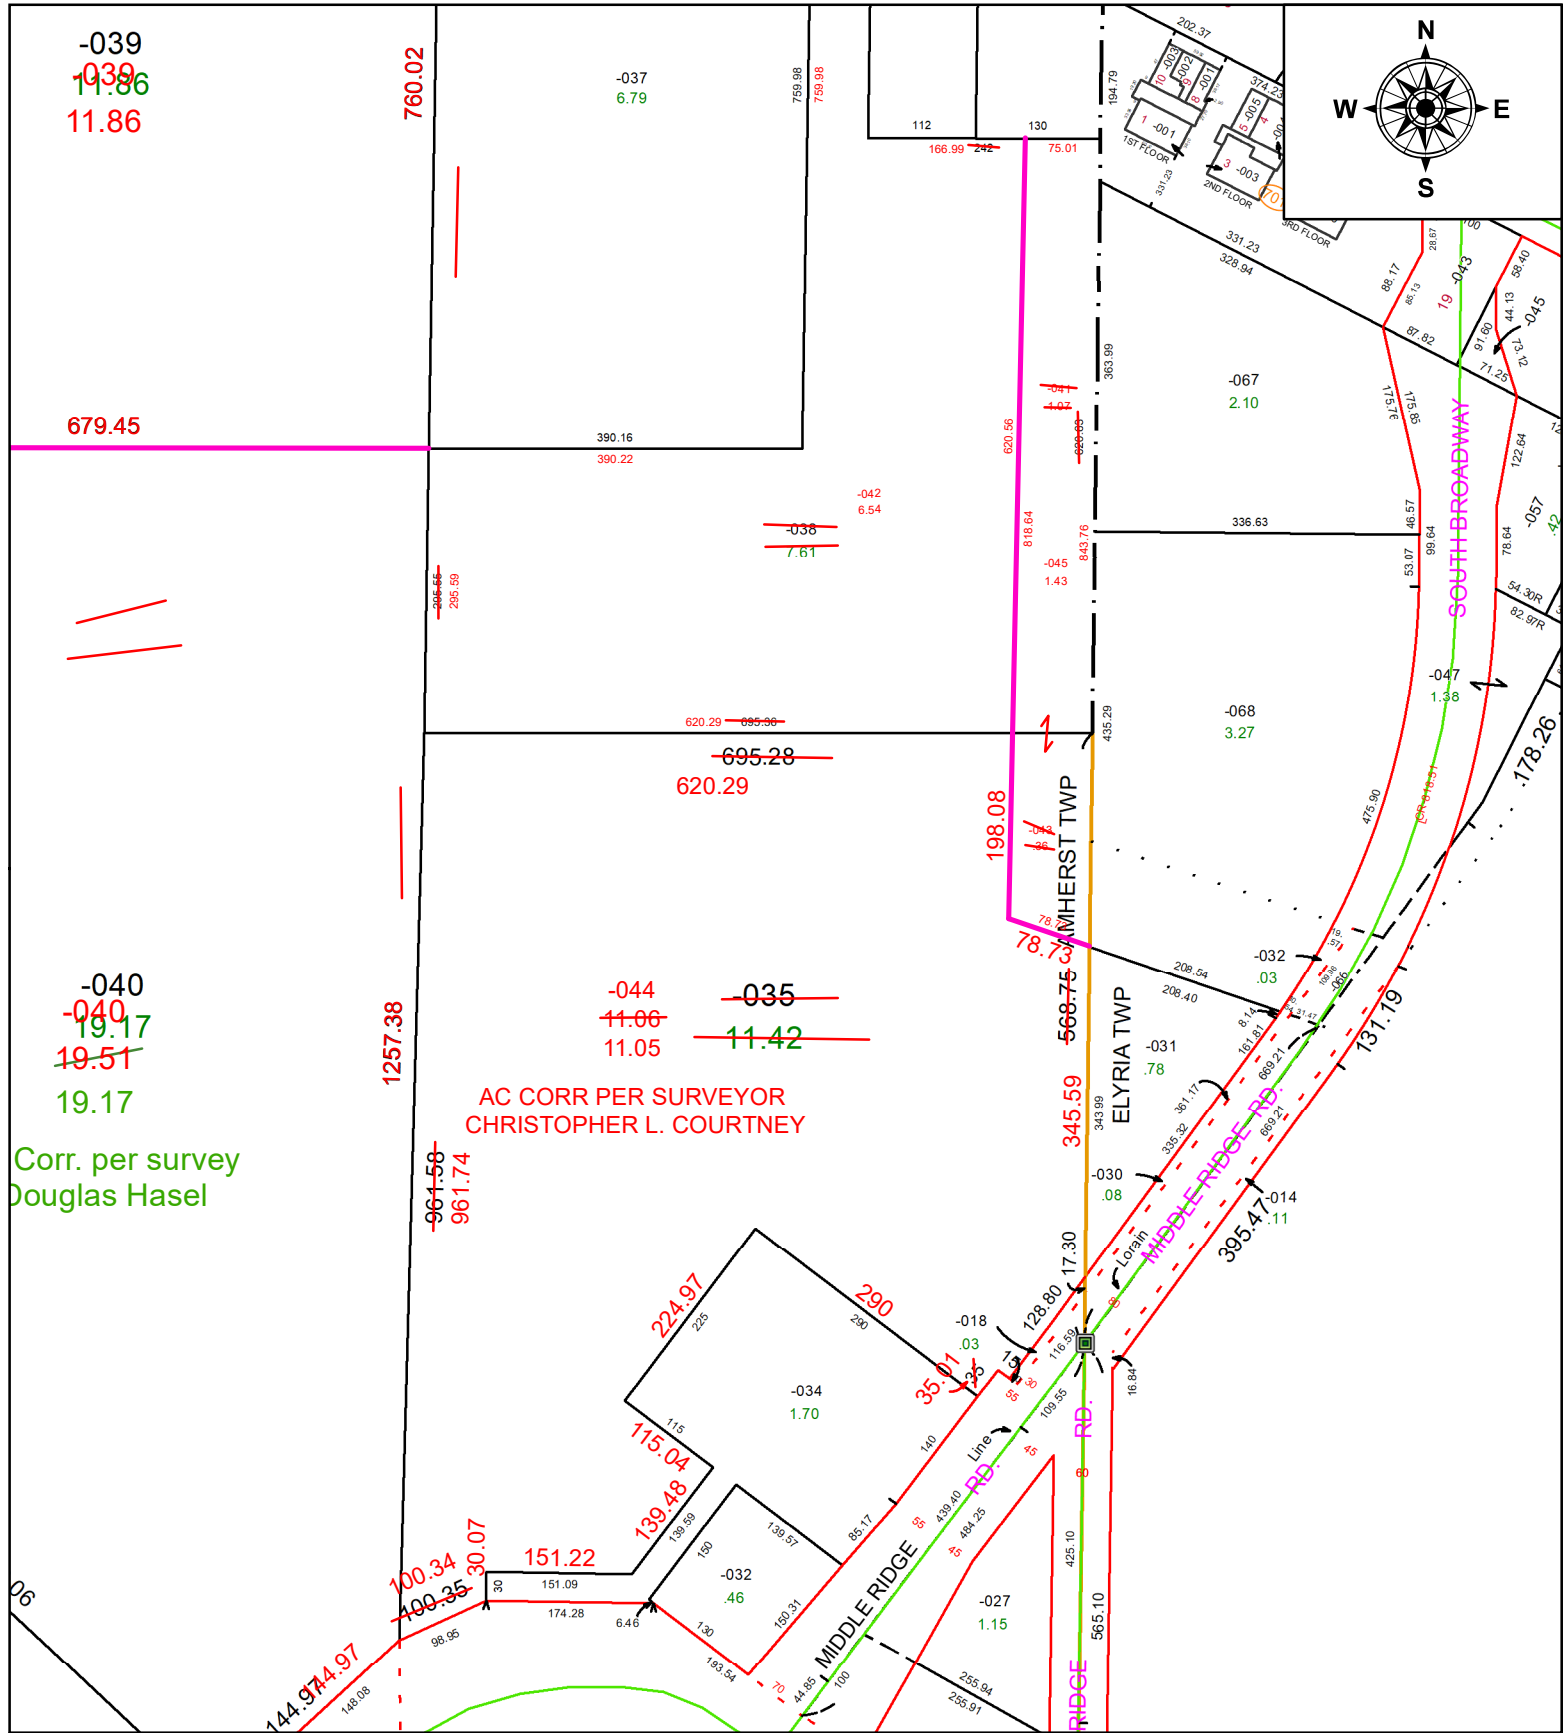

SPLITS/DEEDS PROCESSED
LORAIN COUNTY TAX MAP DEPARTMENT
226 MIDDLE AVE. ELYRIA, OH

SURVEYED BY: CHRISTOPHER L. COURTNEY **SURVEY #:** 51449
CLOSURE: 1: 248181
MAP PAGE(S): 05-00-081
APPROVED BY: BB **DATE:** 5/19/2025
SCALE: 1" = 200' **PRIOR INSTRUMENT:** #20000697287