
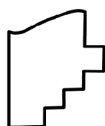
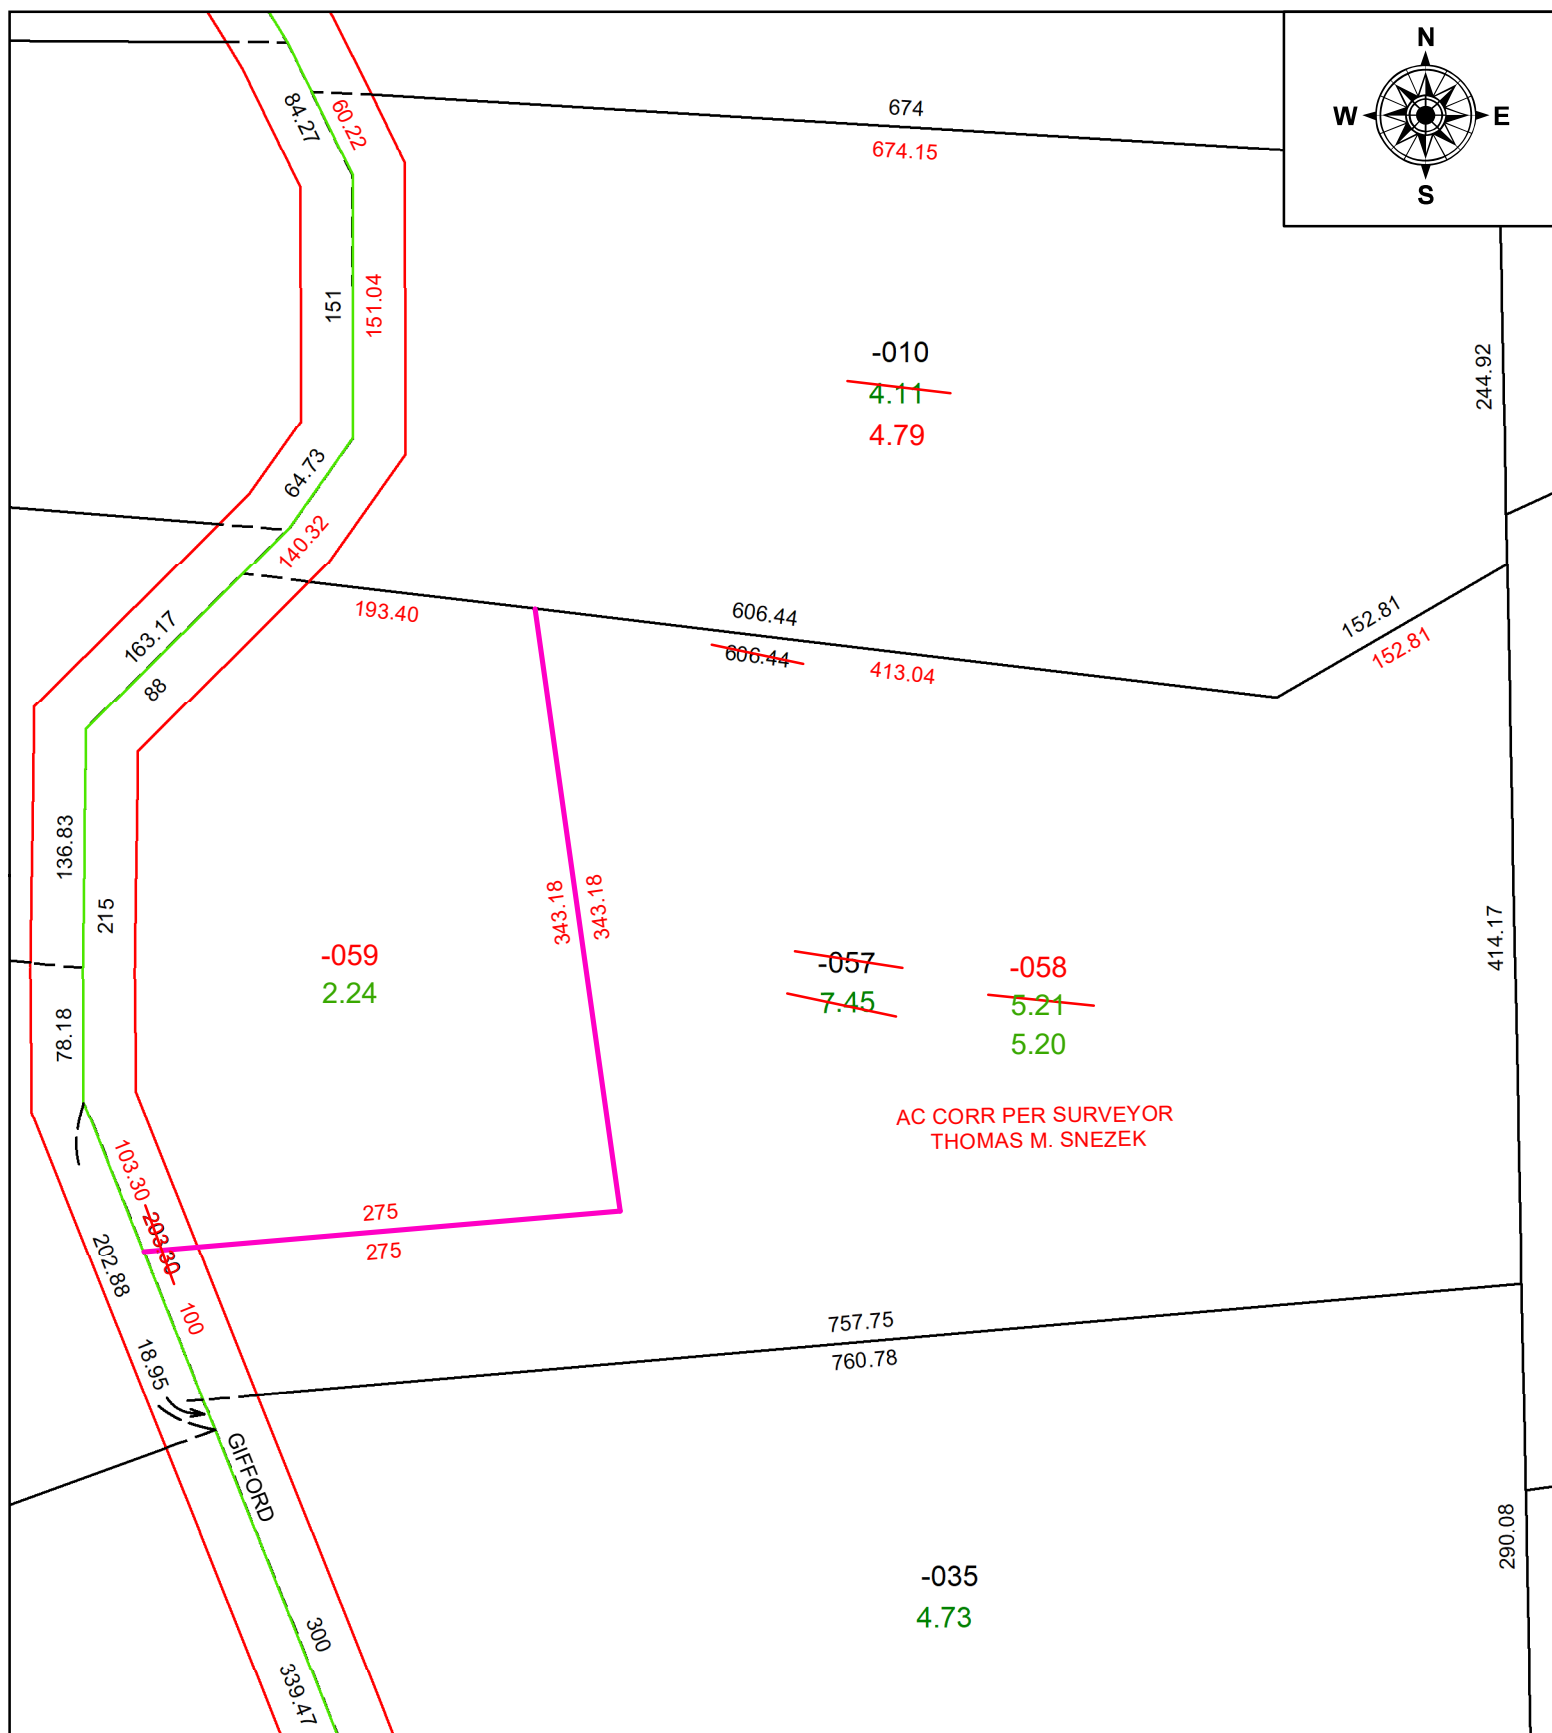


25-05012

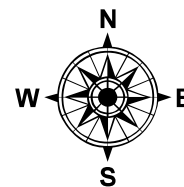

LORAIN COUNTY TAX MAP DEPARTMENT
226 MIDDLE AVE. ELYRIA, OH

SURVEYED BY: THOMAS M. SNEZEK **SURVEY #:** 51444
CLOSURE: 1: 770431
MAP PAGE(S): 08-00-086
APPROVED BY: BB **DATE:** 5/21/2025
SCALE: 1" = 110' **PRIOR INSTRUMENT:** #20240026280