
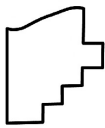


PARENT PARCEL: 19-02-004-000-001 & -002, 19-02-005-000-002 & -003

CHILD PARCEL: N/A ACREAGE CORRECTION PER SURVEYOR MARK PURDY

STARTING POINT: NORTHEAST CORNER OF O.L. 5 & NORTHWEST CORNER OF O.L. 4 ON NORTH LINE TRACT 2

23-05014-C

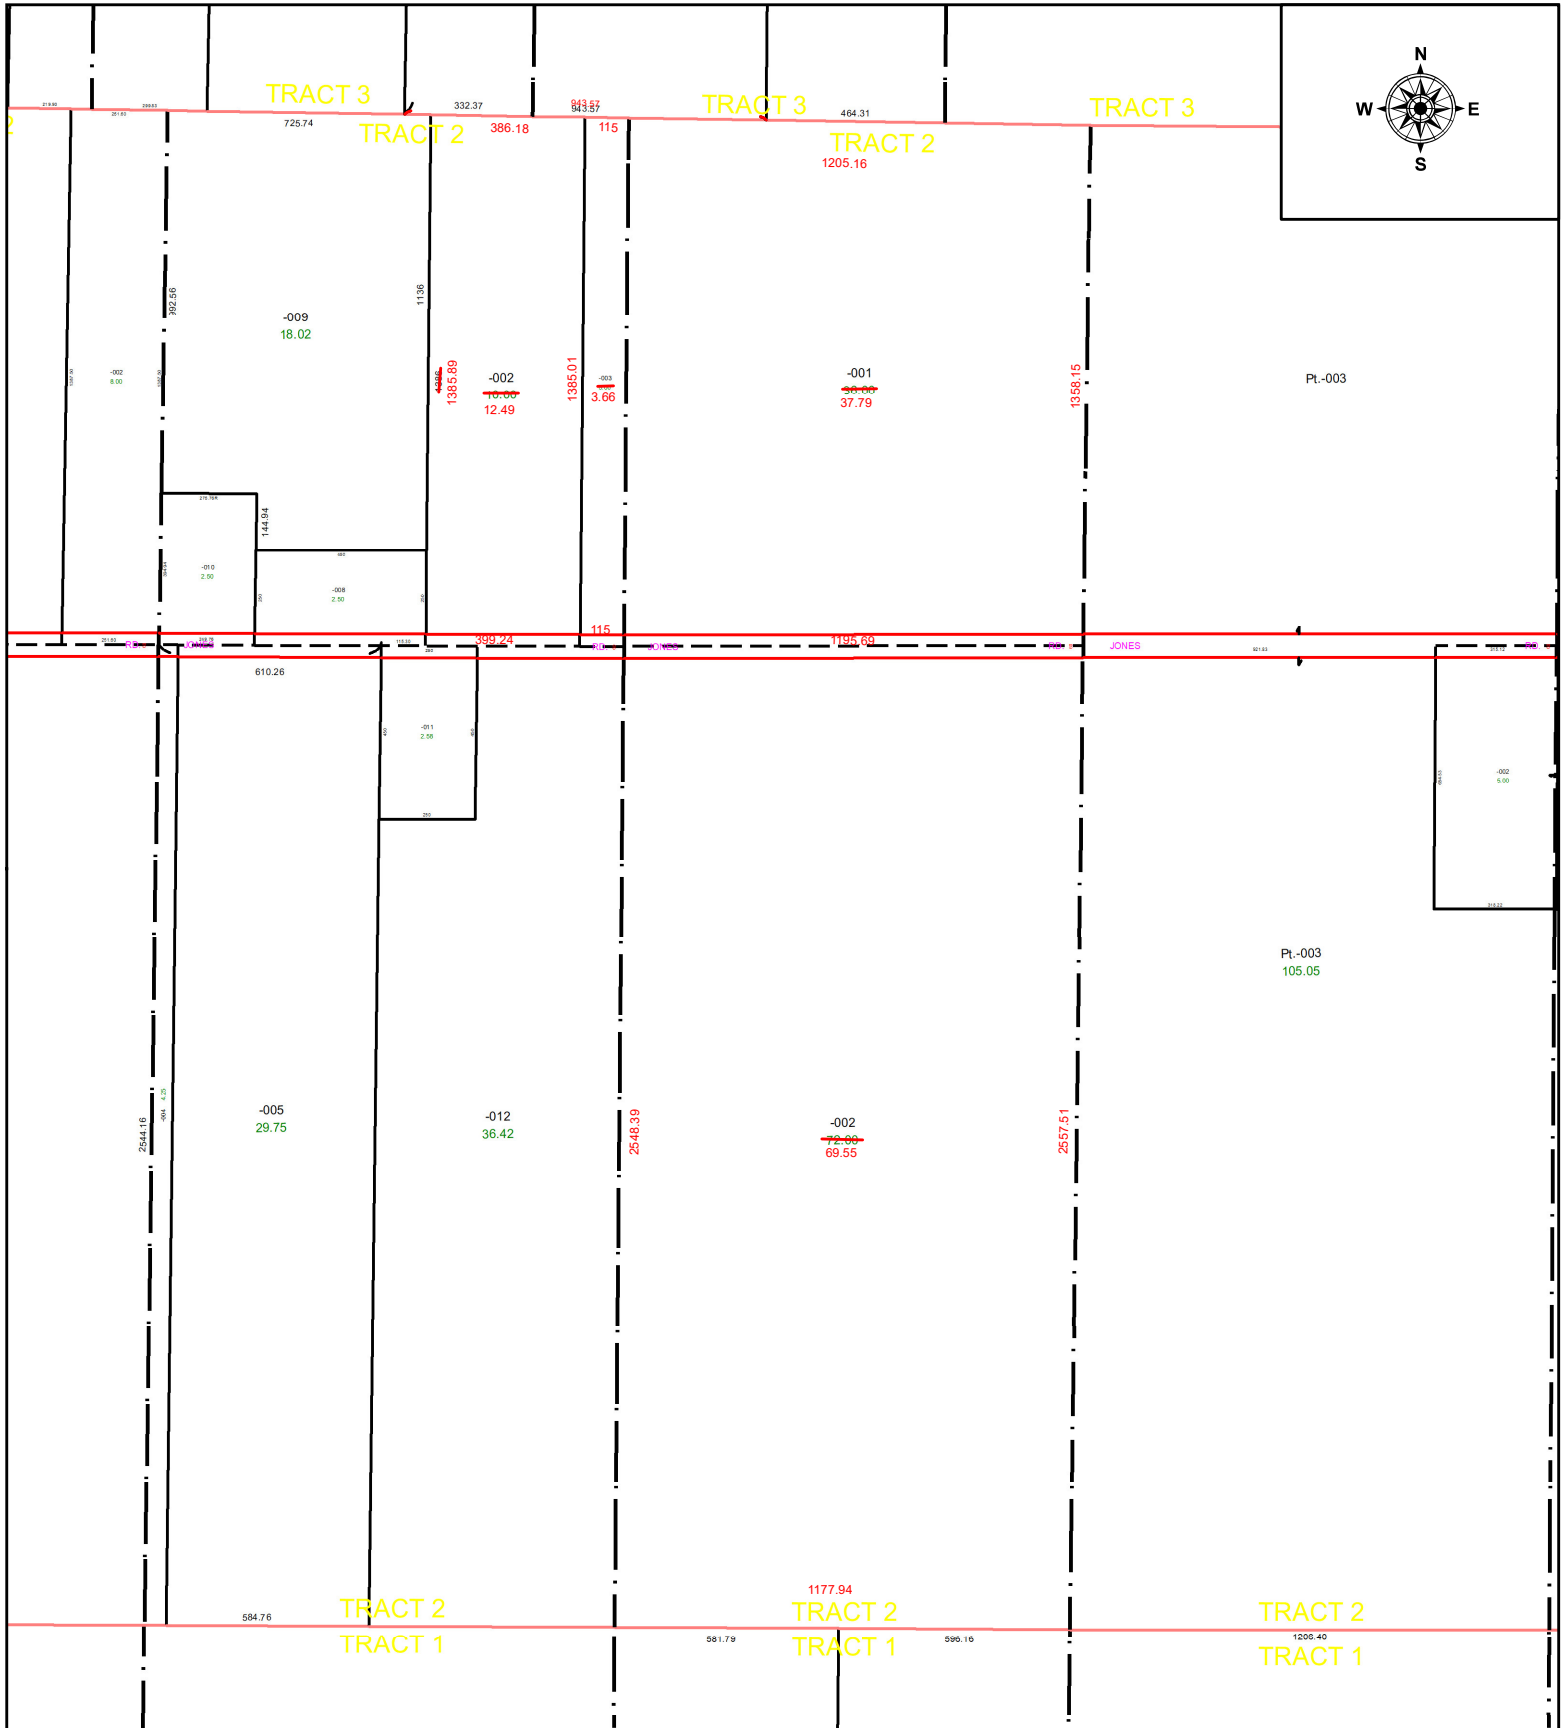

SPLITS/DEEDS PROCESSED
 LORAIN COUNTY TAX MAP DEPARTMENT
 226 MIDDLE AVE. ELYRIA, OH

SURVEYED BY: MARK PURDY SURVEY # 50783
 CLOSURE: 1: 794182
 MAP PAGE(S): 19-02-004 & 19-02-005
 APPROVED BY: WRZ DATE: 1/13/2023
 SCALE: 1" = 500 PRIOR INSTRUMENT: OR 958/913