


PARENT PARCEL: 02-01-004-102-006 & -007



CHILD PARCEL: **FRONT & DEPTH TO AC CORR PER SURV BY MATTHEW A. HILDEBRANDT**

23-05036-C

STARTING POINT: S LINE OF W 4TH ST AND W LINE OF BROADWAY AVE

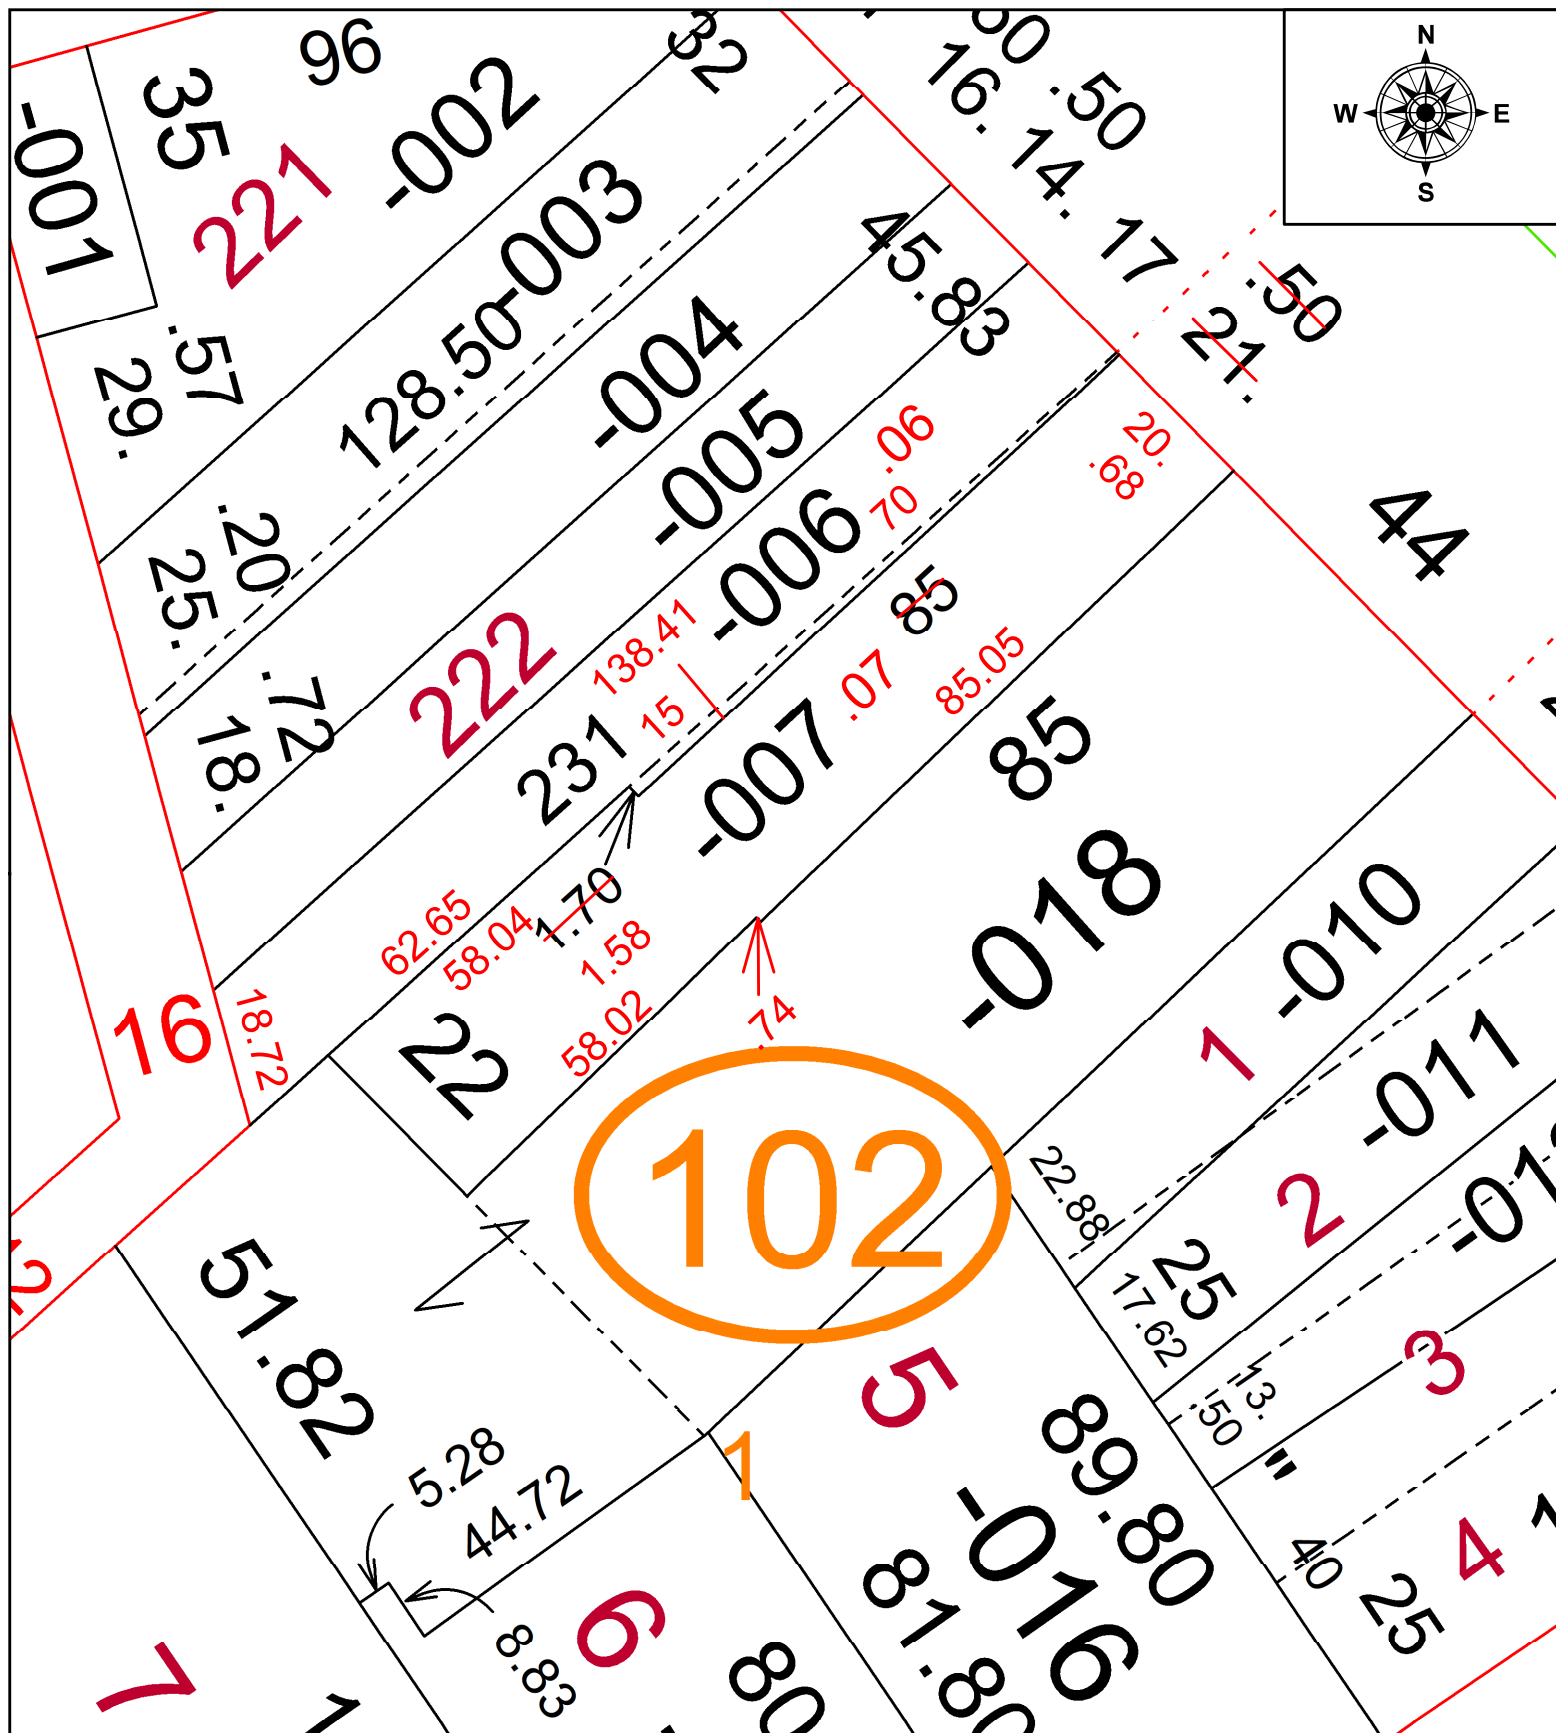

102

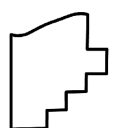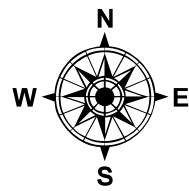

SPLITS/DEEDS PROCESSED
 LORAIN COUNTY TAX MAP DEPARTMENT
 226 MIDDLE AVE. ELYRIA, OH

SURVEYED BY: MATTHEW A. HILDEBRANDT SURV # 50818
 CLOSURE: 1: 294372
 MAP PAGE(S): 02-01-004-B
 APPROVED BY: AC DATE: February 22, 2023
 SCALE: 1 in = 25 ft PRIOR INSTRUMENT: 2021- 0804567