


PARENT PARCEL: 06-24-026-101-007



CHILD PARCEL: **MAP CORRECTION ONLY**

STARTING POINT: C/L OF PENFIELD AND BELL AVE

23-05042-C

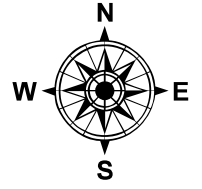

247R

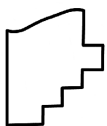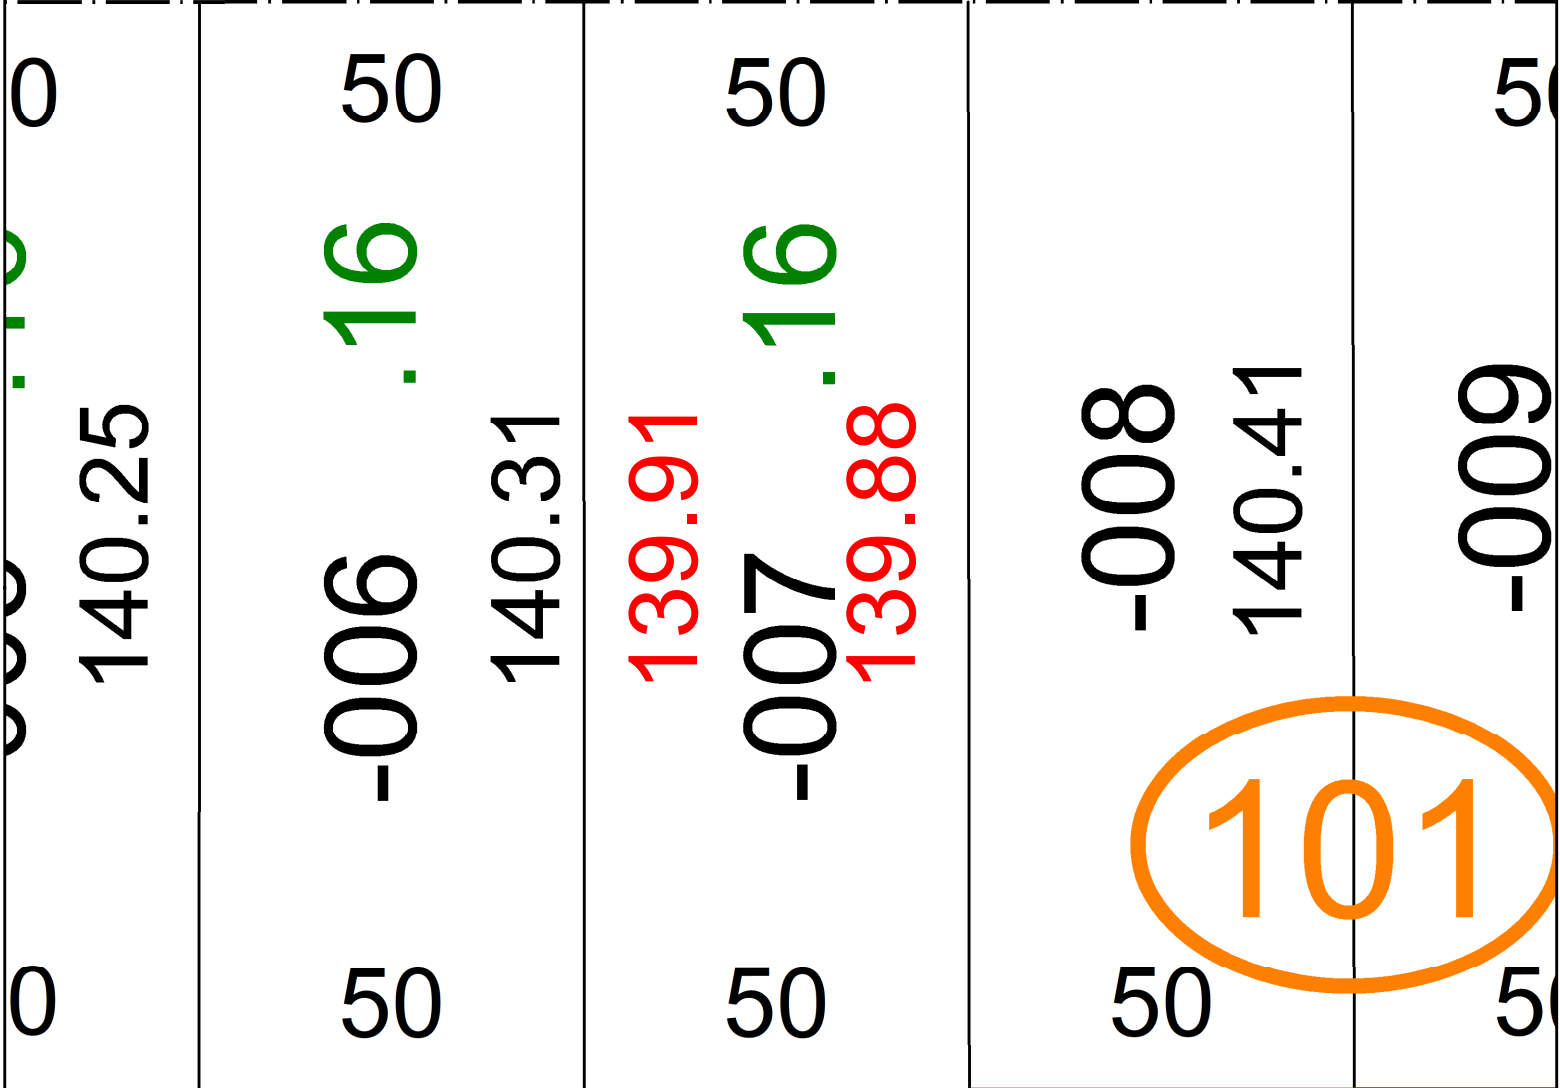

**SPLITS/DEEDS PROCESSED**  
 LORAIN COUNTY TAX MAP DEPARTMENT  
 226 MIDDLE AVE. ELYRIA, OH

SURVEYED BY: THOMAS A. SIMON SURV # 50830

CLOSURE: 1: 122796

MAP PAGE(S): 06-79

APPROVED BY: AC DATE: March 06, 2023

SCALE: 1 in = 25 ft PRIOR INSTRUMENT: 2017- 0636847