
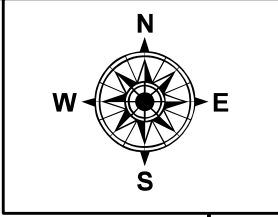


PARENT PARCEL: 12-00-084-102-022

CHILD PARCEL: **AC. CORR. PER SURVEY RICHARD METZKER**

STARTING POINT: CL OF ROOT RD. & OSBORNE RD.

23-05044-A

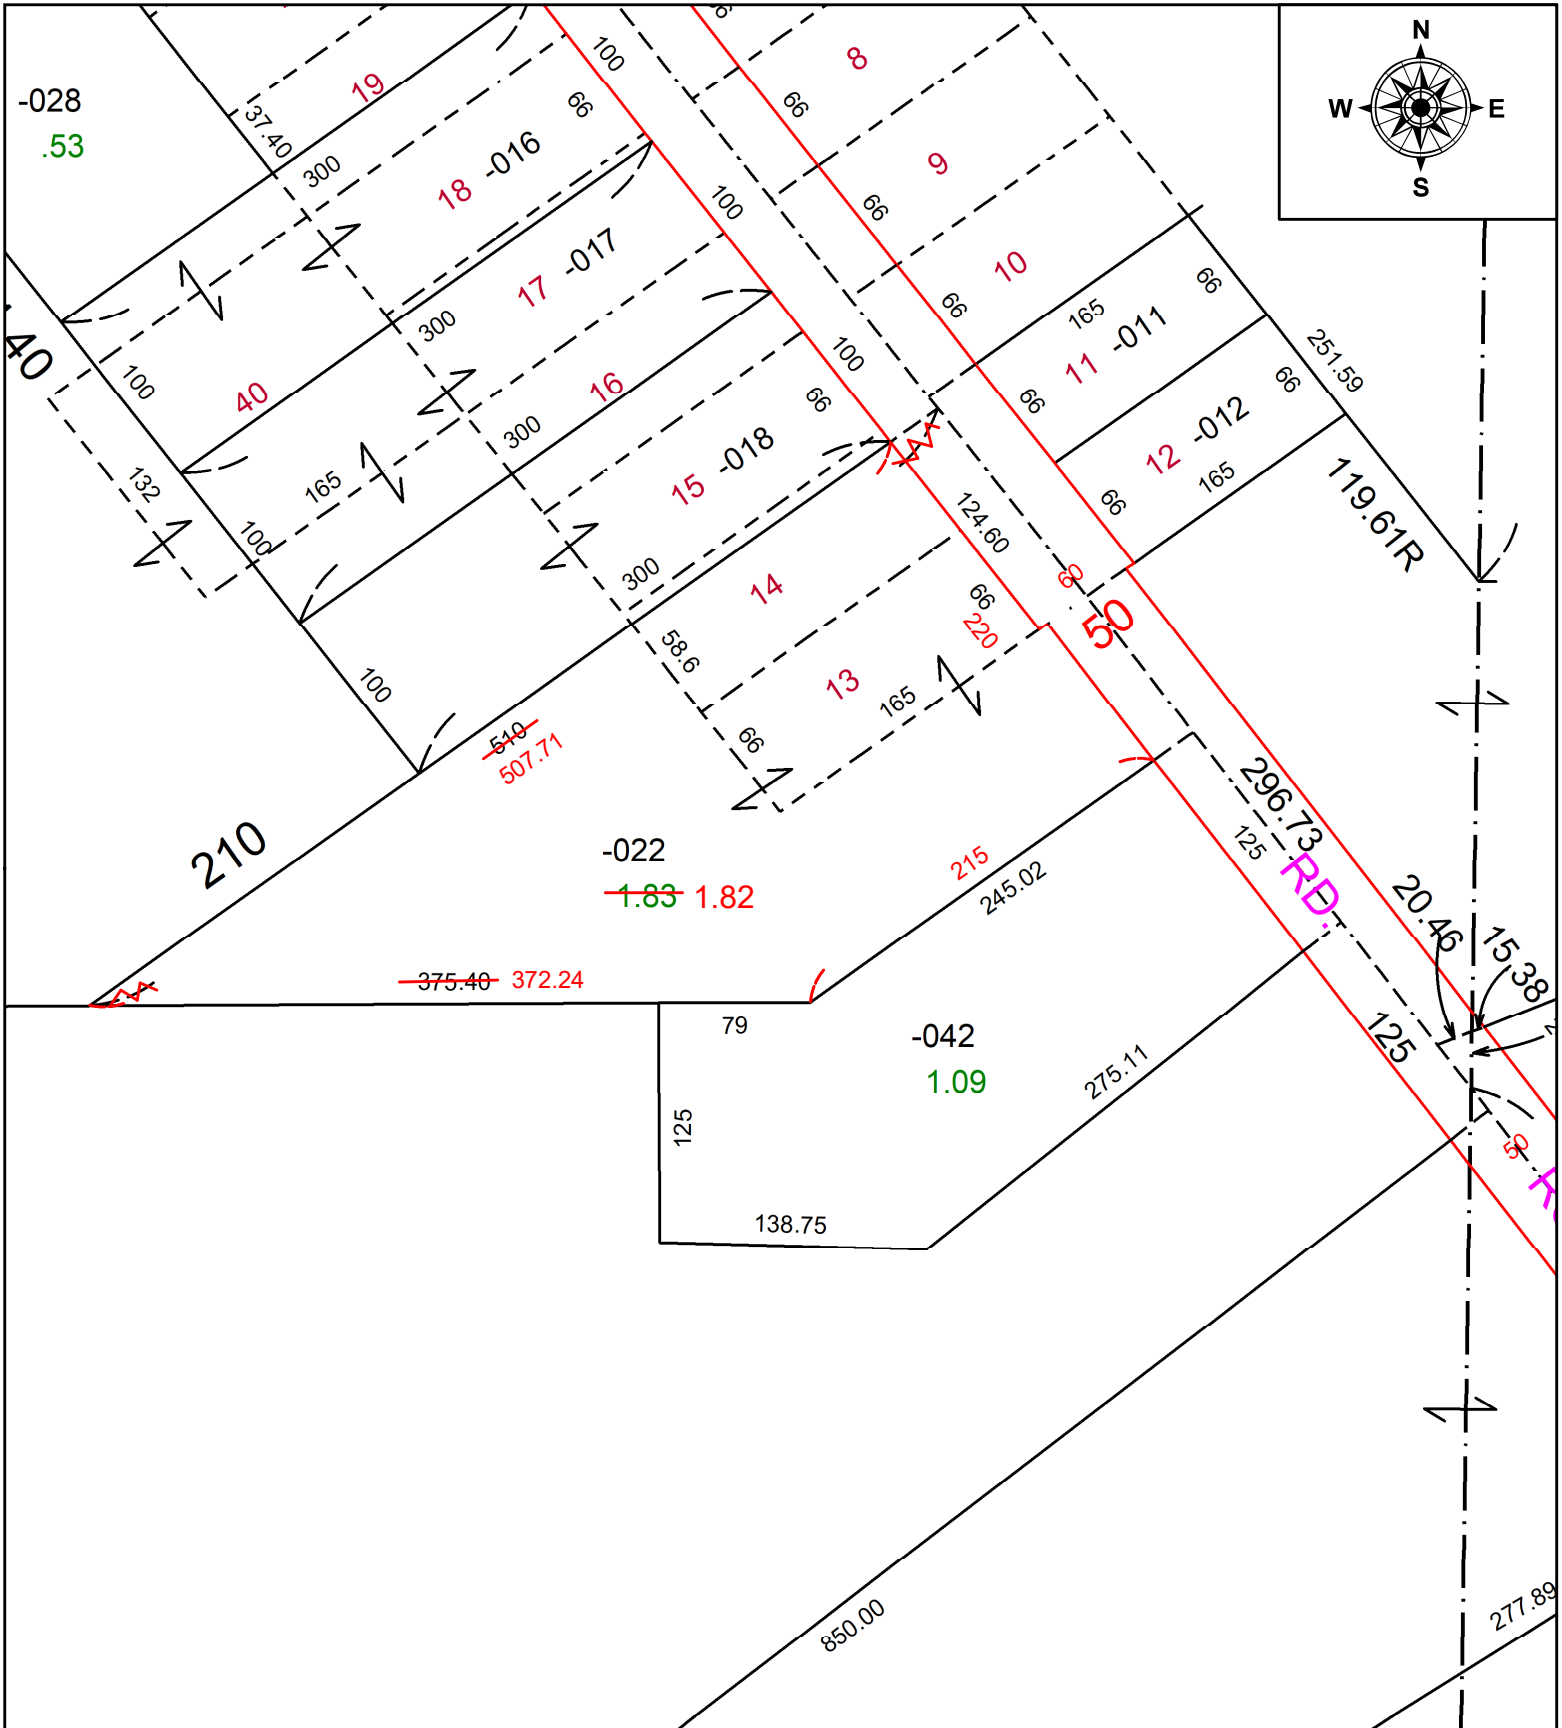

SPLITS/DEEDS PROCESSED
 LORAIN COUNTY TAX MAP DEPARTMENT
 226 MIDDLE AVE. ELYRIA, OH

SURVEYED BY: RICHARD METZKER **SURVEY #:** 50834
CLOSURE: 1:287292
MAP PAGE(S): 12-00-084
APPROVED BY: DMA **DATE:** 3/8/2023
SCALE: 1" = 100' **PRIOR INSTRUMENT:** 2022-0859432