



PARENT PARCEL: 14-00-134-000-019

CHILD PARCEL: 14-00-0134-000-021 & -022

AC CORR PER SURVEYOR THOMAS SNEZEK

STARTING POINT: NORTHWESTERLY CORNER OF O.L. 134

25-05046

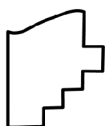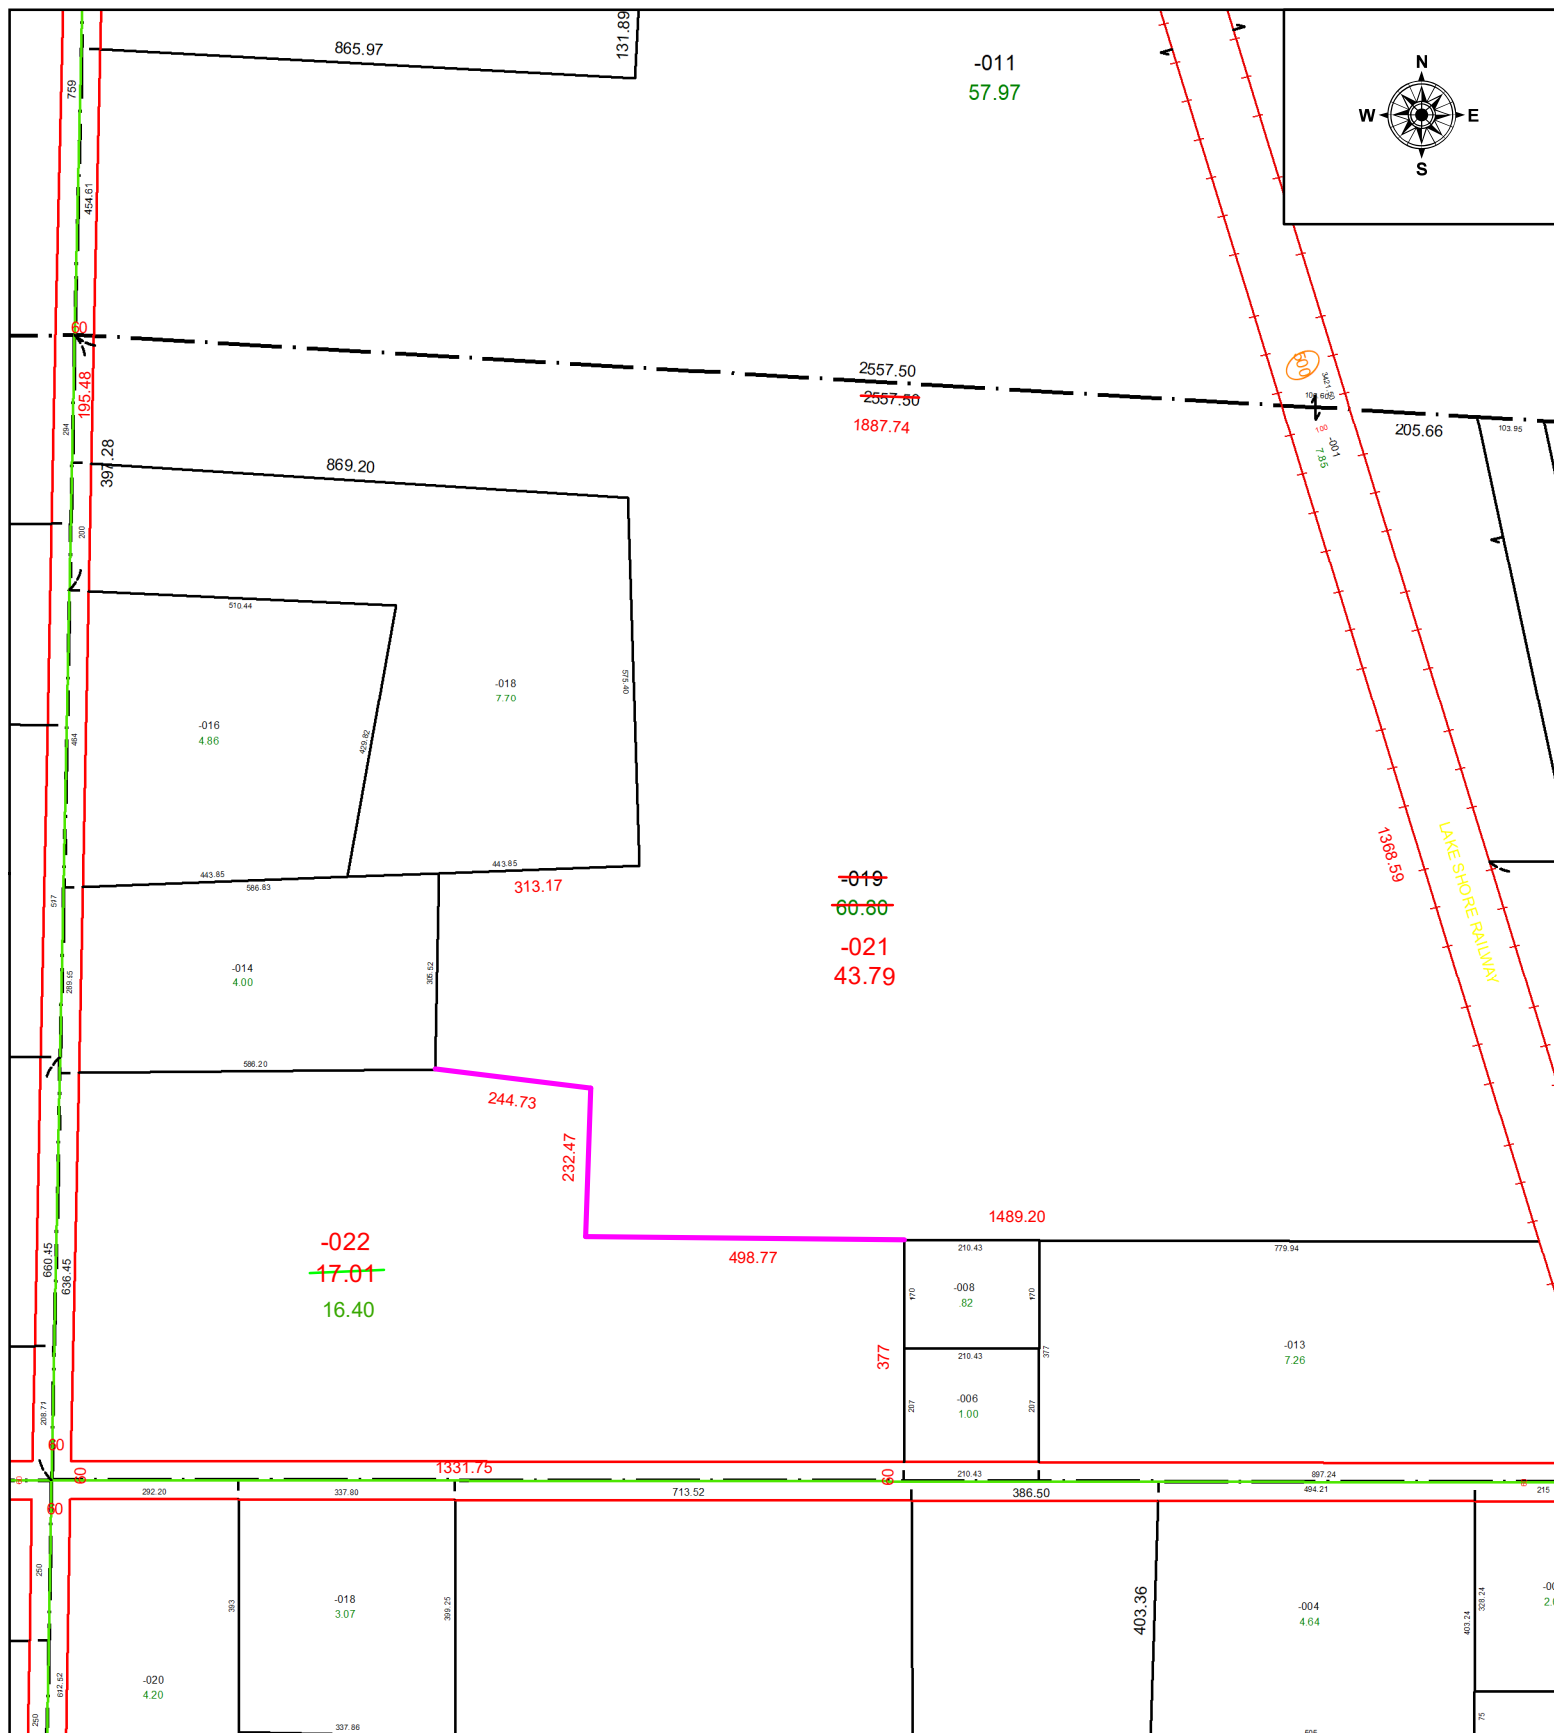

SPLITS/DEEDS PROCESSED

LORAIN COUNTY TAX MAP DEPARTMENT
226 MIDDLE AVE. ELYRIA, OH

SURVEYED BY: THOMAS SNEZEK

SURVEY # 51513

CLOSURE: 1: 868531

MAP PAGE(S): 14-00-134

APPROVED BY: WRZ **DATE:** 8/8/2025

SCALE: 1" = 300 **PRIOR INSTRUMENT:** DV 1348/339