

PARENT PARCEL:

06-22-006-102-036 & -038 & -046



CHILD PARCEL:

06-22-006-102-170 & -171 & 172

STARTING POINT:

INTERSECTION SOUTHERNLY LOT 6 AND C/L FORD RD

25-05051

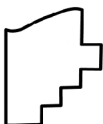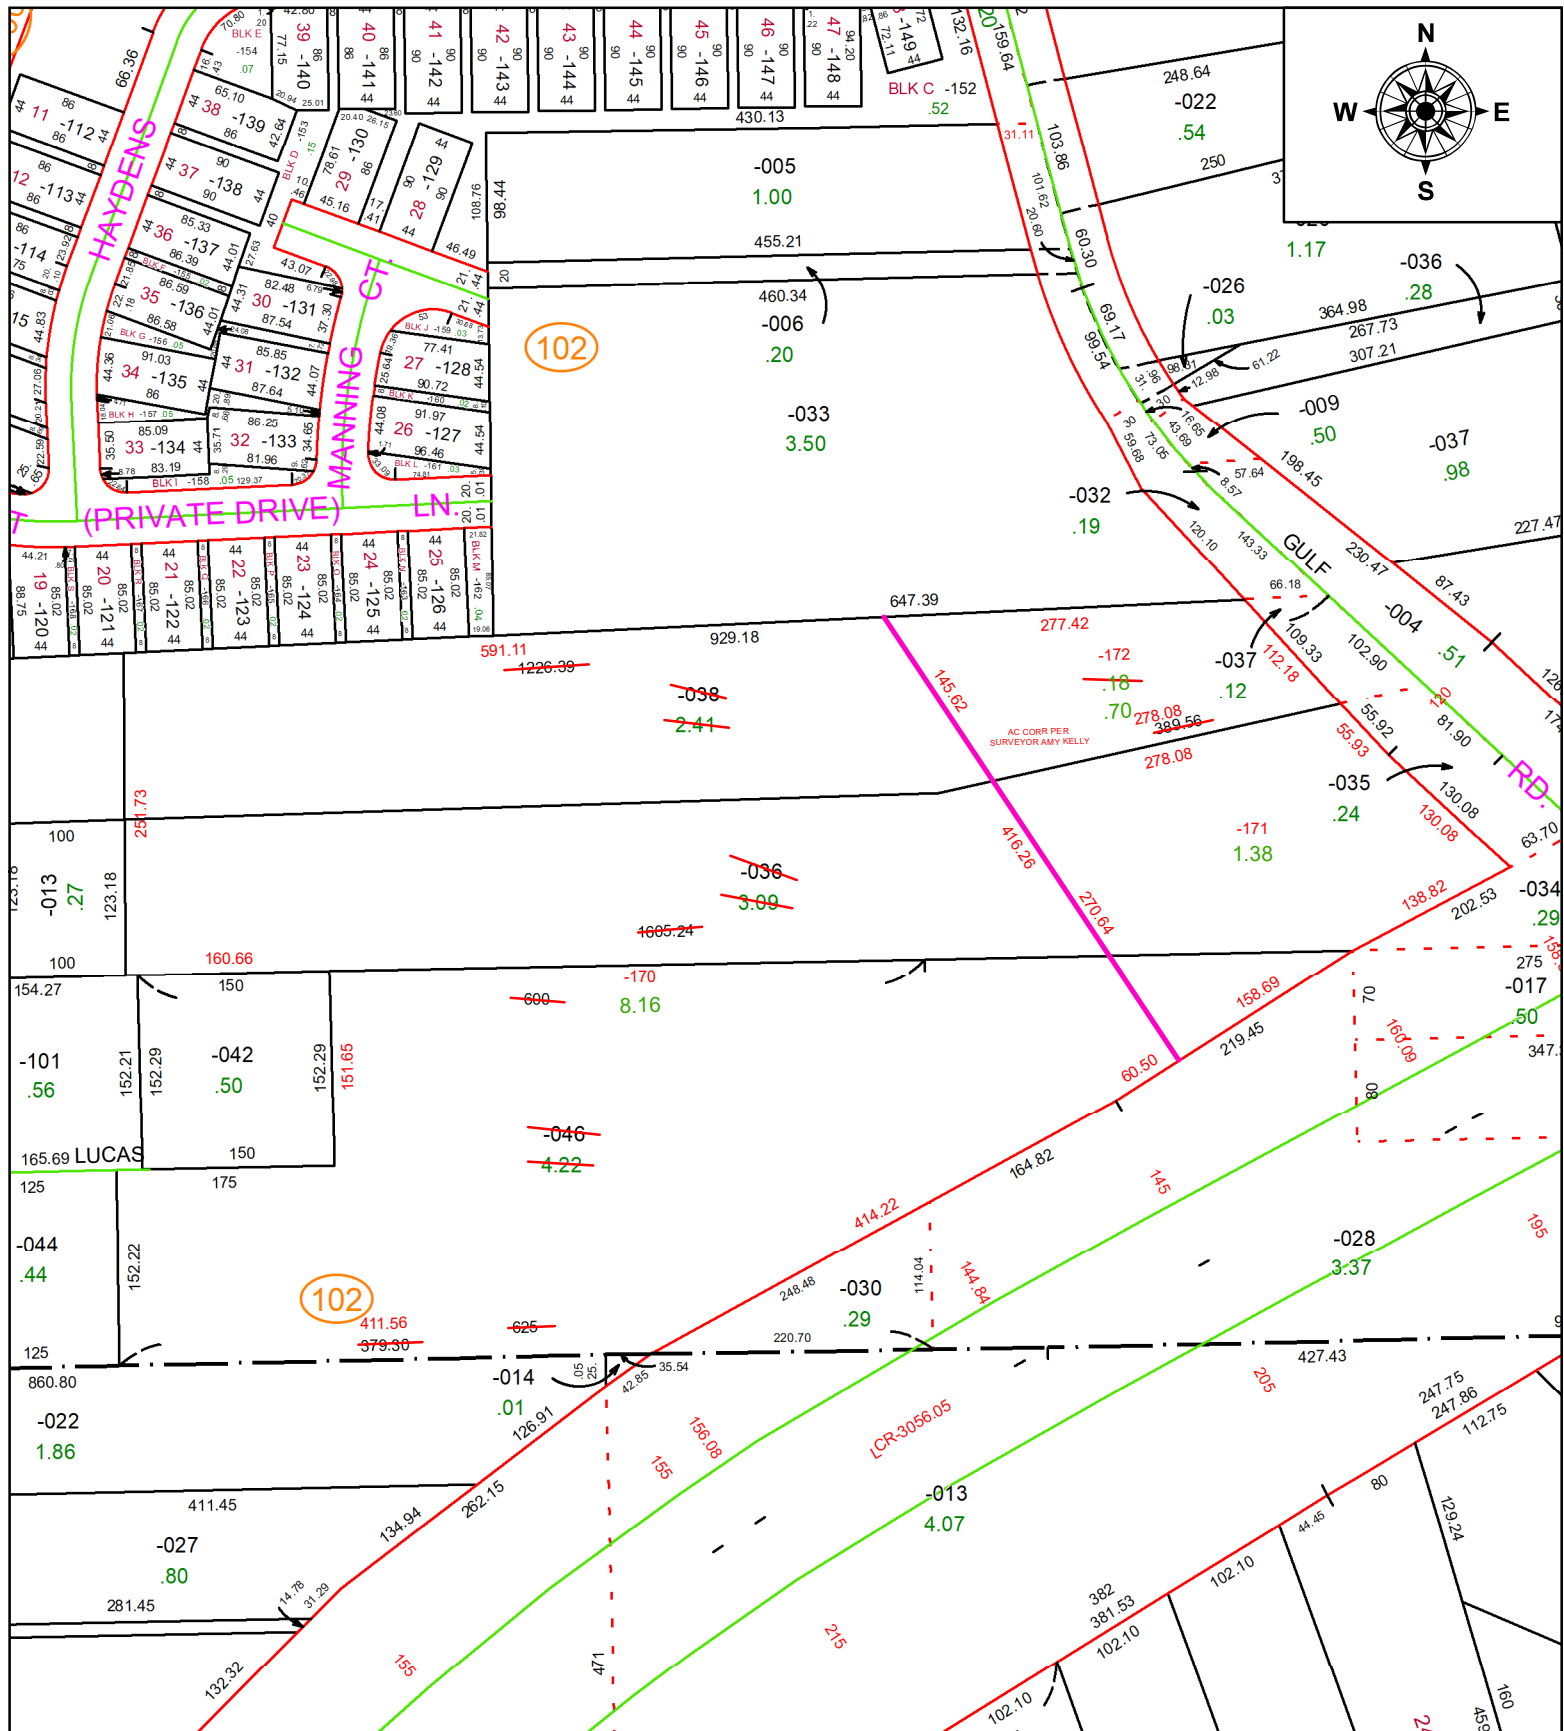

SPLITS/DEEDS PROCESSED

LORAIN COUNTY TAX MAP DEPARTMENT
226 MIDDLE AVE. ELYRIA, OH

SURVEYED BY: AMY M. KELLY

SURVEY #: 51523

CLOSURE: 1: 701032

MAP PAGE(S): 06-22-006

APPROVED BY: BB DATE: 8/19/2025

SCALE: 1" = 150' PRIOR INSTRUMENT: #20170622481