
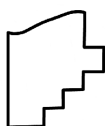


STARTING POINT: AC CORR PER SURV BY WILFREDO BARBOSA C/L OF LAW AND VERMONT ST

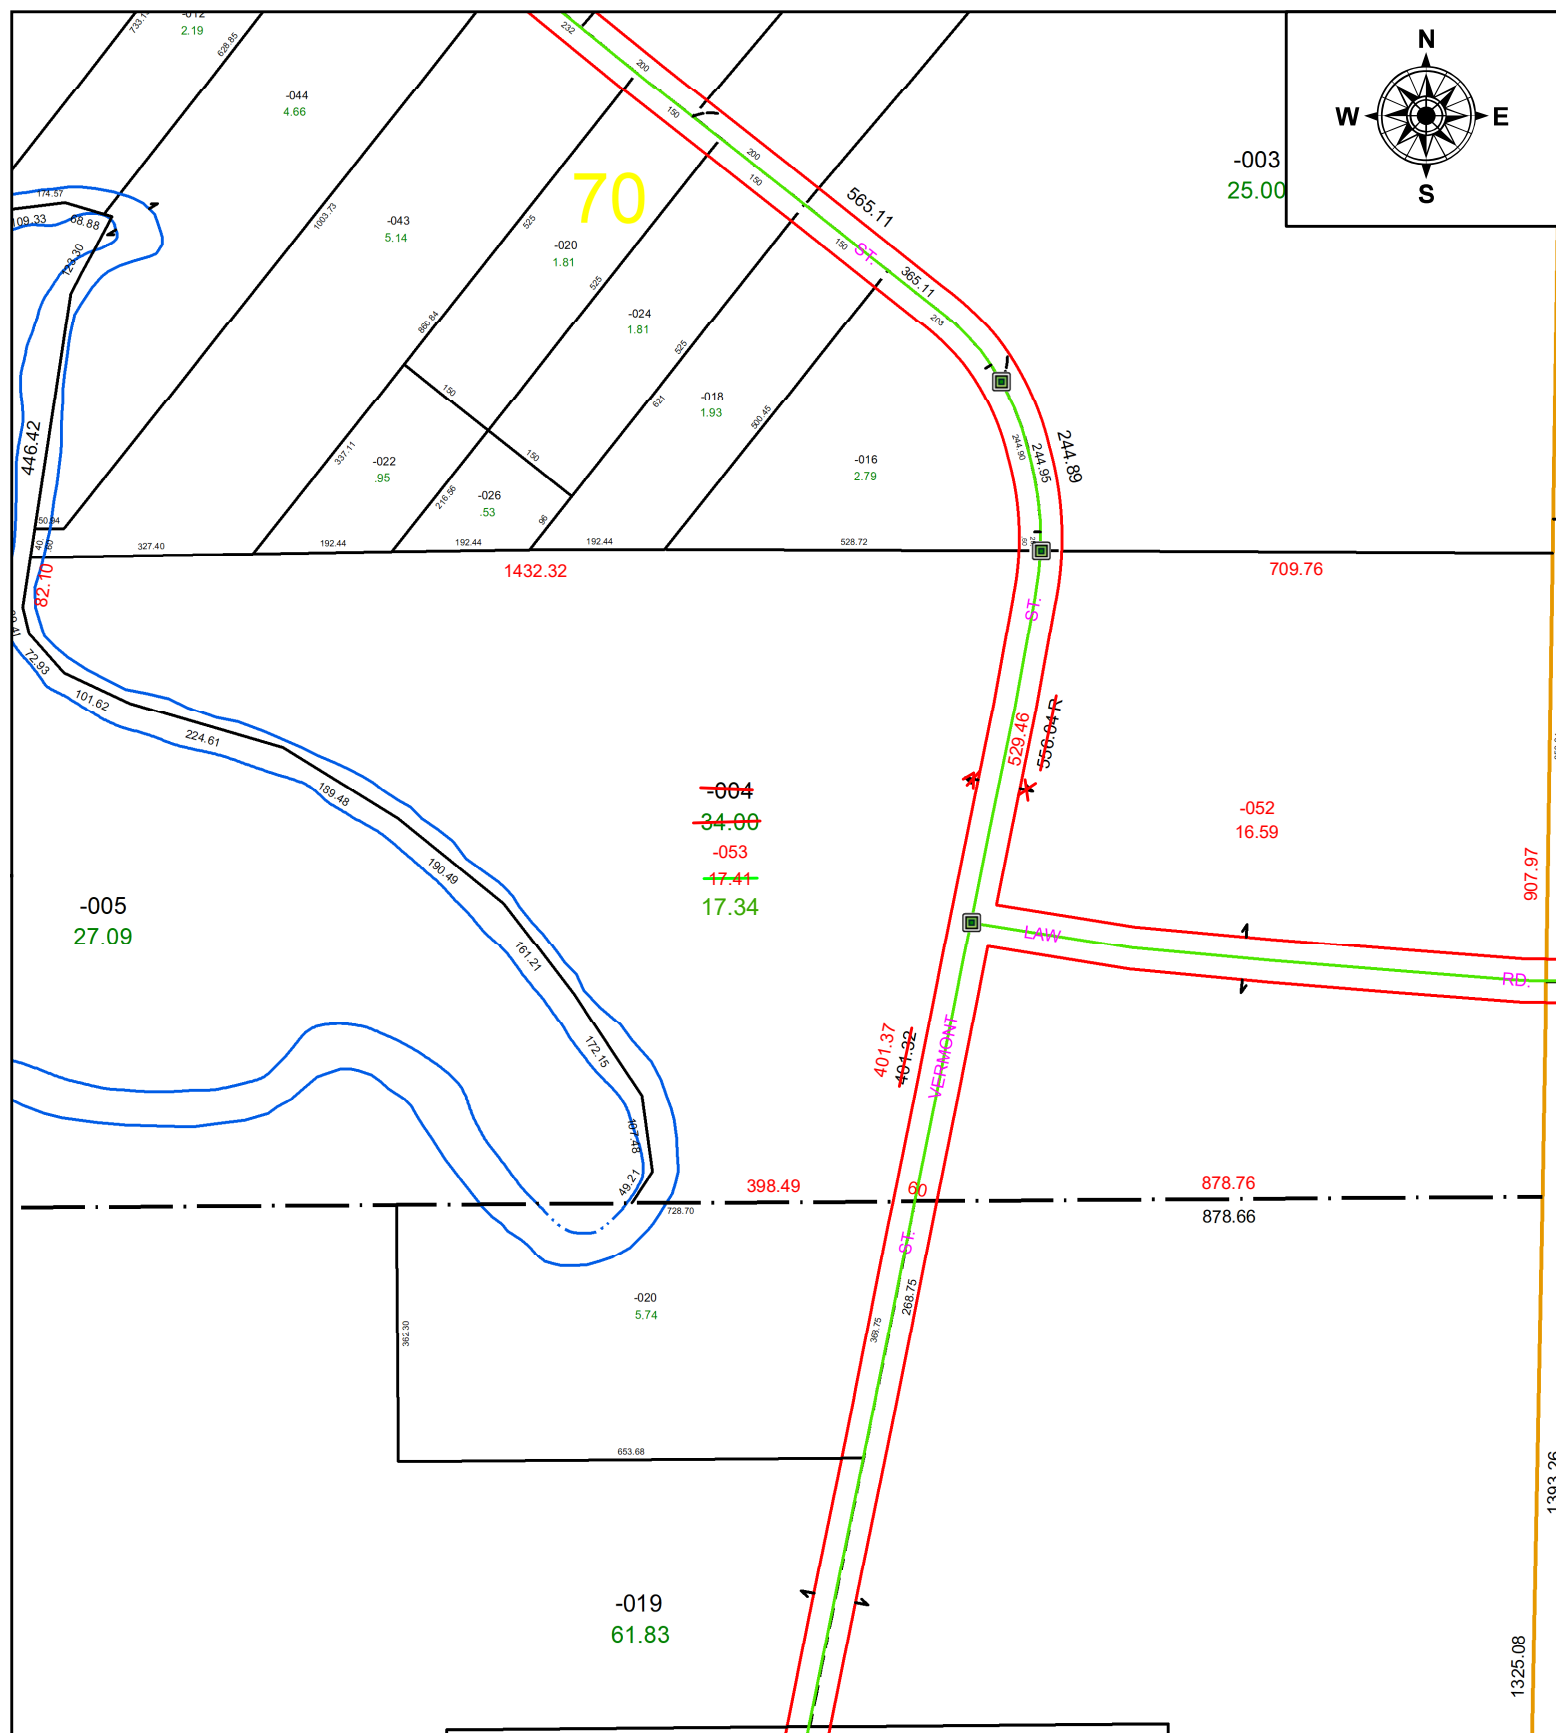

LORAIN COUNTY TAX MAP DEPARTMENT
226 MIDDLE AVE. ELYRIA, OH

SCALE: 1 in = 270 ft **PRIOR INSTRUMENT:** 1995- 0369176